


POOR ORIGINAL COPY


INDEX EXPLANATION
175-50-177-25

179-00

PLAN	DATE	BY

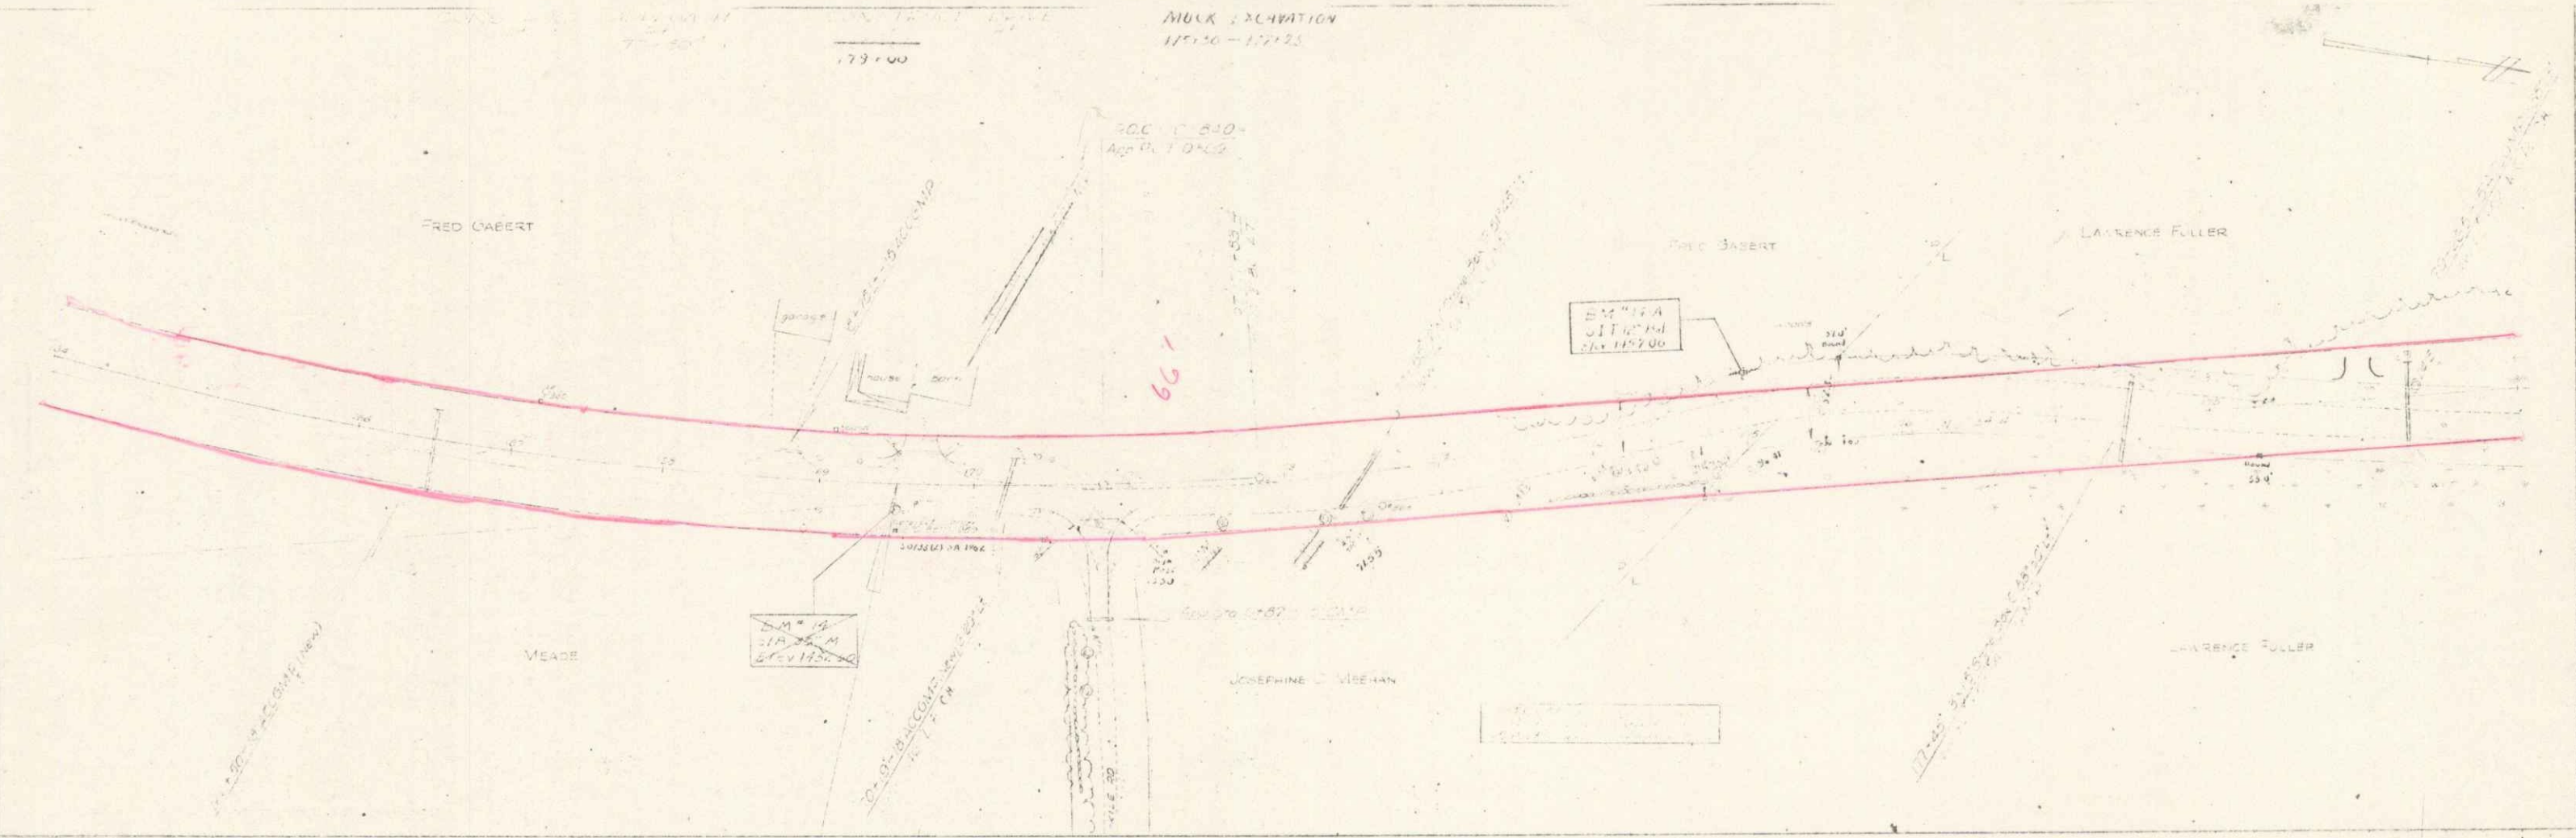

PLAN	DATE	BY

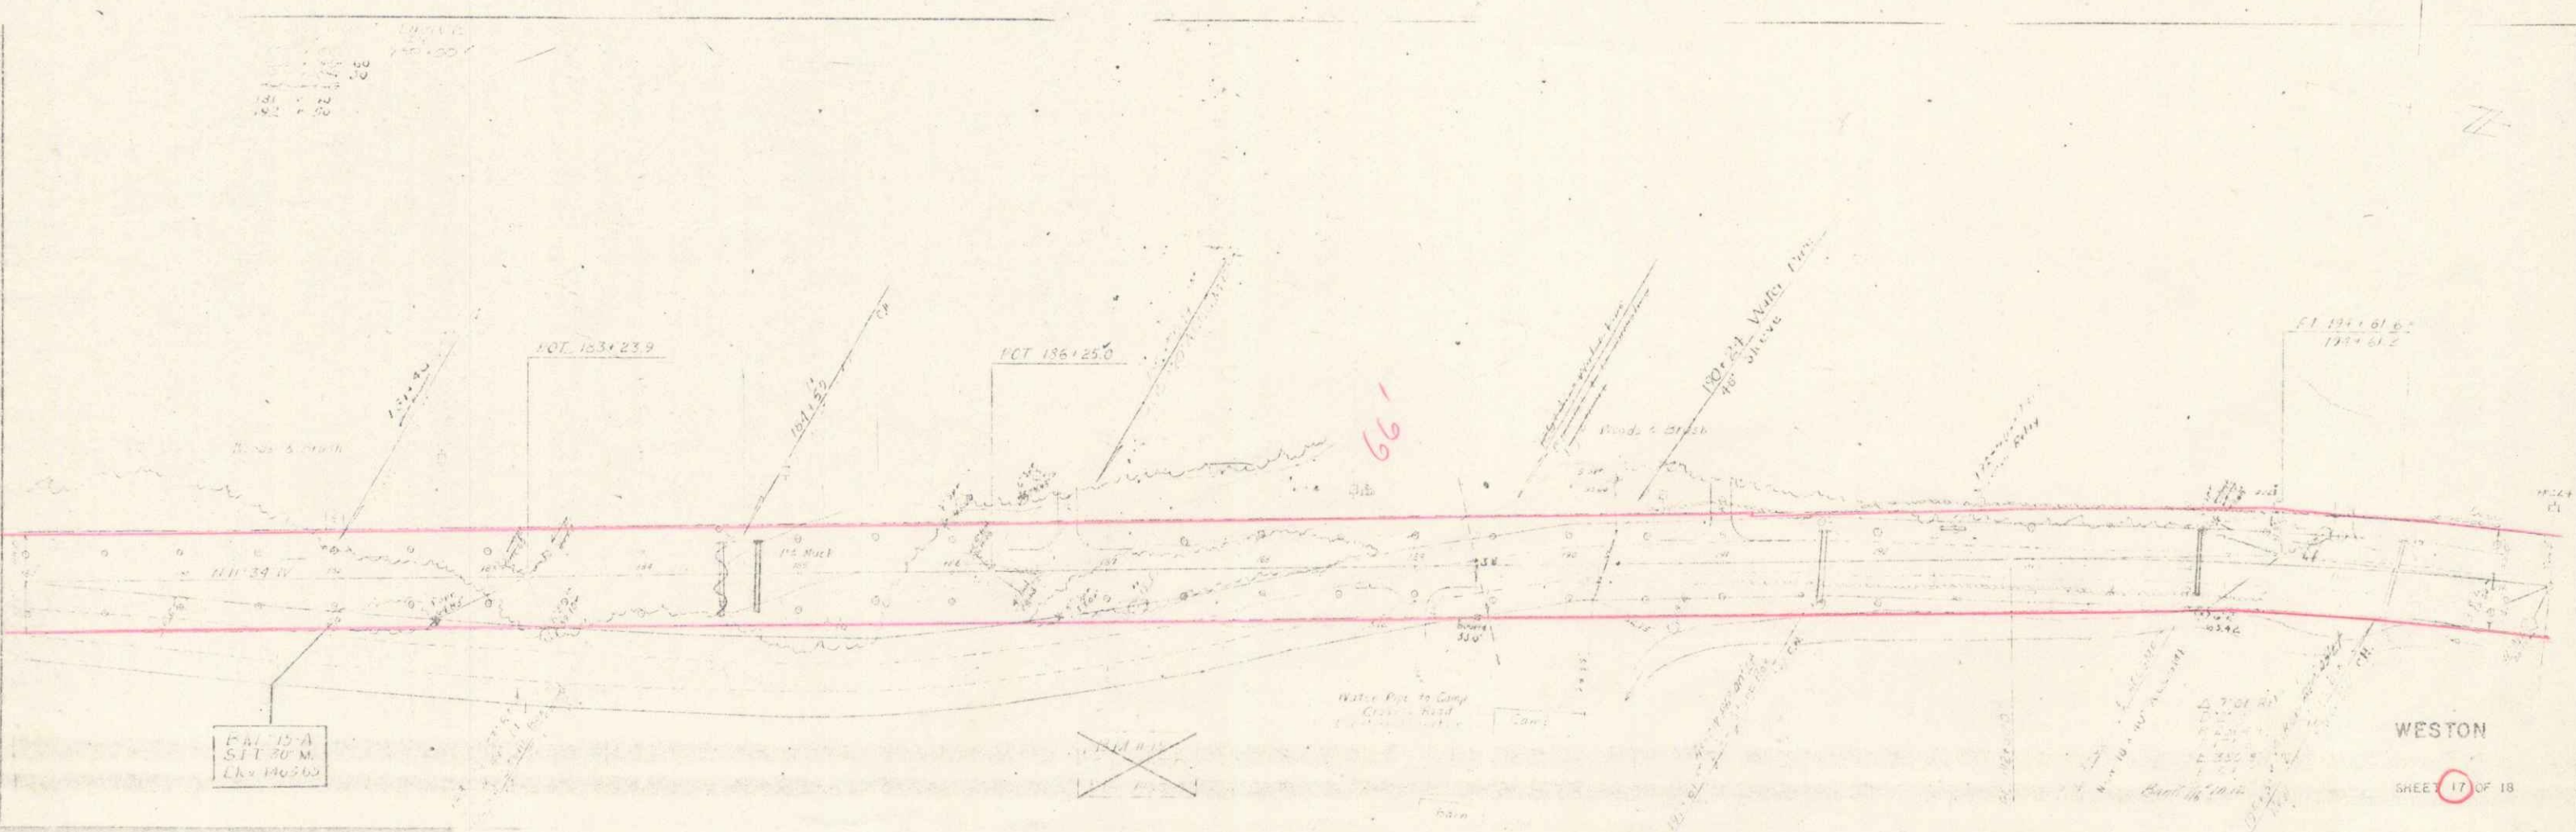

WESTON
SHEET 17 OF 18