
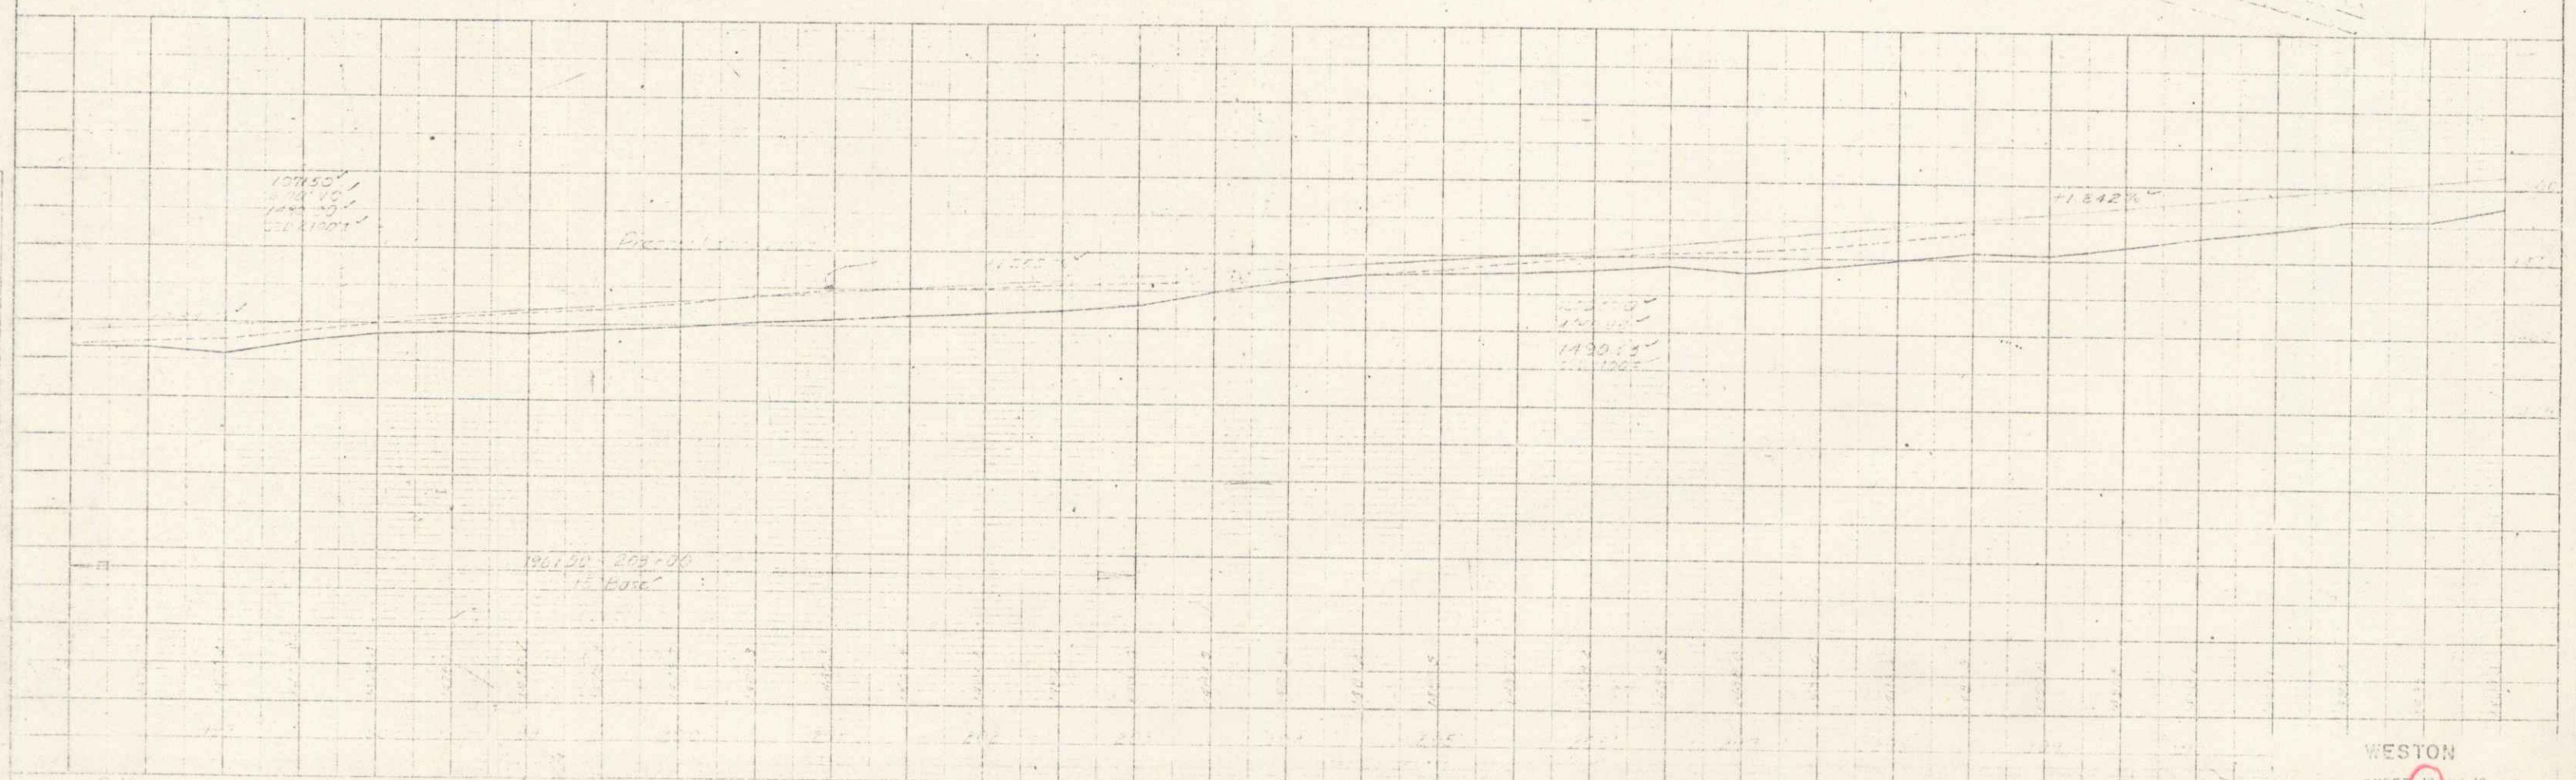


POOR ORIGINAL COPY

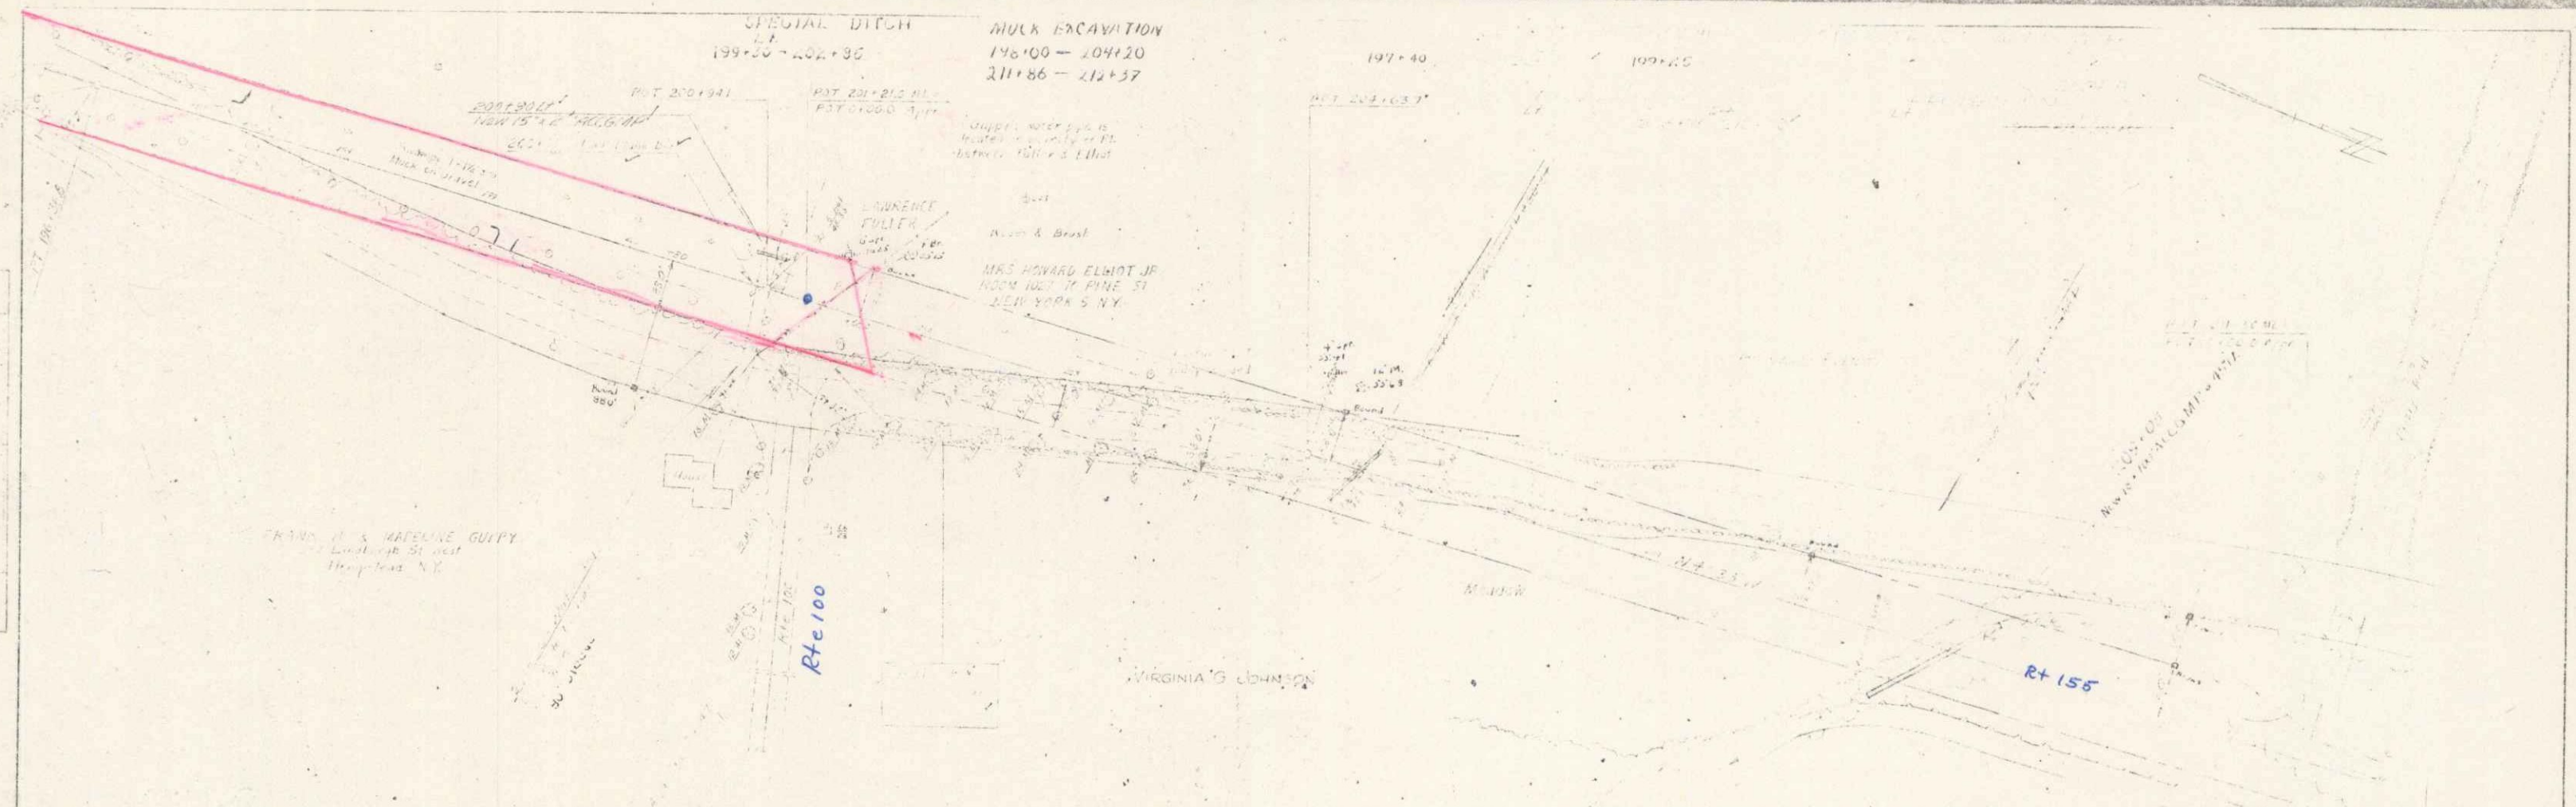

PLAN	DATE	BY	CHECKED

PROFILE	DATE	BY	CHECKED

WESTON
SHEET 18 OF 18