
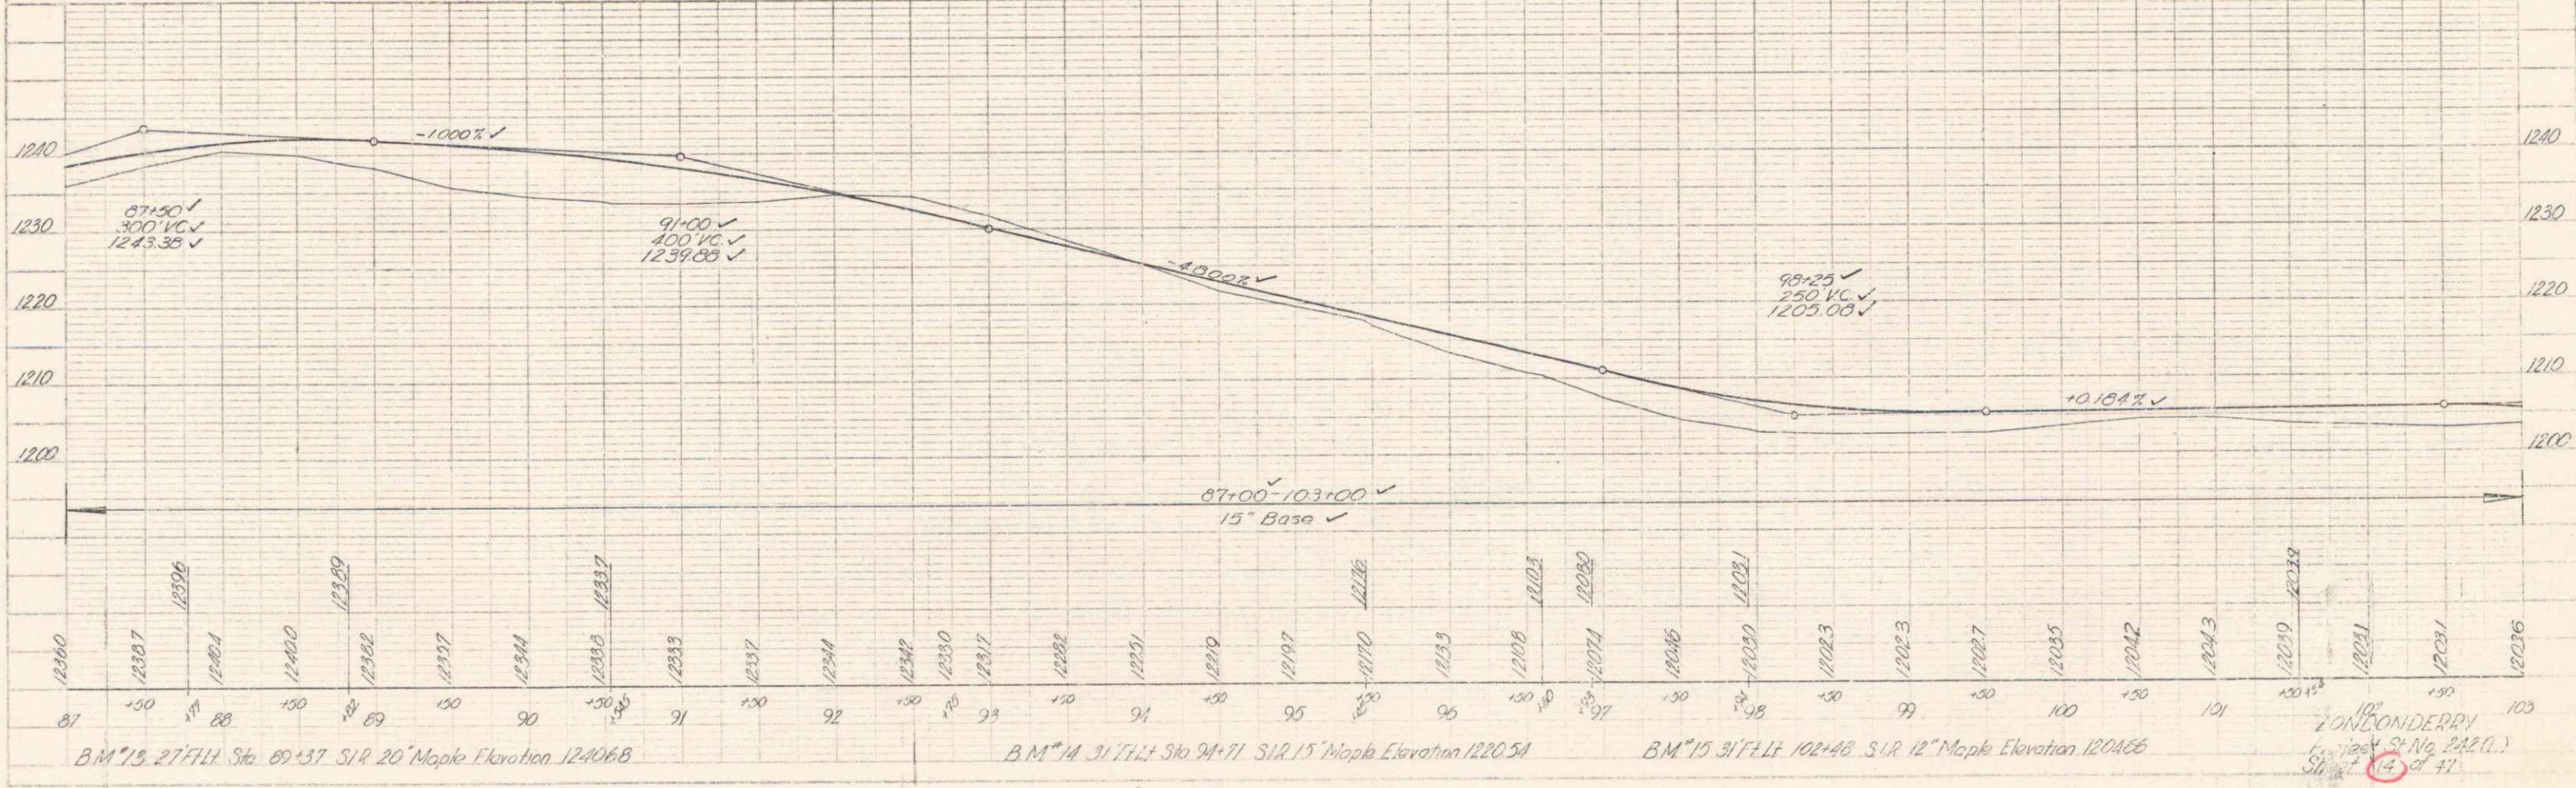


PLAN
DATE
BY
SCALE
1" = 40'

PROFILE
DATE
BY
SCALE
1" = 4'

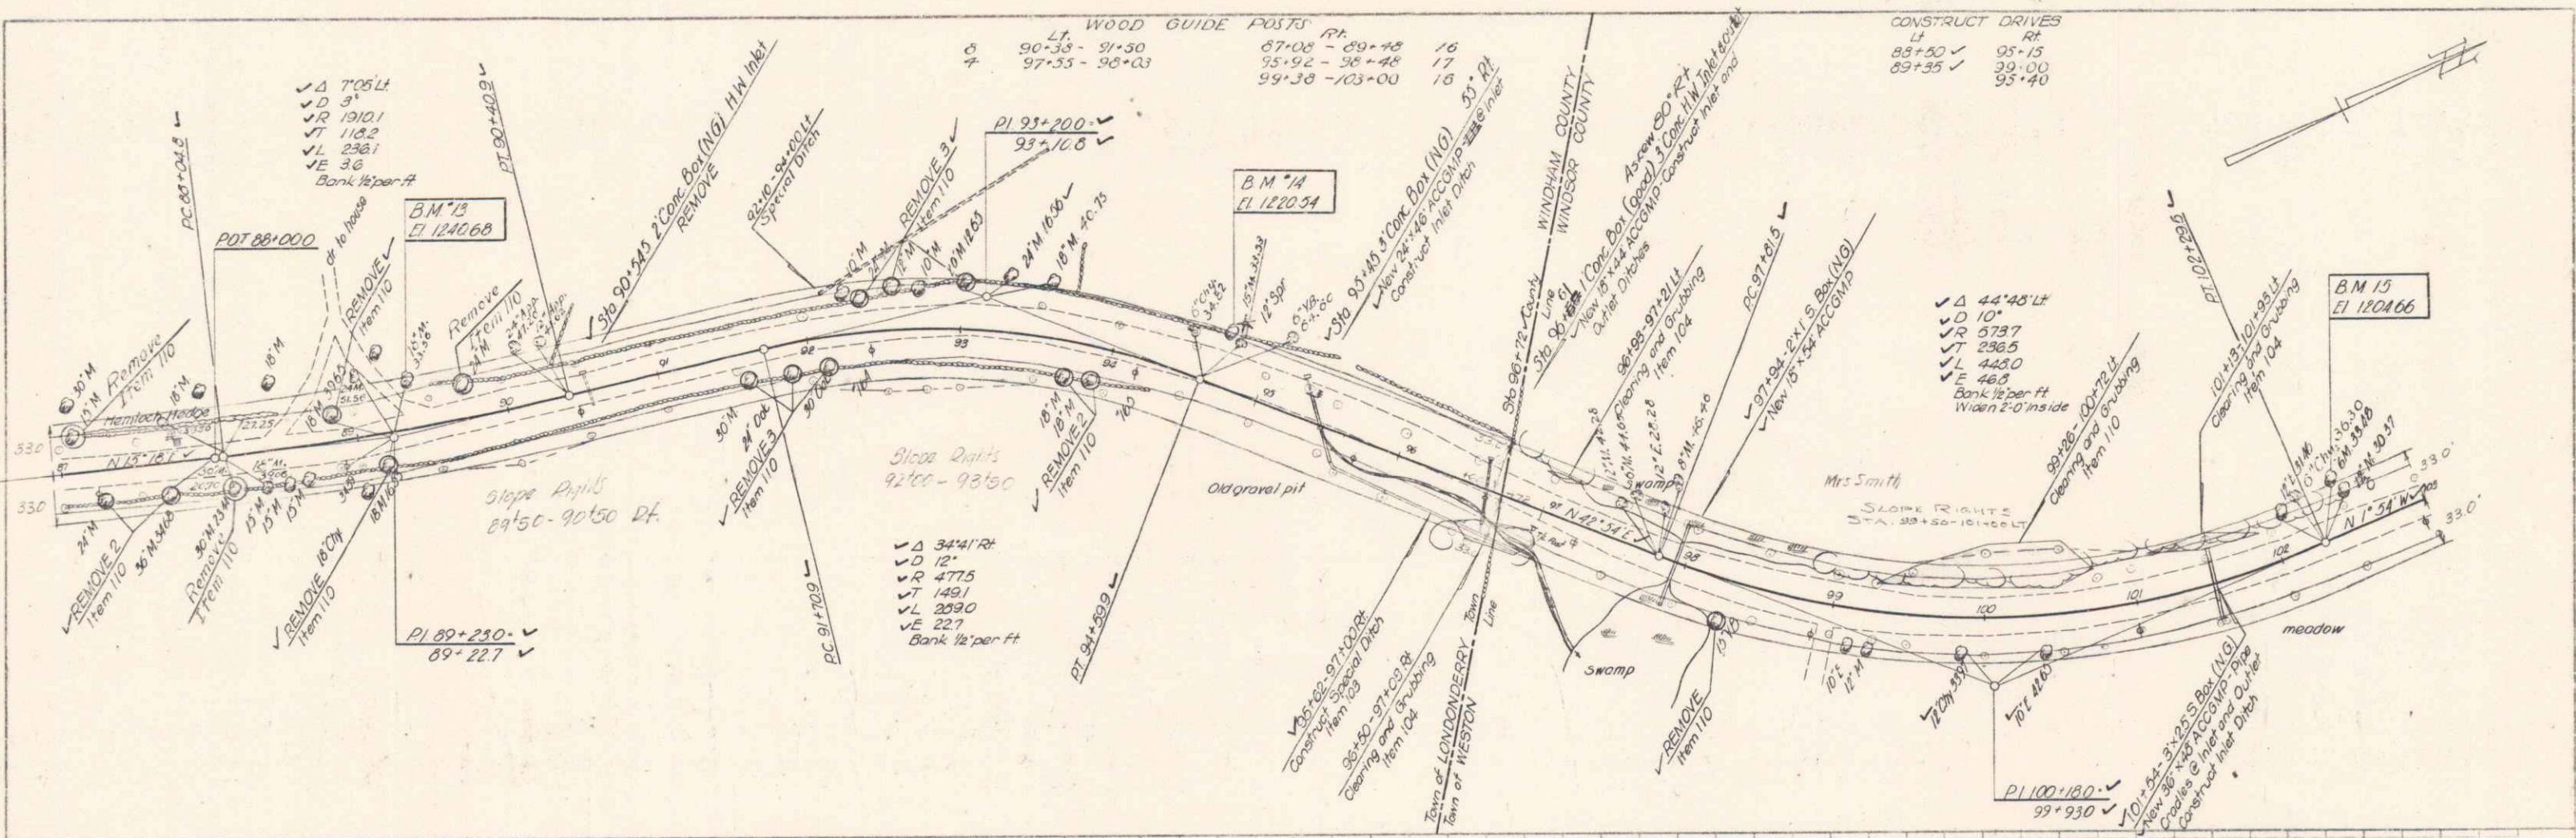

B.M. 13 27' Ht. Sta. 89+37 S.R. 20' Maple Elevation 124068

B.M. 14 31' Ht. Sta. 94+71 S.R. 15' Maple Elevation 122054

B.M. 15 31' Ht. Sta. 102+48 S.R. 12' Maple Elevation 120466

LONDON DERRY
Sh. No. 242 (L.)
Sheet 14 of 47