
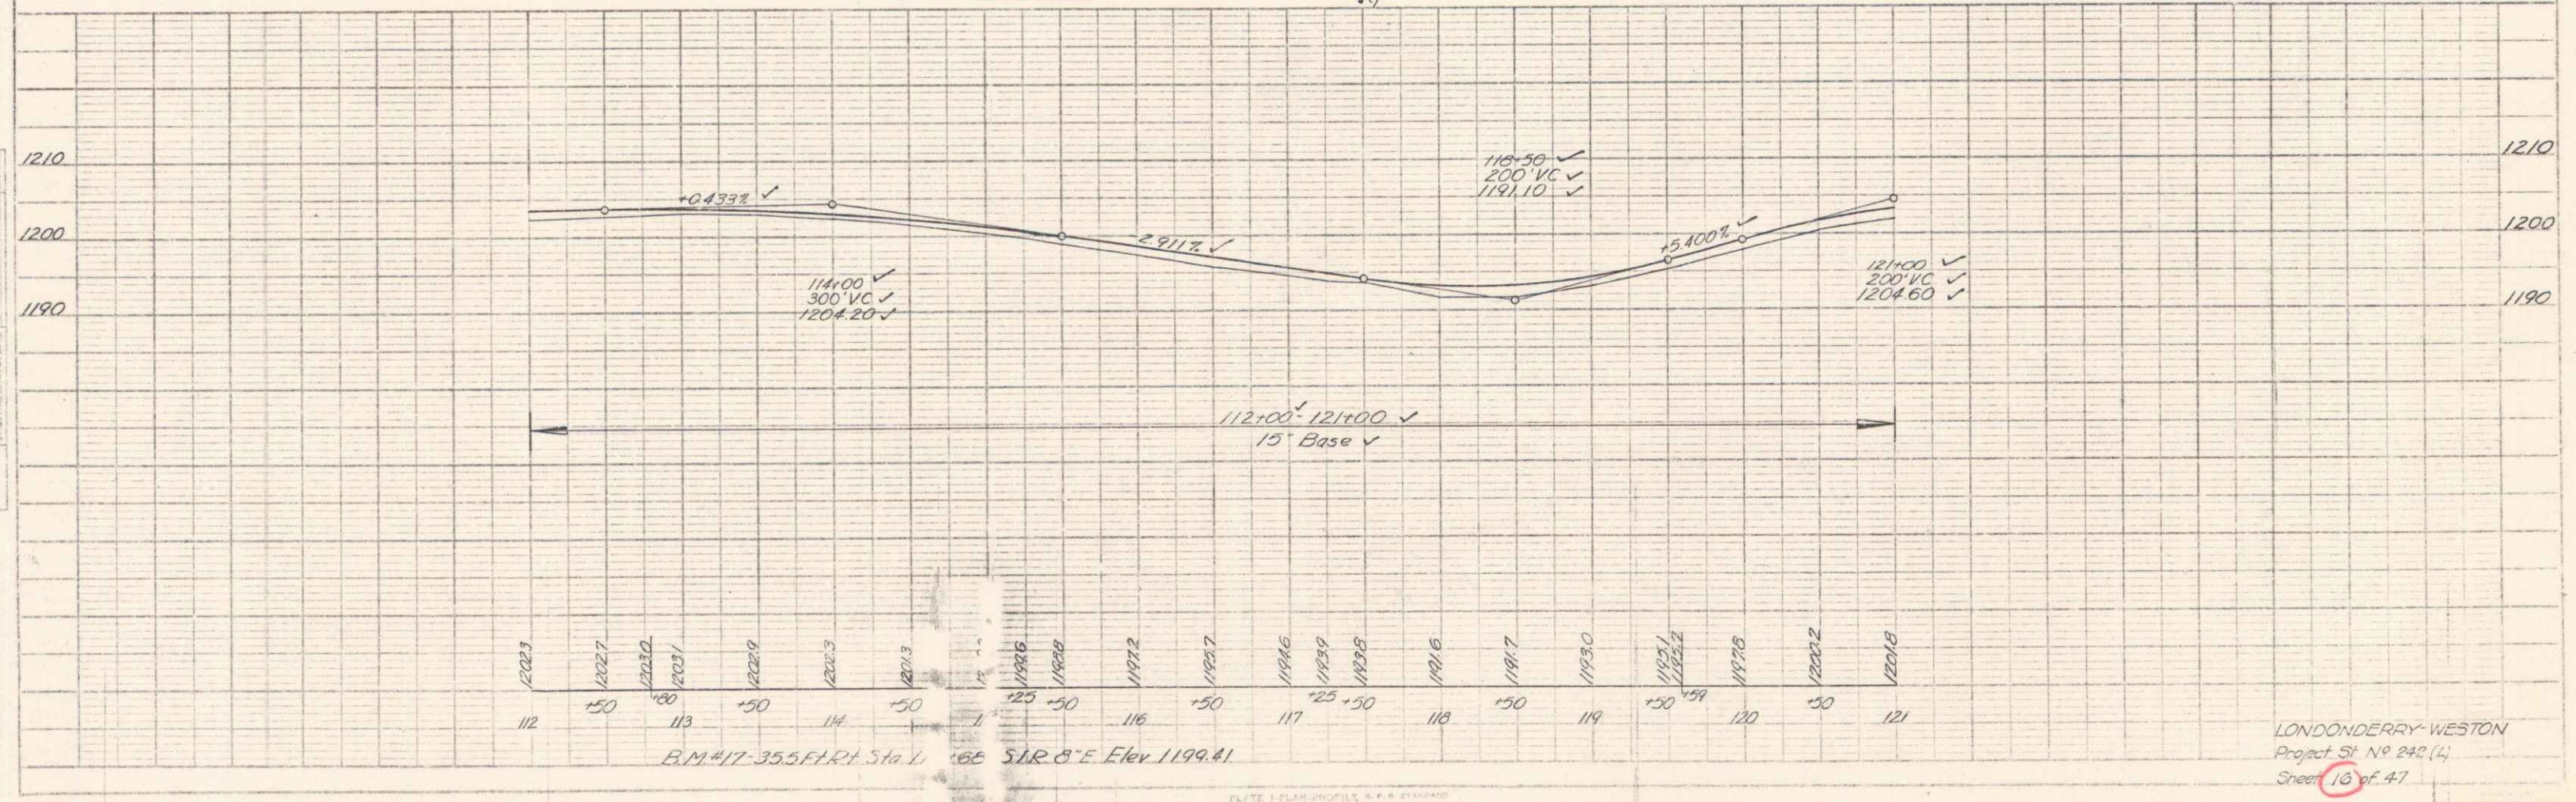


WOOD GUIDE POSTS RT
 5 117+98 - 118+62
 4 119+10 - 119+58

CONSTRUCT APPROACH RT
 LT 114+50
 CONSTRUCT DRIVES
 RT 115+35 ✓
 LT 118+92 ✓
 RT 120+50 ✓
 LT 119+12 ✓

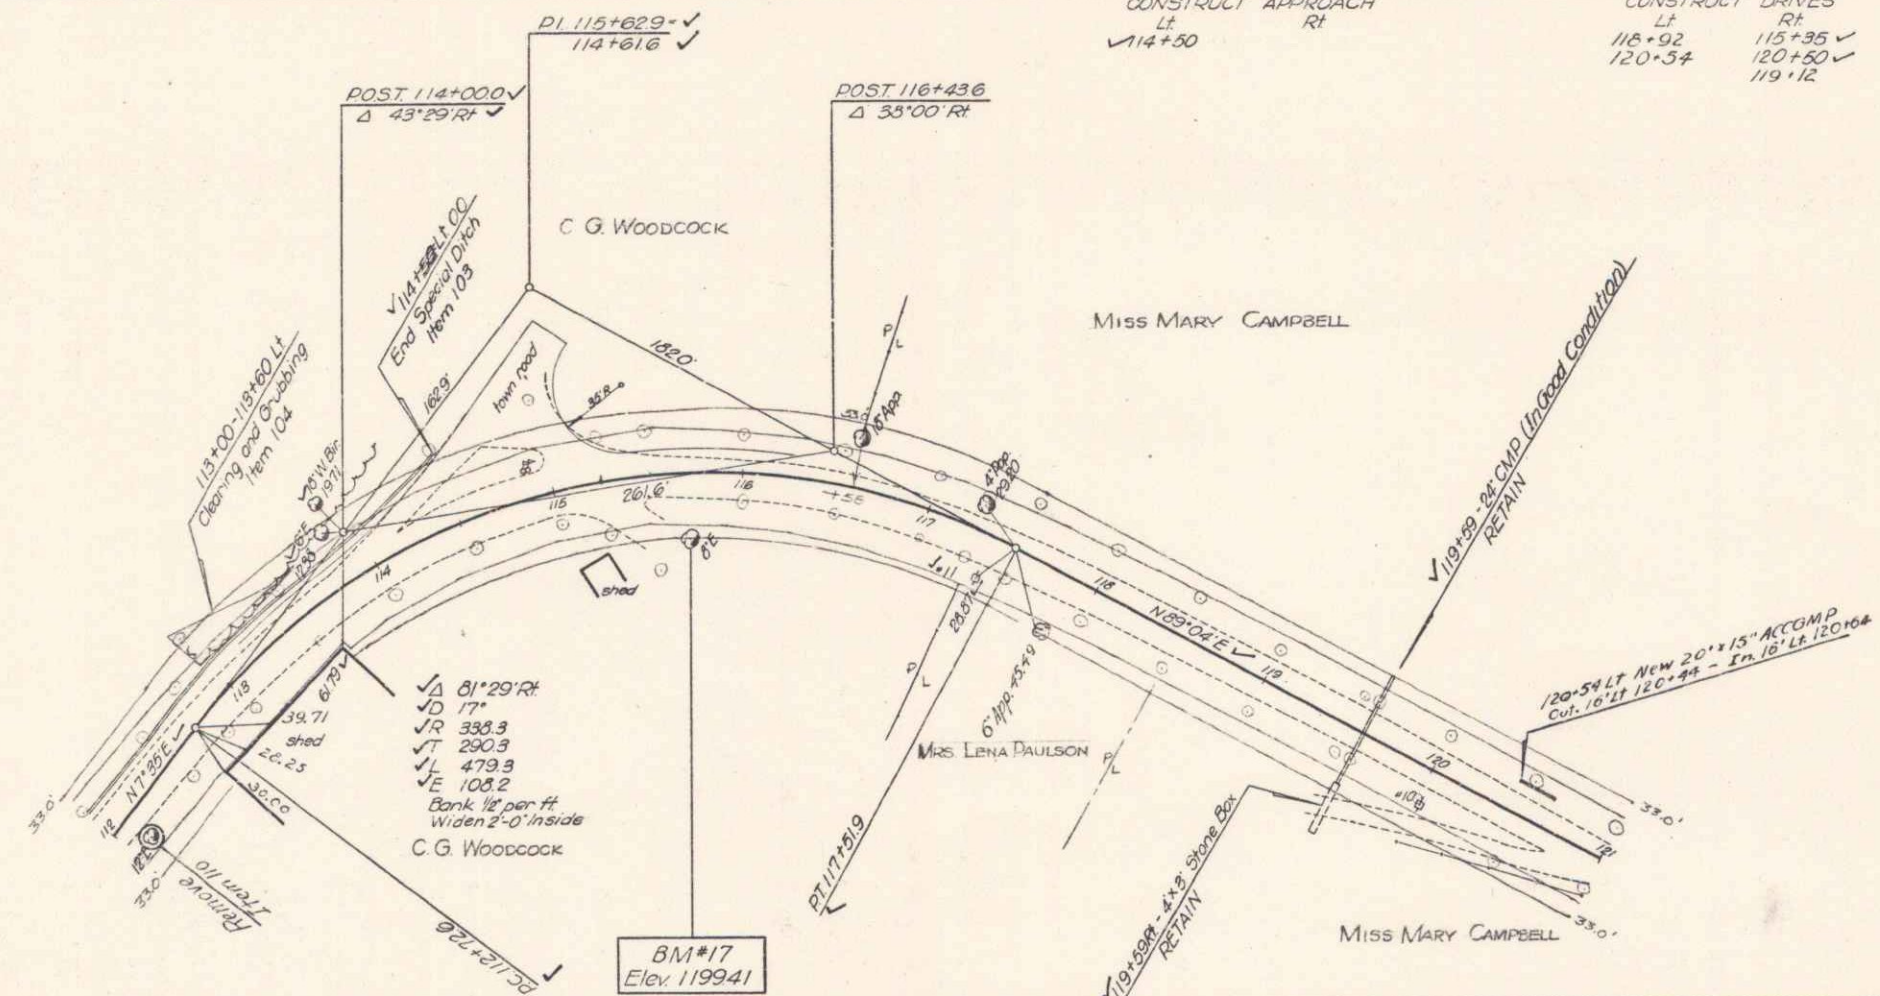

PLAN
 DATE 12-29-24
 DRAWN BY M. J. MURPHY
 CHECKED BY J. J. MURPHY

PROFILE
 DATE 12-29-24
 DRAWN BY G. A. AG
 CHECKED BY G. A. AG

LONDONDERRY-WESTON
 Project No. 242 (4)
 Sheet 18 of 47