
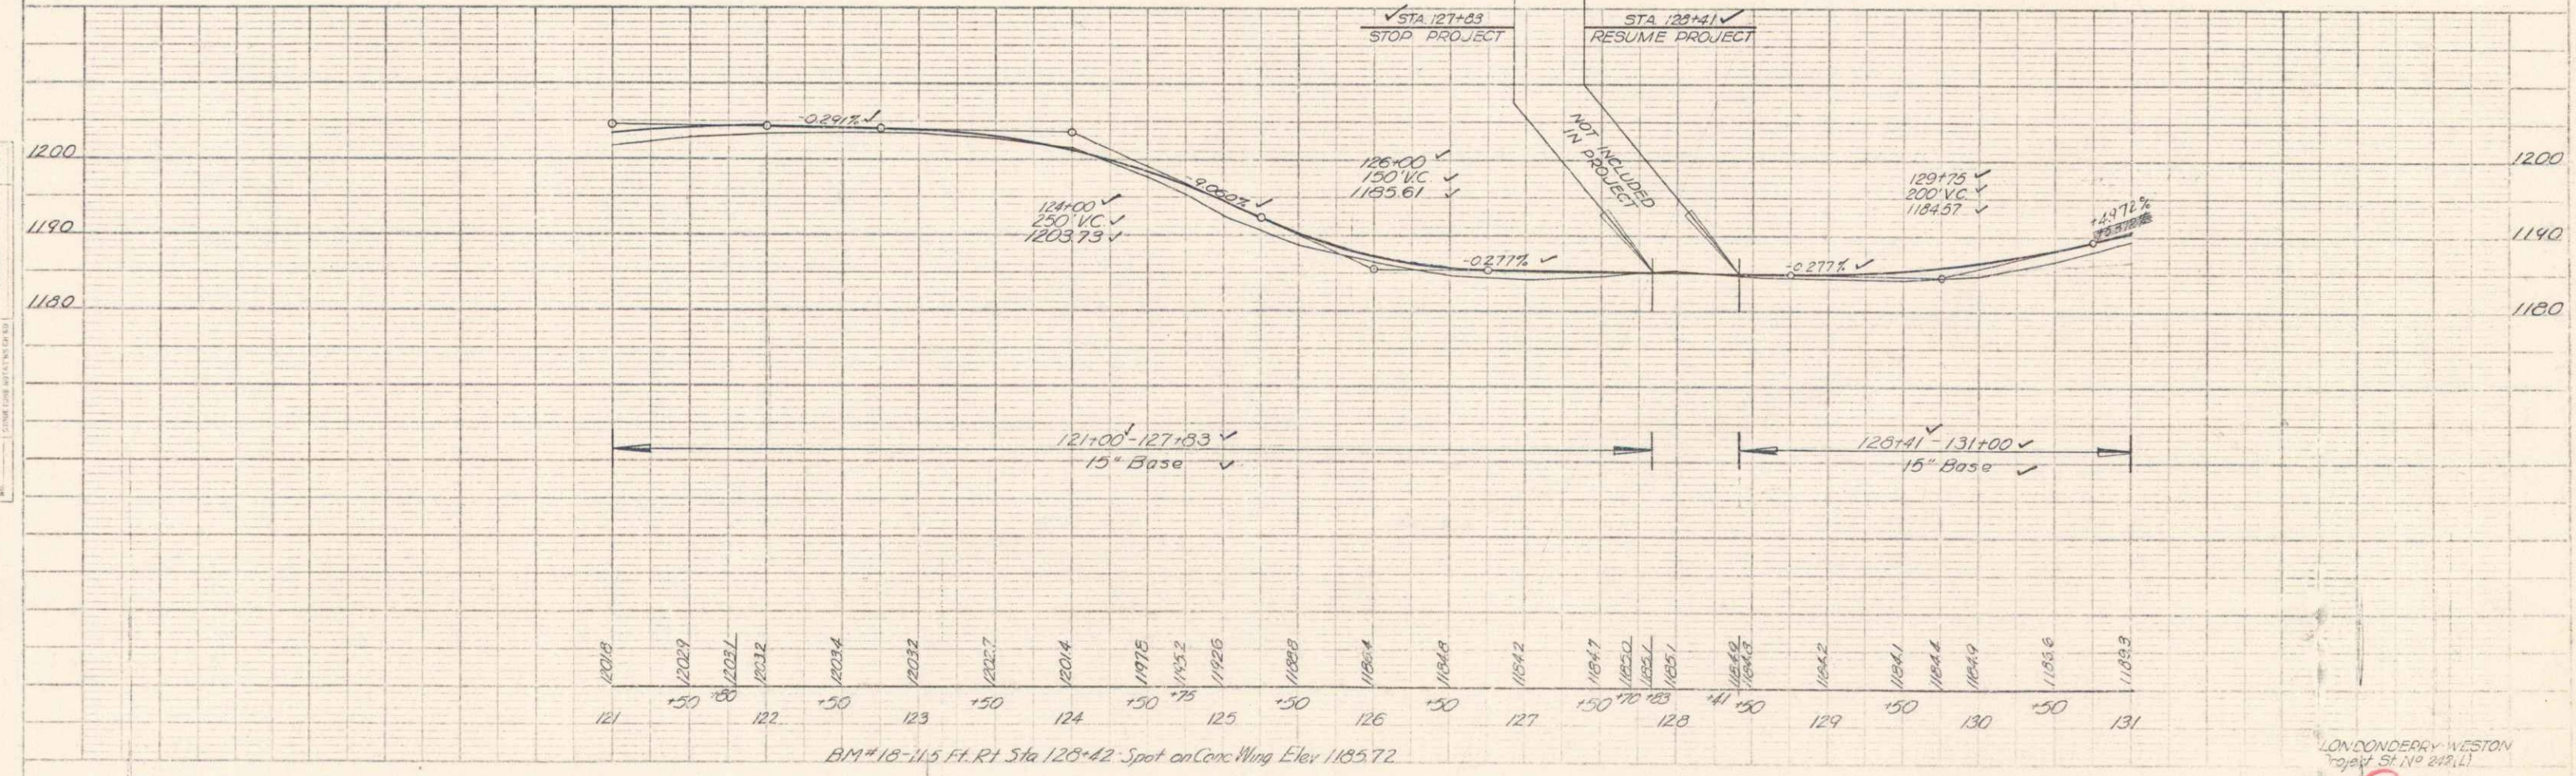


WOOD GUIDE POSTS  
 9 124+82-126+10

CONSTRUCT DRIVES  
 121+80 ✓ 121+80 ✓  
 129+76 ✓ 129+76 ✓  
 126+38 122+38  
 122+96  
 123+93

TWO CABLE GUARD RAIL  
 126+46-129+27 127+00-129+18  
 129+90-131+00

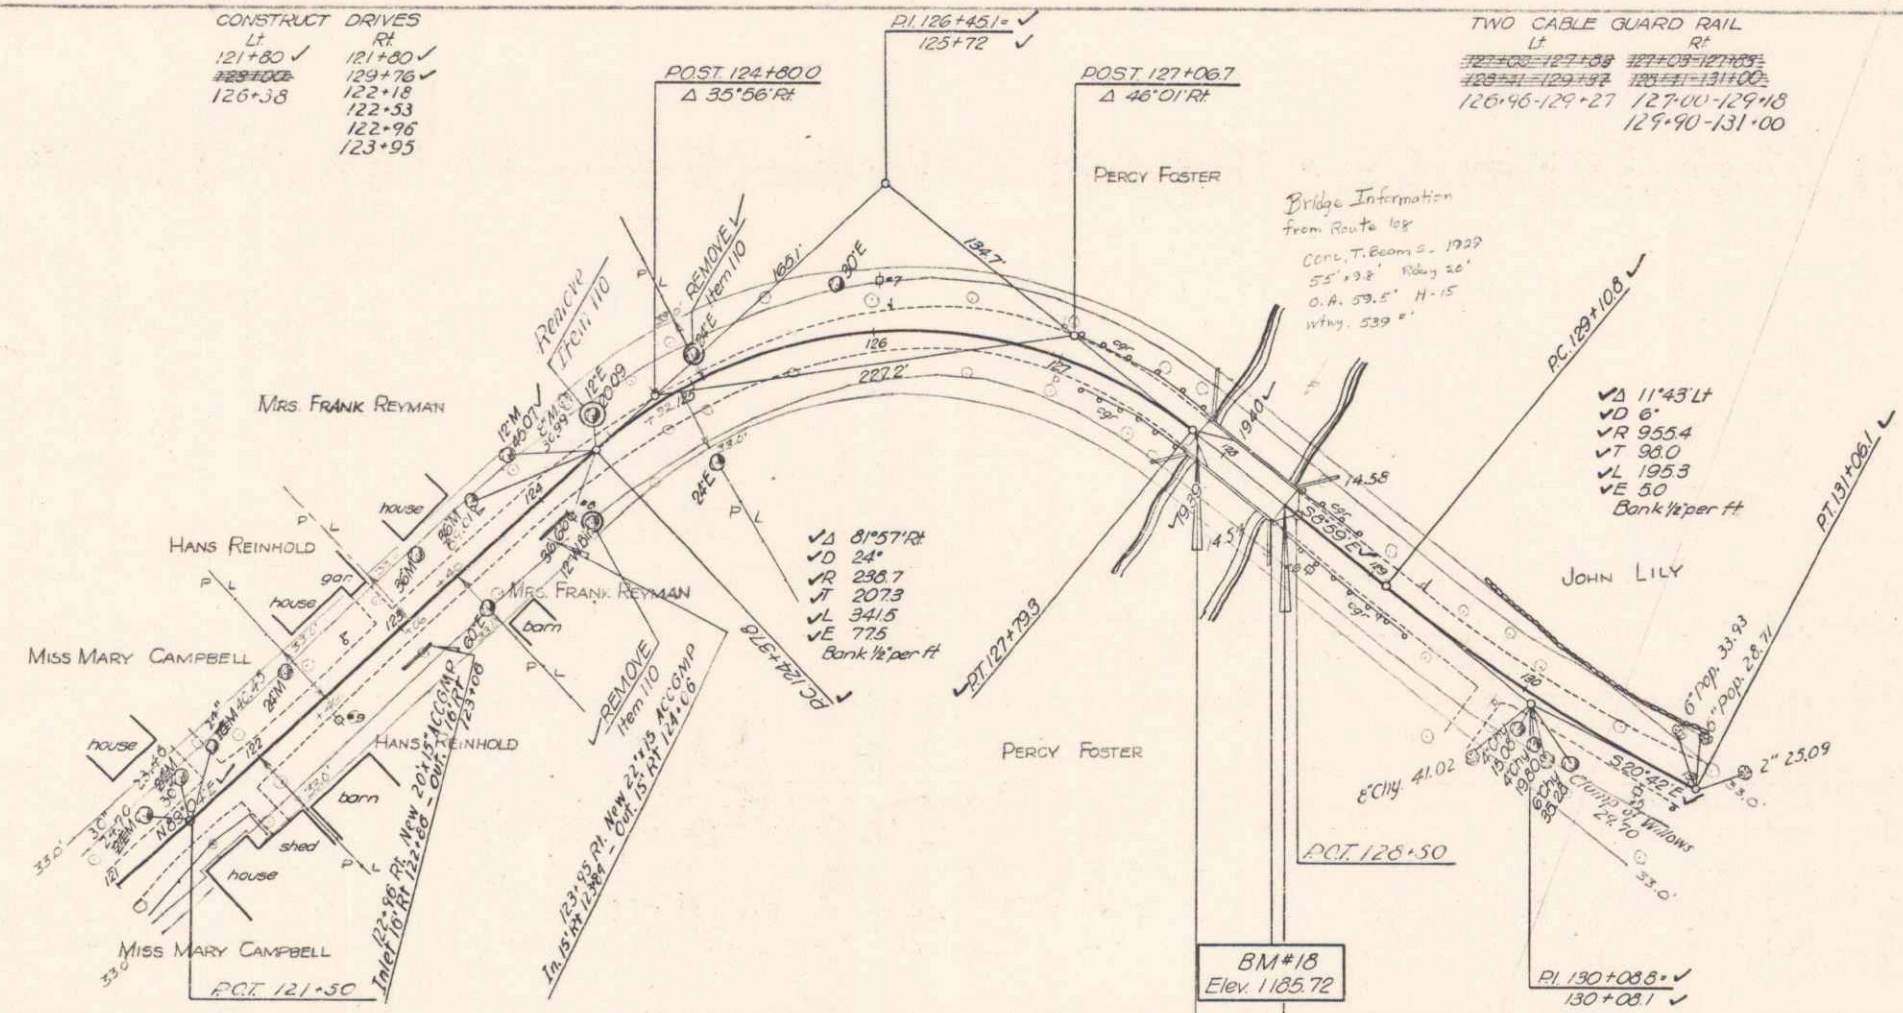

PLAN  
 SCALE 1" = 40'  
 DATE 1/24/24  
 DRAWN BY G. H. HURLEY  
 CHECKED BY G. H. HURLEY

PROFILE  
 SCALE 1" = 10'  
 DATE 1/24/24  
 DRAWN BY G. H. HURLEY  
 CHECKED BY G. H. HURLEY

LONDONDERY WESTON  
 Project No. 24411  
 17 of 47

6