


PLAN
 DATE: 12/25/54
 DRAWN BY: G. W. HURLEY
 CHECKED BY: J. W. HURLEY
 NO. 11784

PROFILE
 DATE: 1/31/54
 DRAWN BY: G. W. HURLEY
 CHECKED BY: J. W. HURLEY
 NO. 11784

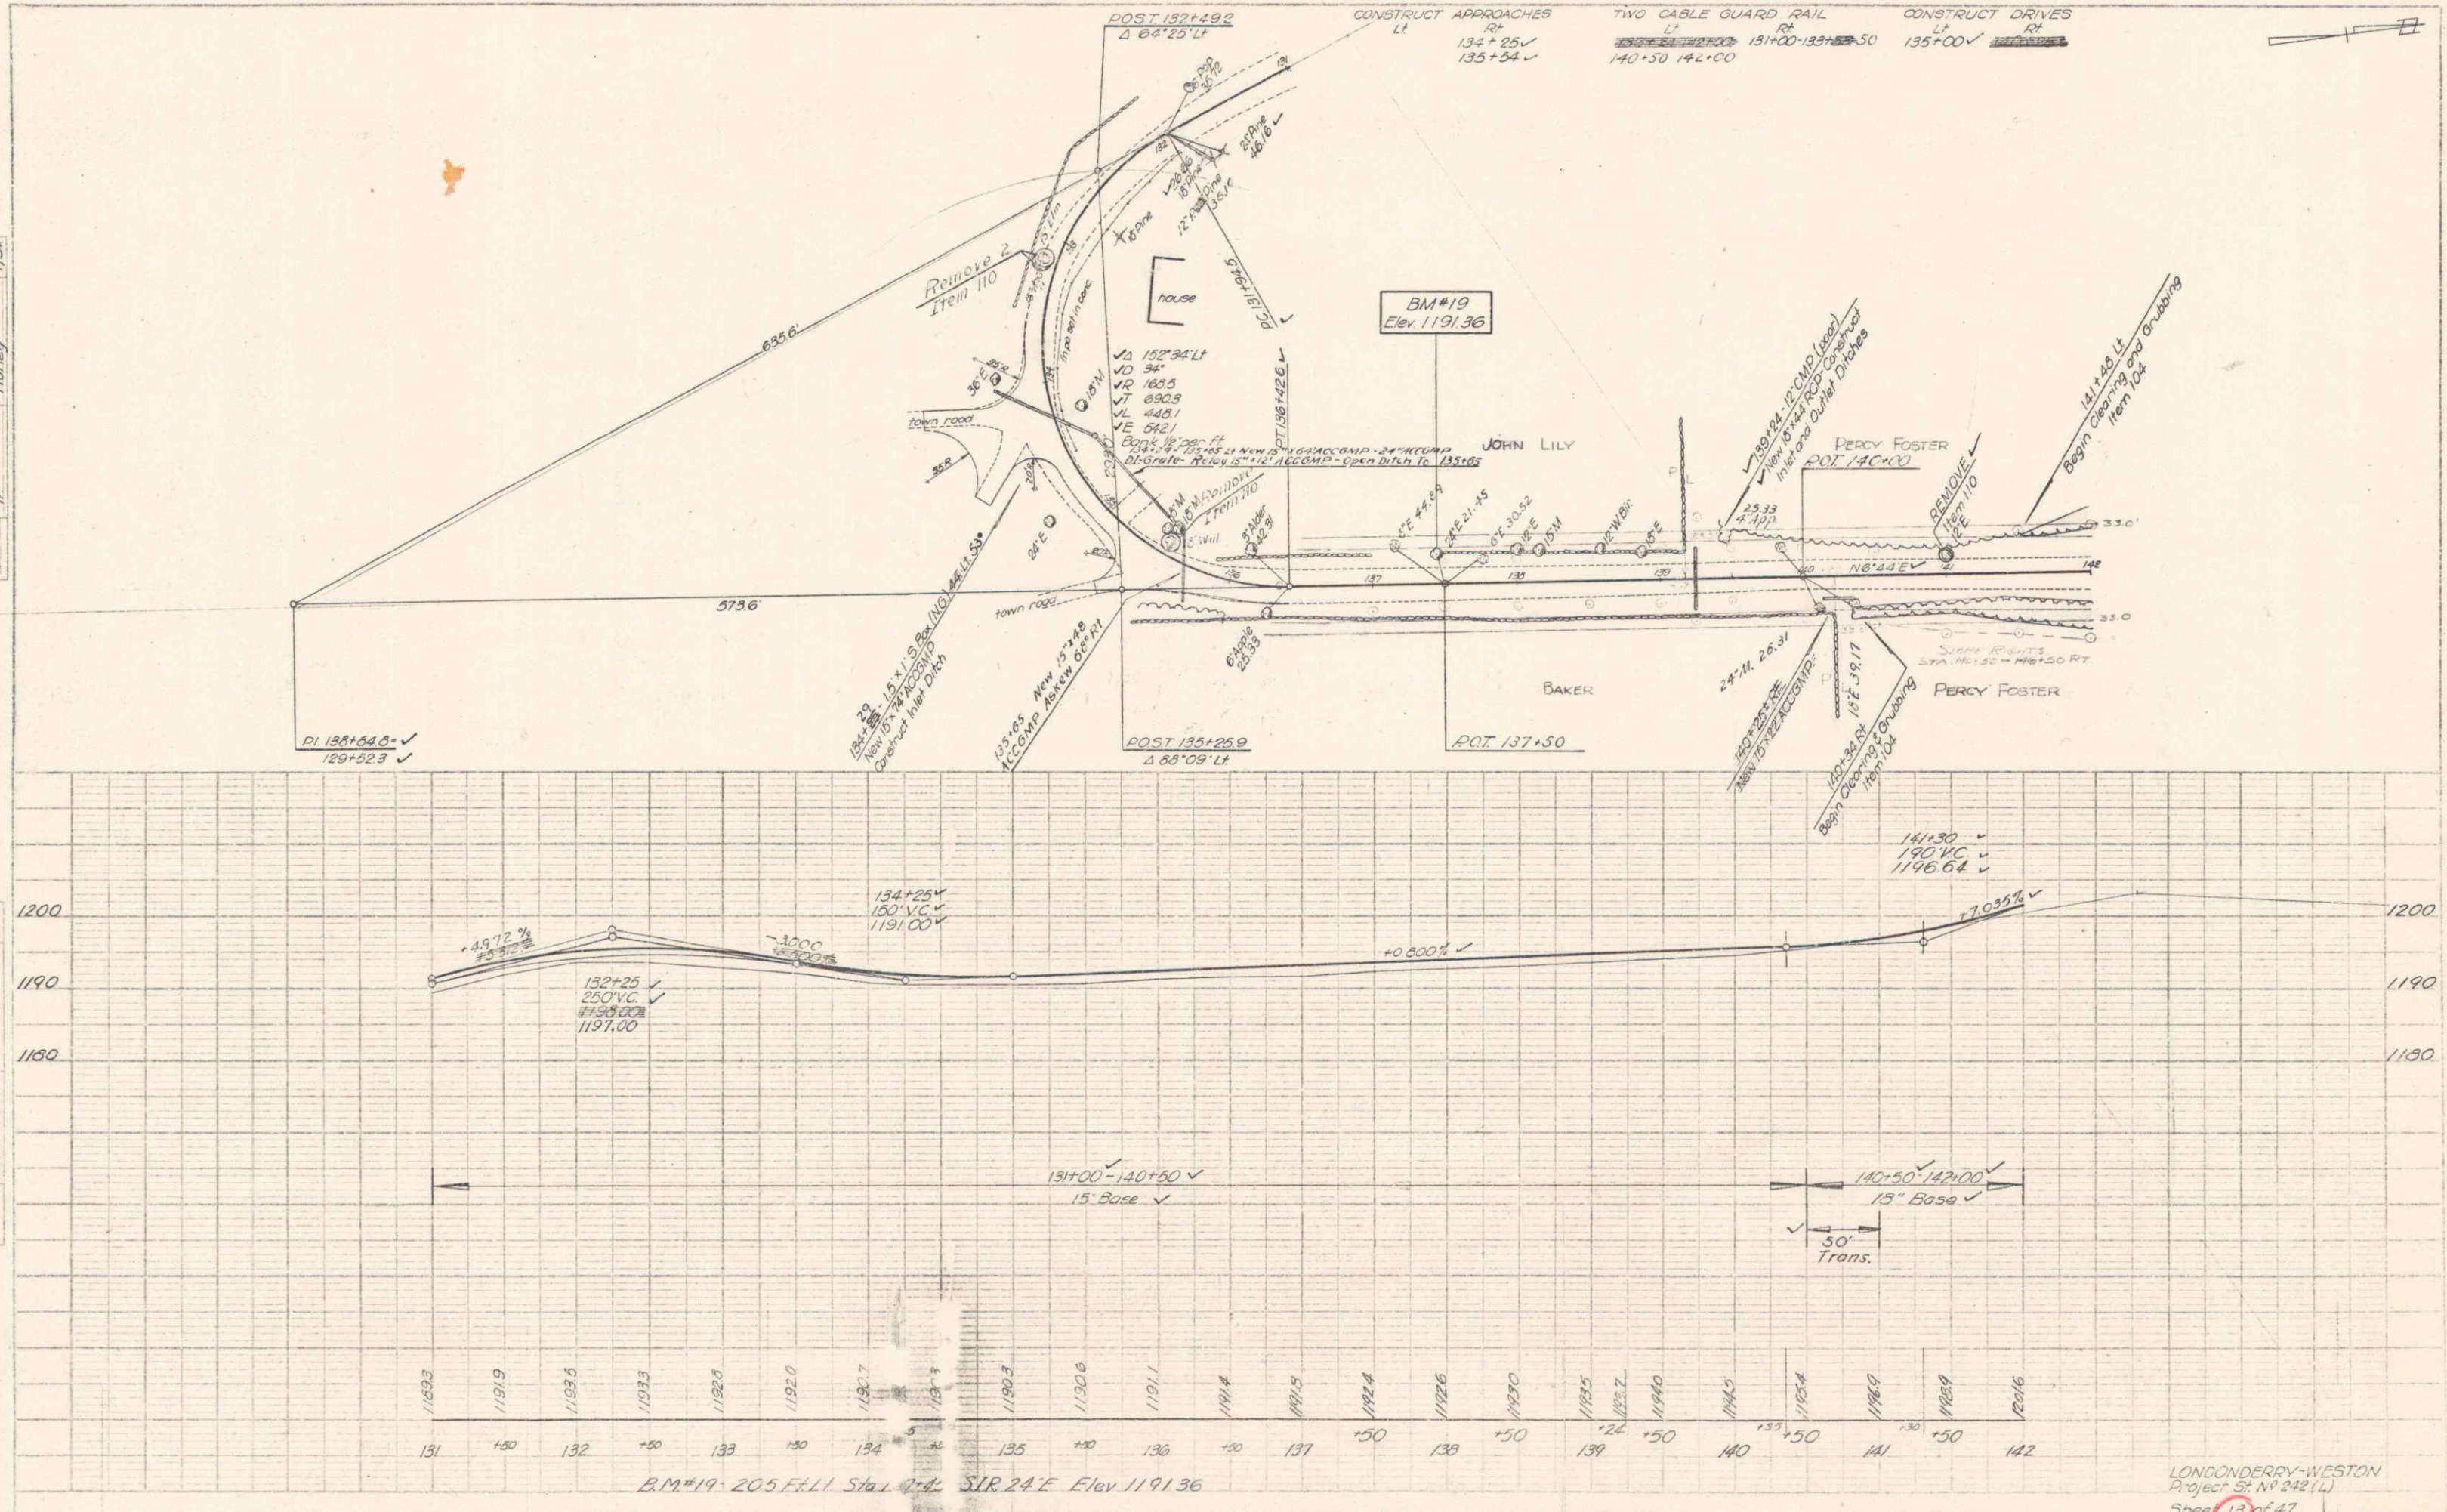

LONDONDERRY-WESTON
 Project No. 242 (L)
 Sheet 13 of 47