
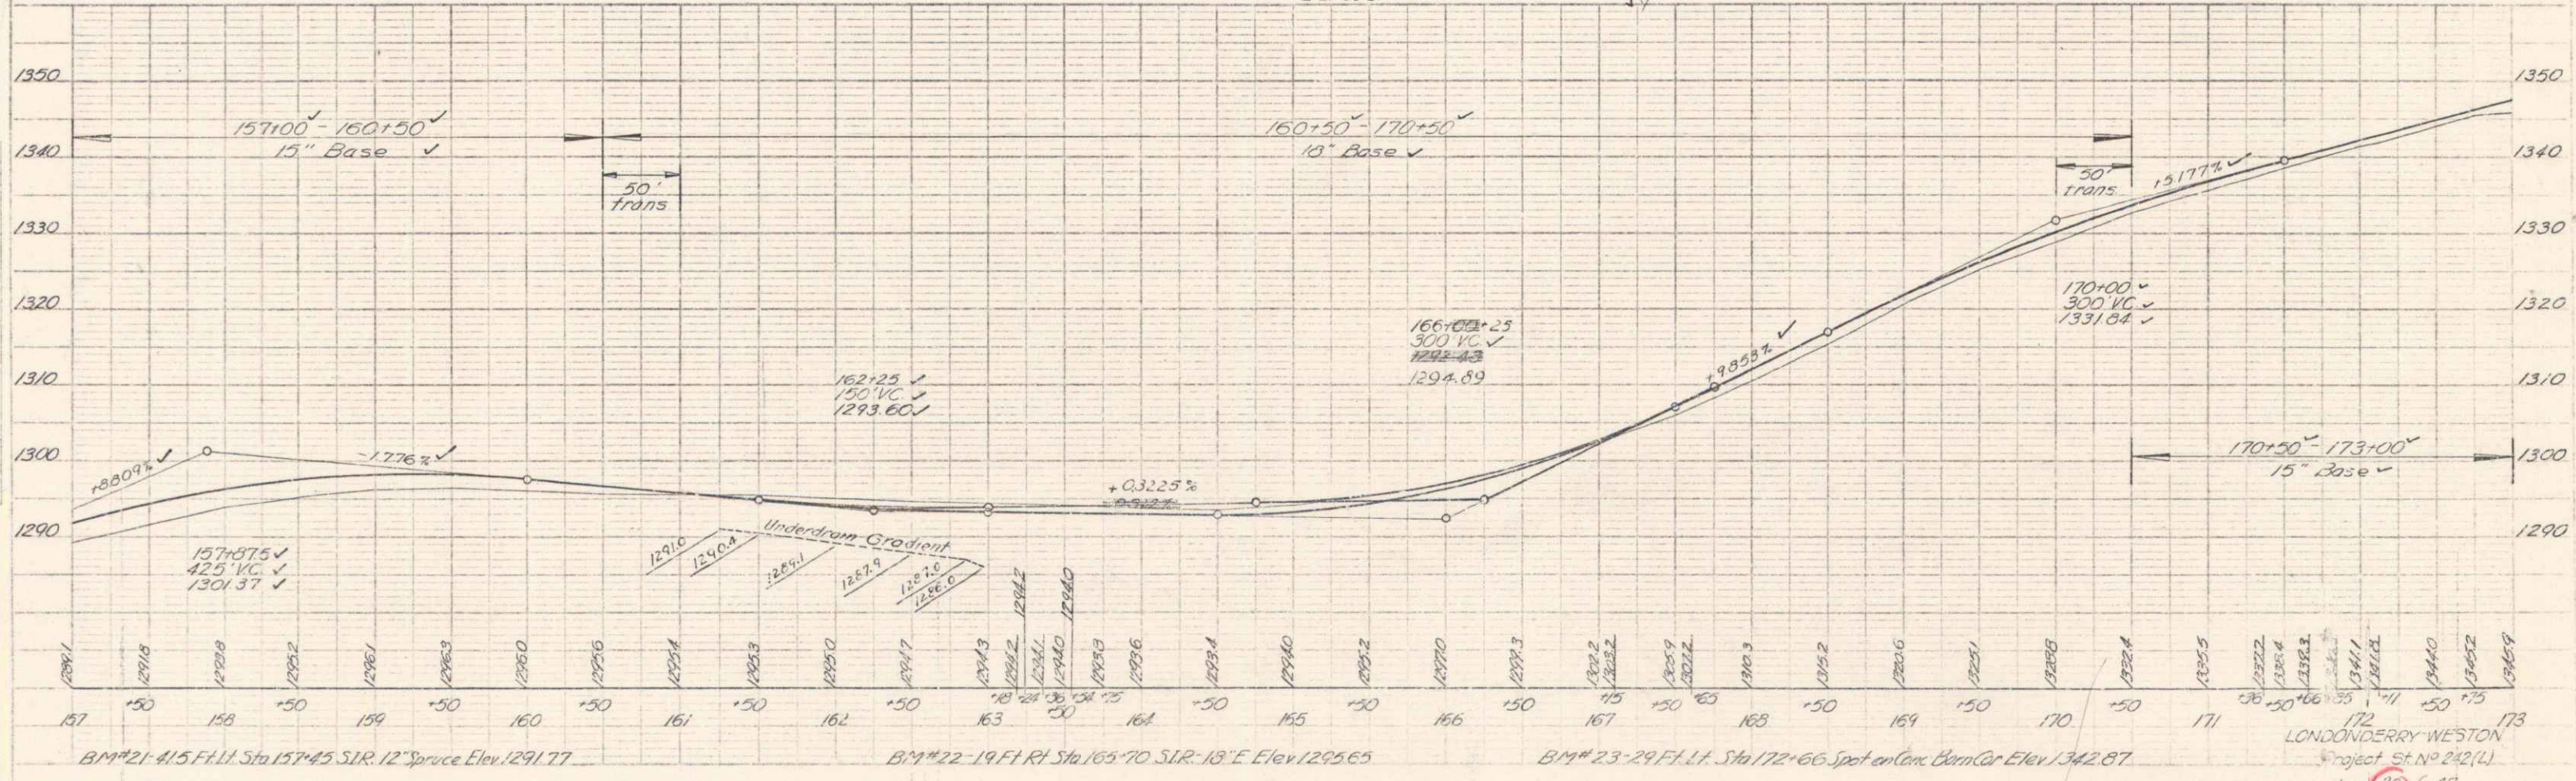


PLAN
 DATE: 12/28/64
 DRAWN BY: Lavin
 CHECKED BY: Murtley
 TITLE: PERCY FOSTER
 PROJECT: LONDONERRY WESTON
 SHEET NO. 1/54

11/17/64
 72
 M.S.

PROFILE
 DATE: 12/28/64
 DRAWN BY: Lavin
 CHECKED BY: Murtley
 TITLE: PERCY FOSTER
 PROJECT: LONDONERRY WESTON
 SHEET NO. 1/54

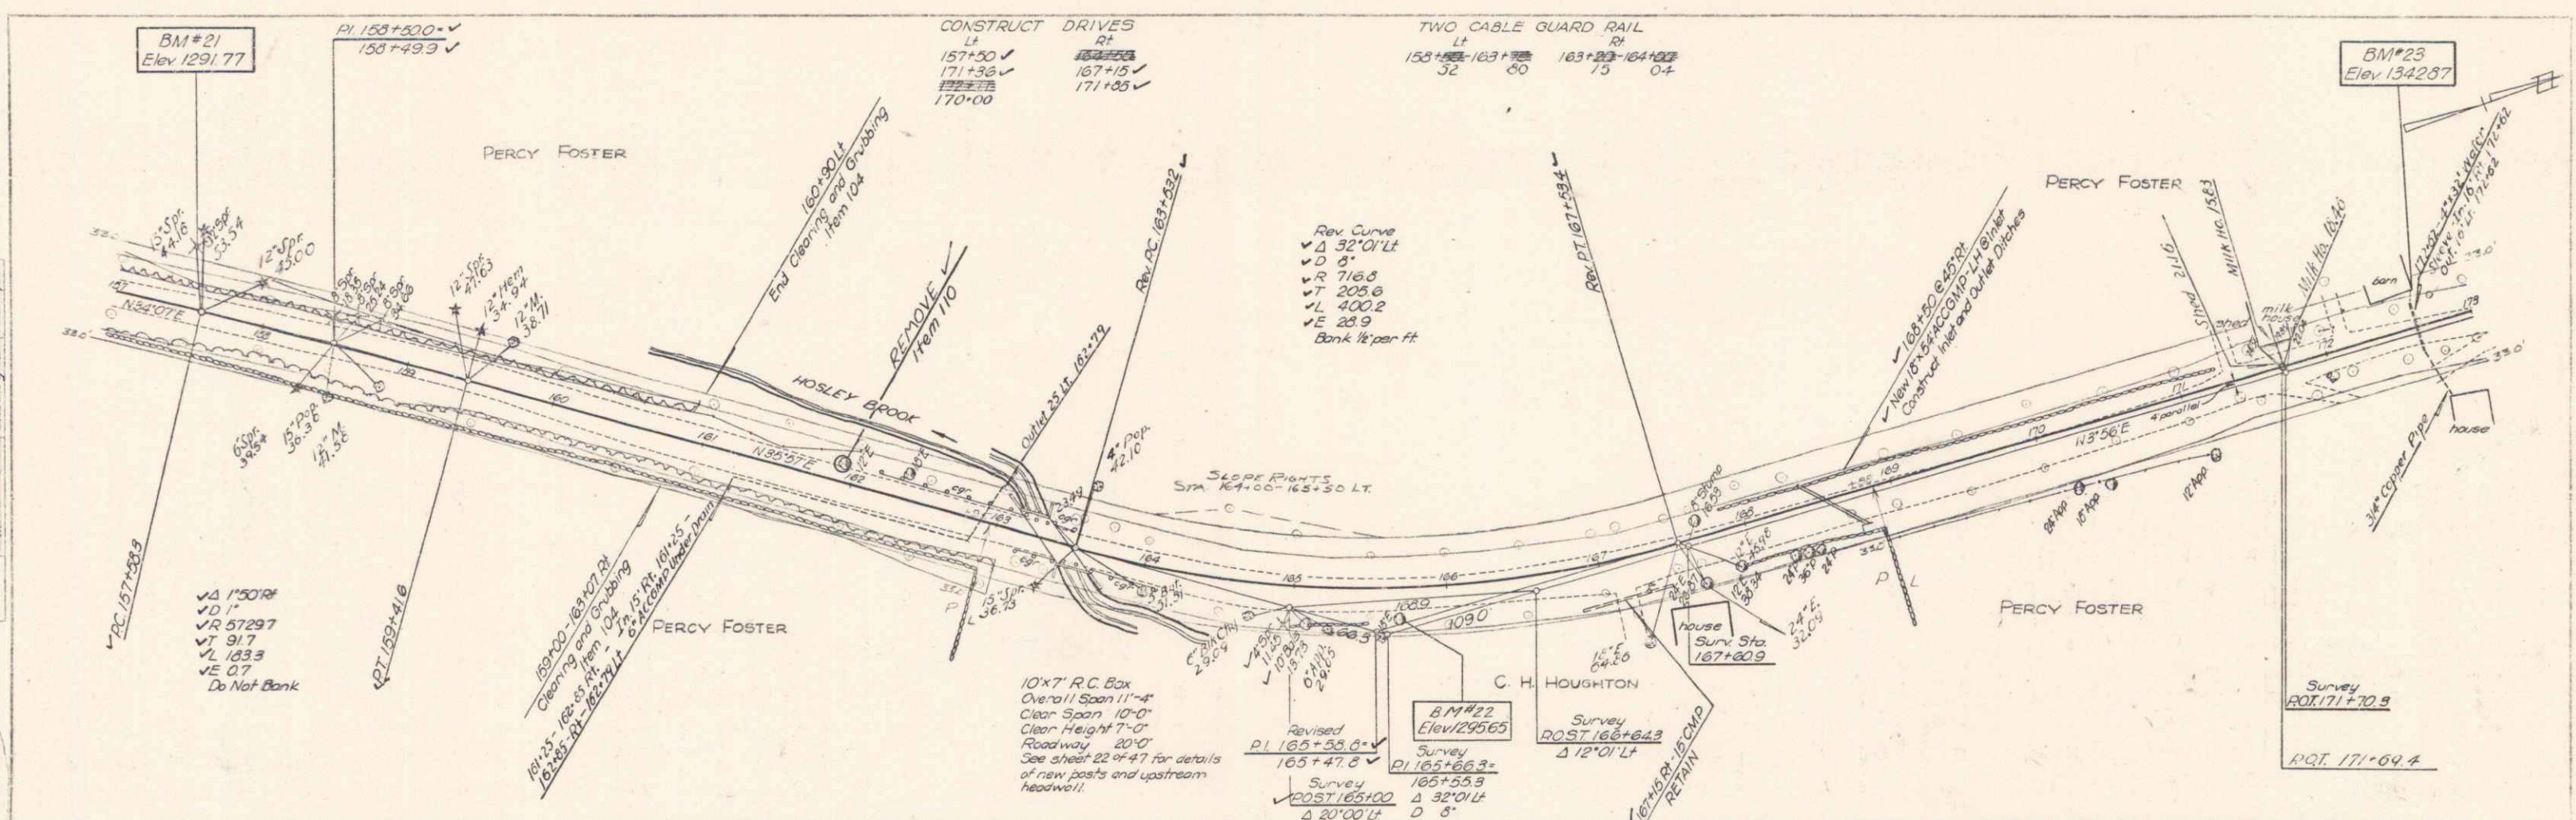

B.M.#21 - 41.5 FT. L.H. Sta 157+45 S.I.R. 12" Spruce Elev. 1291.77
 B.M.#22 - 19 FT. R.I. Sta 165+70 S.I.R. 18" E Elev. 1295.65
 B.M.#23 - 29 FT. L.H. Sta 172+66 Spot on Corn. Churn Car Elev. 1342.87
 LONDONERRY WESTON
 Project St. No. 242(L)
 11/20/64