


PLAN
 DATE: 5-24-24
 DRAWN BY: W. Smith
 CHECKED BY: J. Smith
 NO. 100



PROFILE
 DATE: 5-24-24
 DRAWN BY: Burns
 CHECKED BY: S. S. S.
 NO. 100

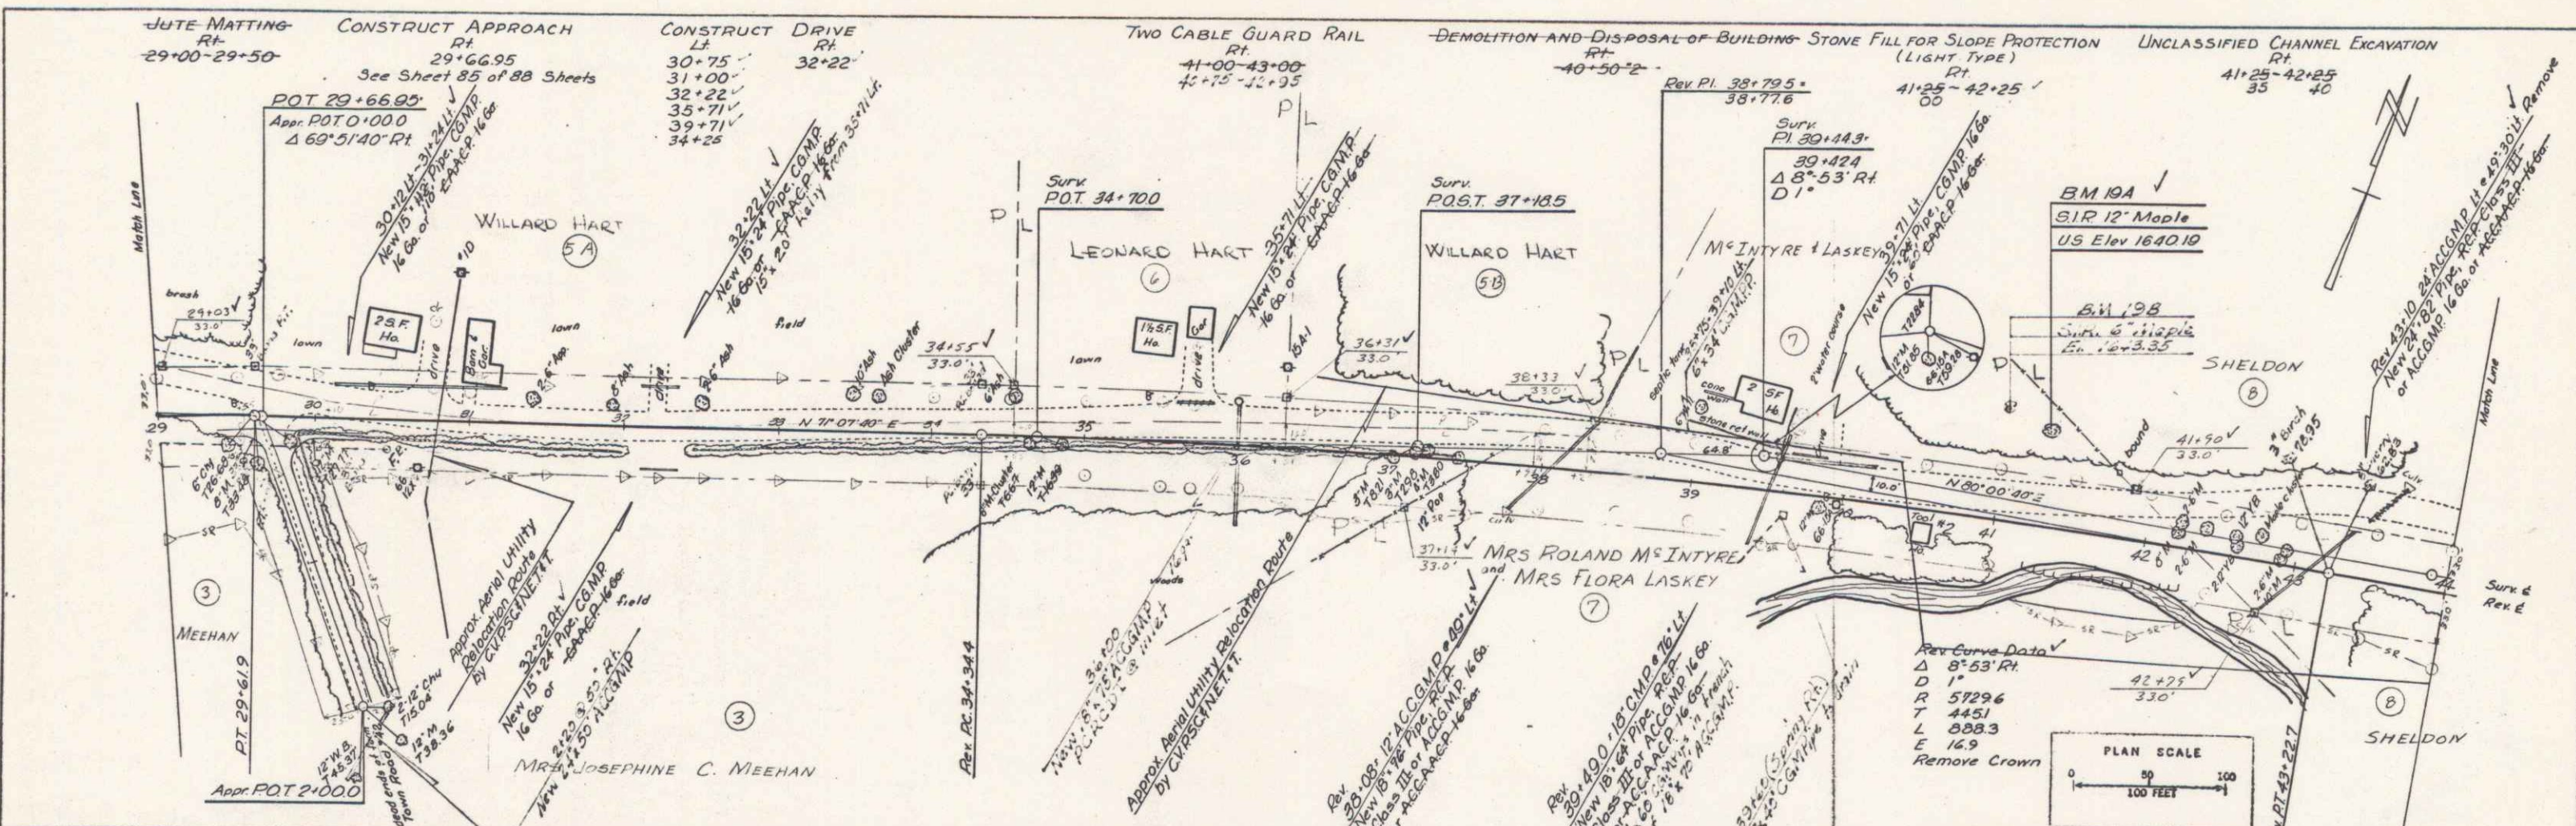