


PLAN
 DRAWN BY: [Name]
 CHECKED BY: [Name]
 DATE: [Date]
 SCALE: [Scale]
 SHEET: [Sheet]

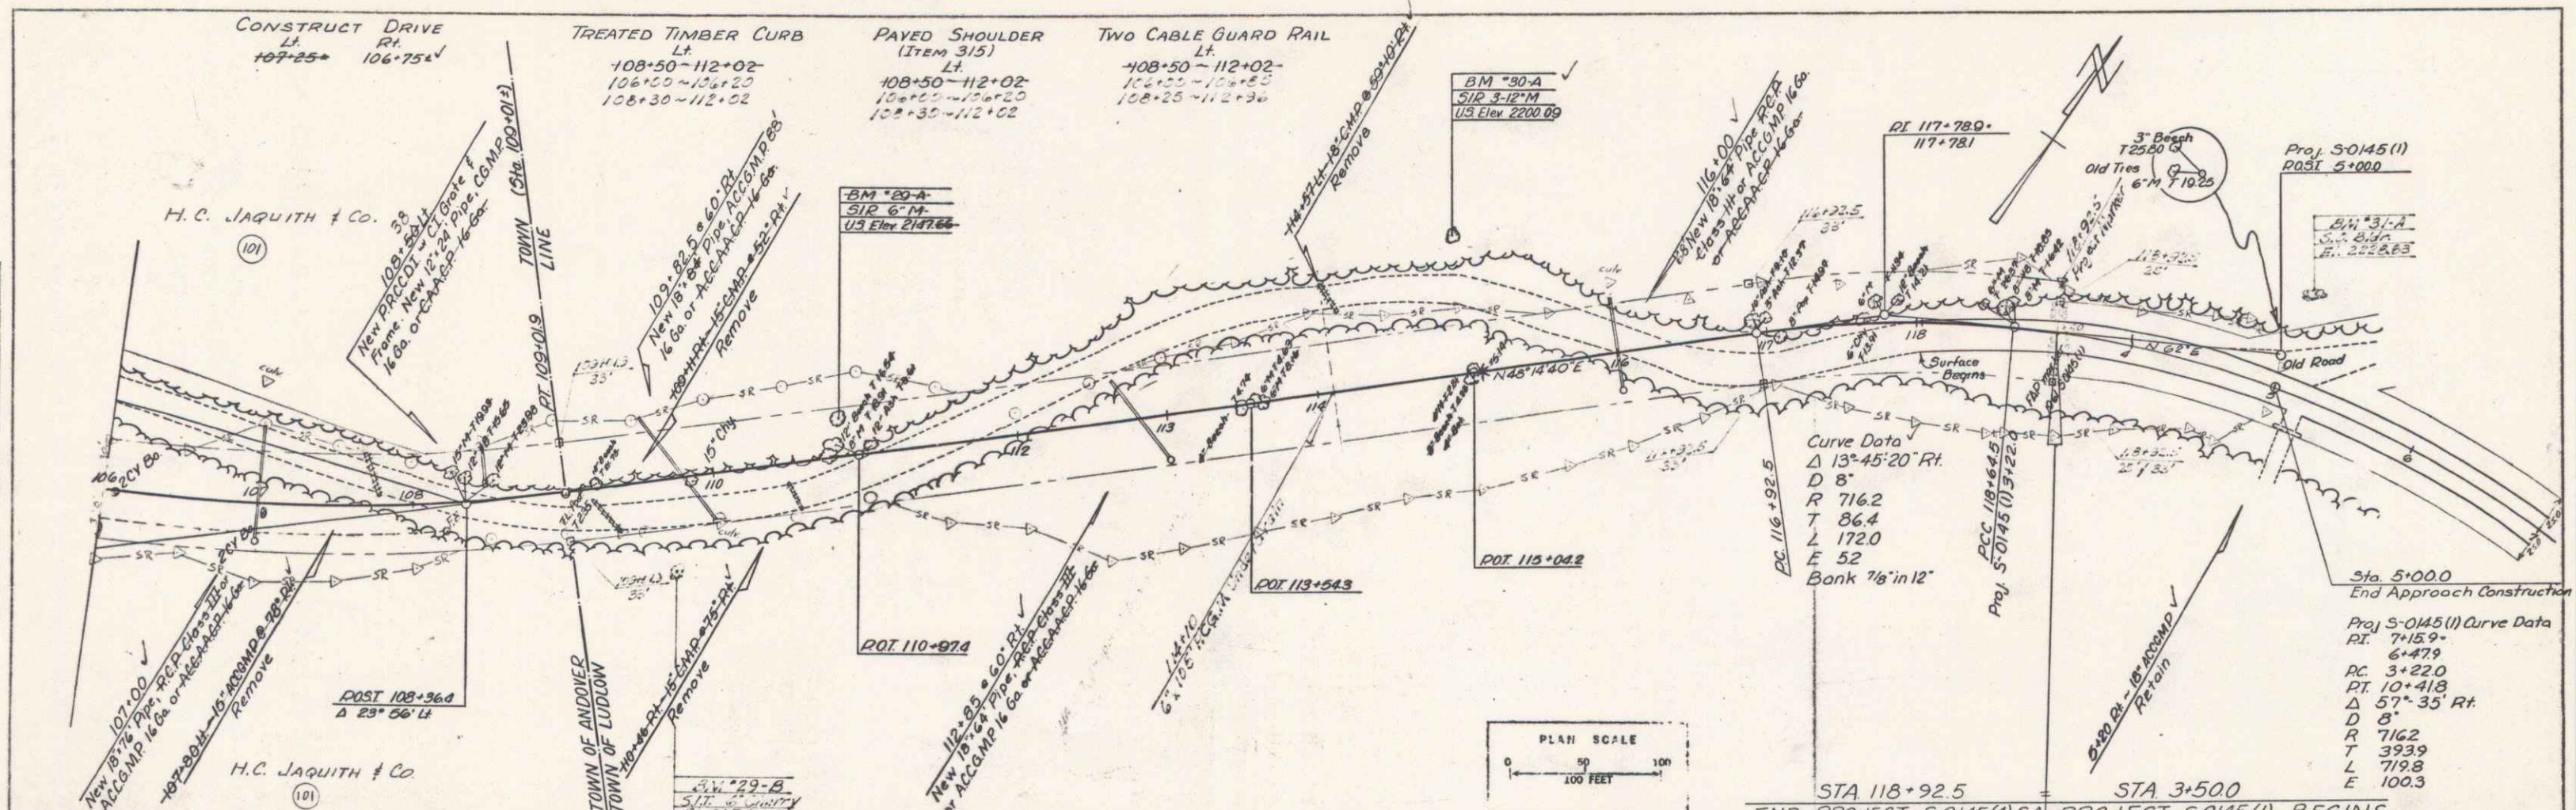

PROFILE
 DRAWN BY: [Name]
 CHECKED BY: [Name]
 DATE: [Date]
 SCALE: [Scale]
 SHEET: [Sheet]

