
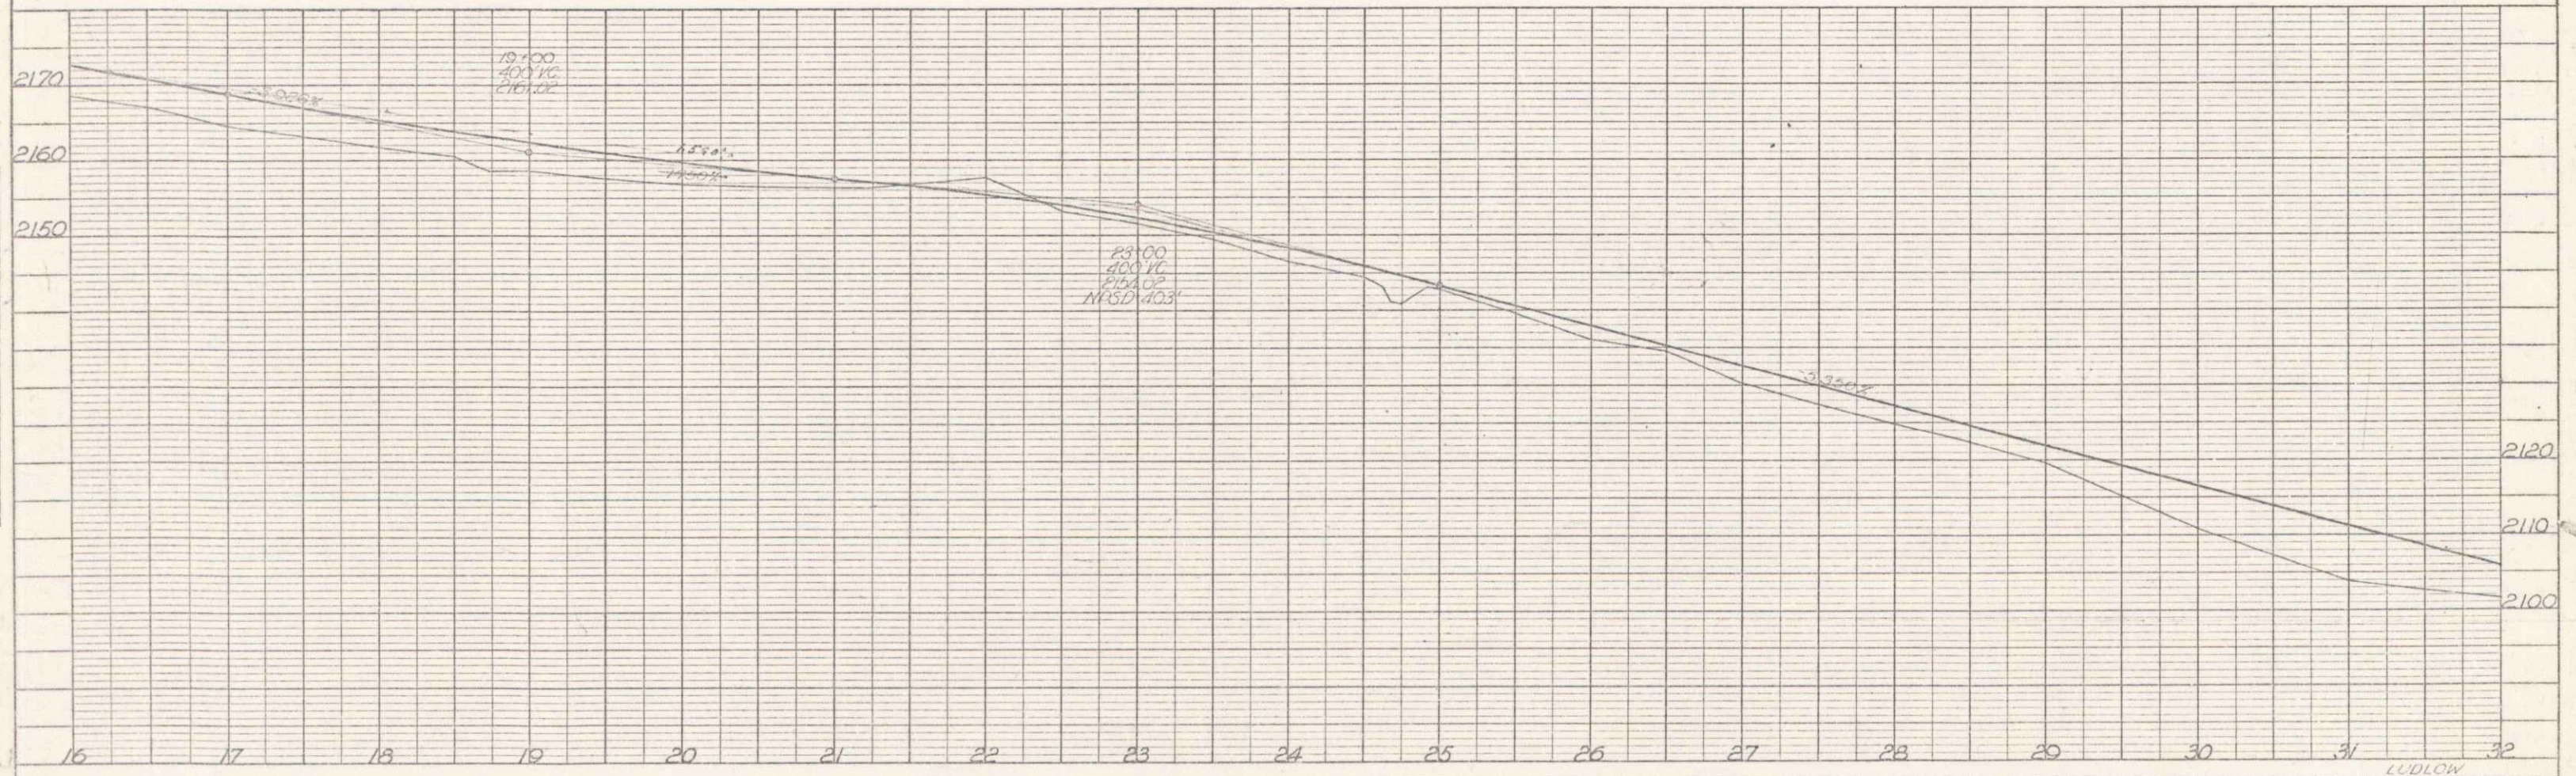


TWO CABLE GUARD RAILS  
 1.1 R1  
 20183-31192

Wood Gable Trts  
 Lt. 1942-2112 H. 2945-3210  
 Lt. 2700-2900  
 Lt. 2940-3150

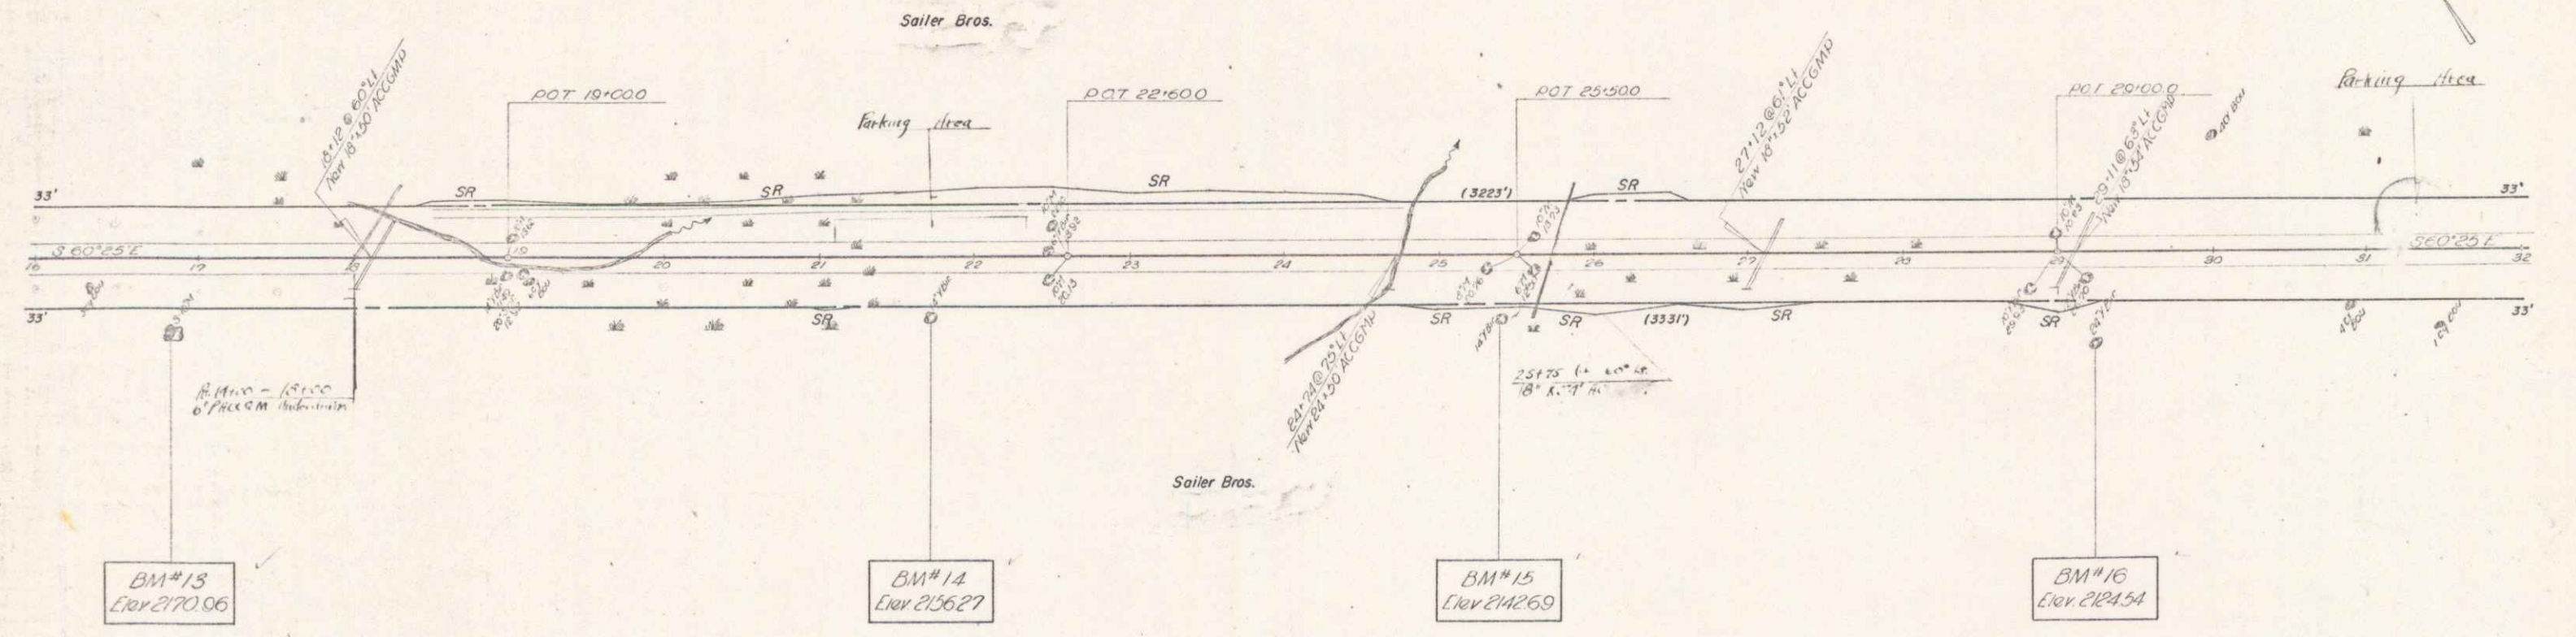

PLAN

DATE	11/12/22
BY	...
CHECKED	...
SCALE	AS SHOWN

PROFILE

DATE	11/12/22
BY	...
CHECKED	...
SCALE	AS SHOWN

PLATE 1 - PLAN - PROFILE - O.D. & R.E. BUNNING  
 HOFFEL & EMMER CO., NEW YORK  
 11/12/22

LUDLOW  
 Proj. 2025 (1)  
 Sheet No. 56