


TWO CABLE GUARD RAIL
L.A. R.I.
-2040-8142-

Wood Guide Posts
St. 18+12 - 21+12 Hi. 294.95 - 32+10
St. 27+00 - 29+00
St. 29+80 - 30+50

SAILER BROS
PLYMOUTH, VT

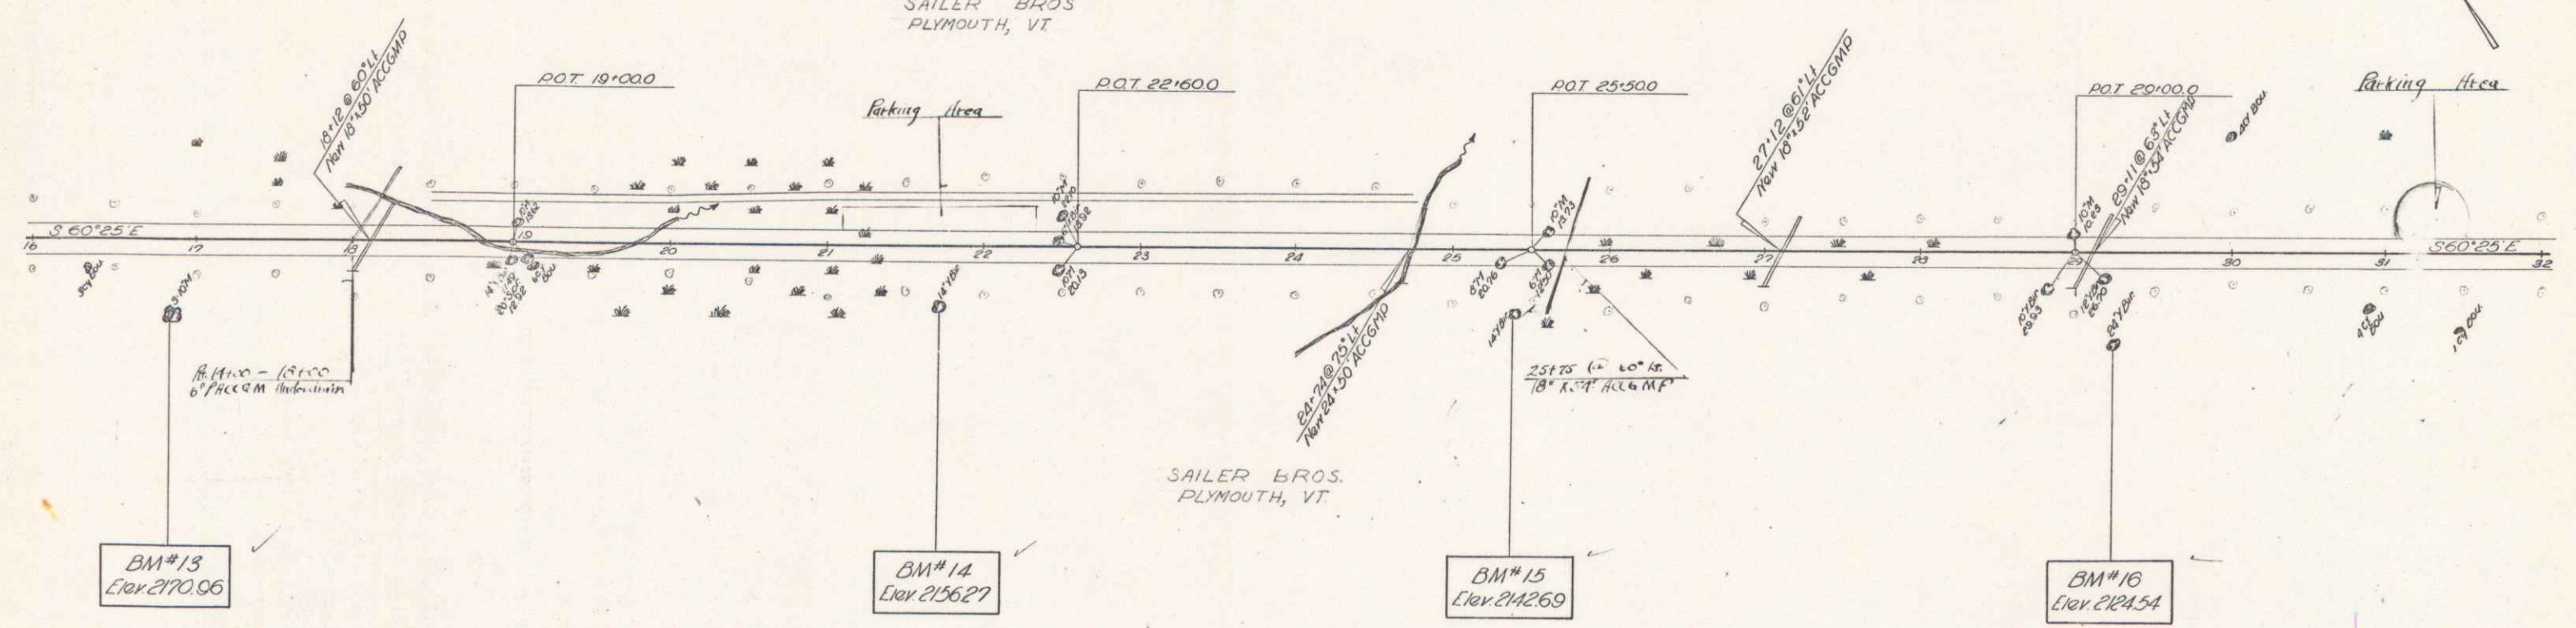

BM#13
Elev. 2170.96

BM#14
Elev. 2156.27

BM#15
Elev. 2142.69

BM#16
Elev. 2141.54

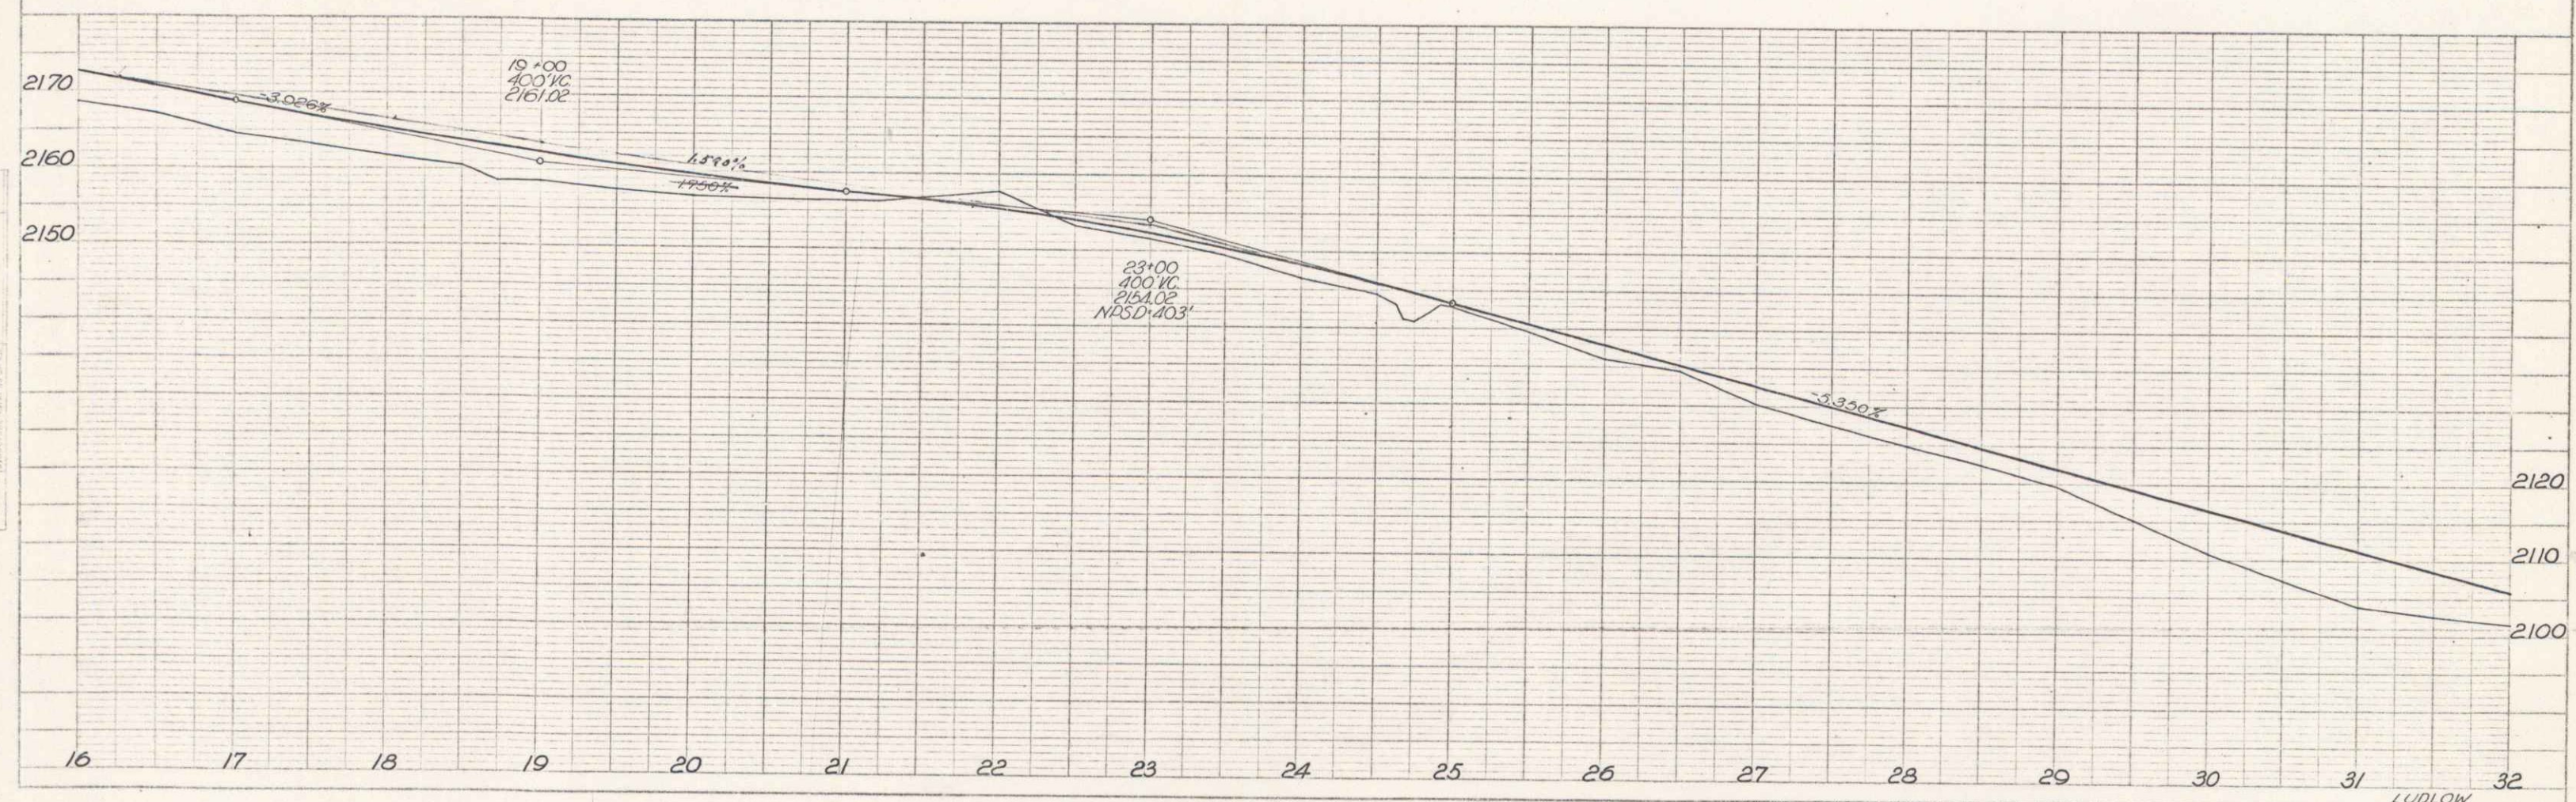


PLATE 1 PLAN, PROFILE & P. & S. STANDARD
REVISED & CHECKED, NEW YORK
SEE US FOR STANDARD
SHEET

LUDLOW
Proj. S 0445 (1)
Sheet No. of 56

16A

6

DATE: 1-30-33
BY: D.H. LUDLOW
CHECKED: J.W. LUDLOW
SCALE: AS SHOWN
PROJECT: SAILER BROS. PLYMOUTH, VT.

PROFILE
DATE: 1-30-33
BY: D.H. LUDLOW
CHECKED: J.W. LUDLOW
SCALE: AS SHOWN
PROJECT: SAILER BROS. PLYMOUTH, VT.