

DATE	BY
PLANNED	ALL
CHECKED	
IN CHARGE	
IN CHARGE	

DATE	BY
PLANNED	ALL
CHECKED	
IN CHARGE	
IN CHARGE	

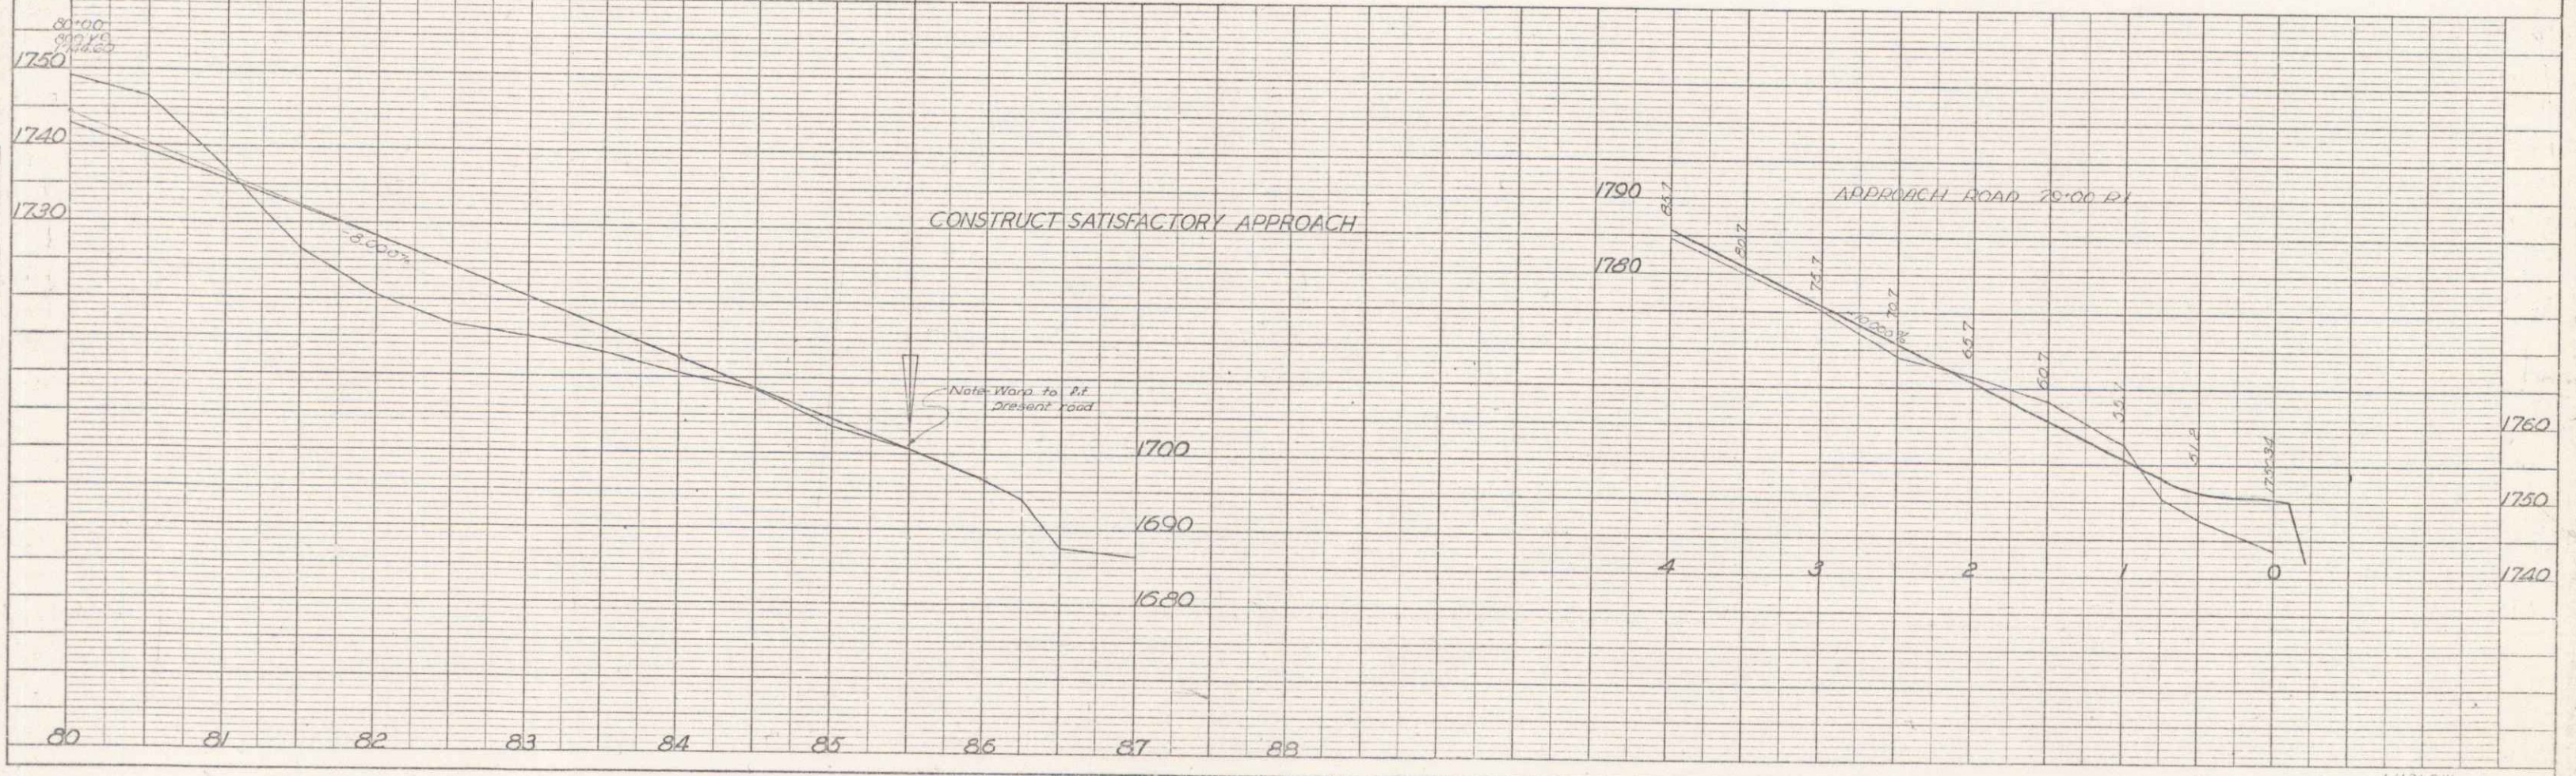
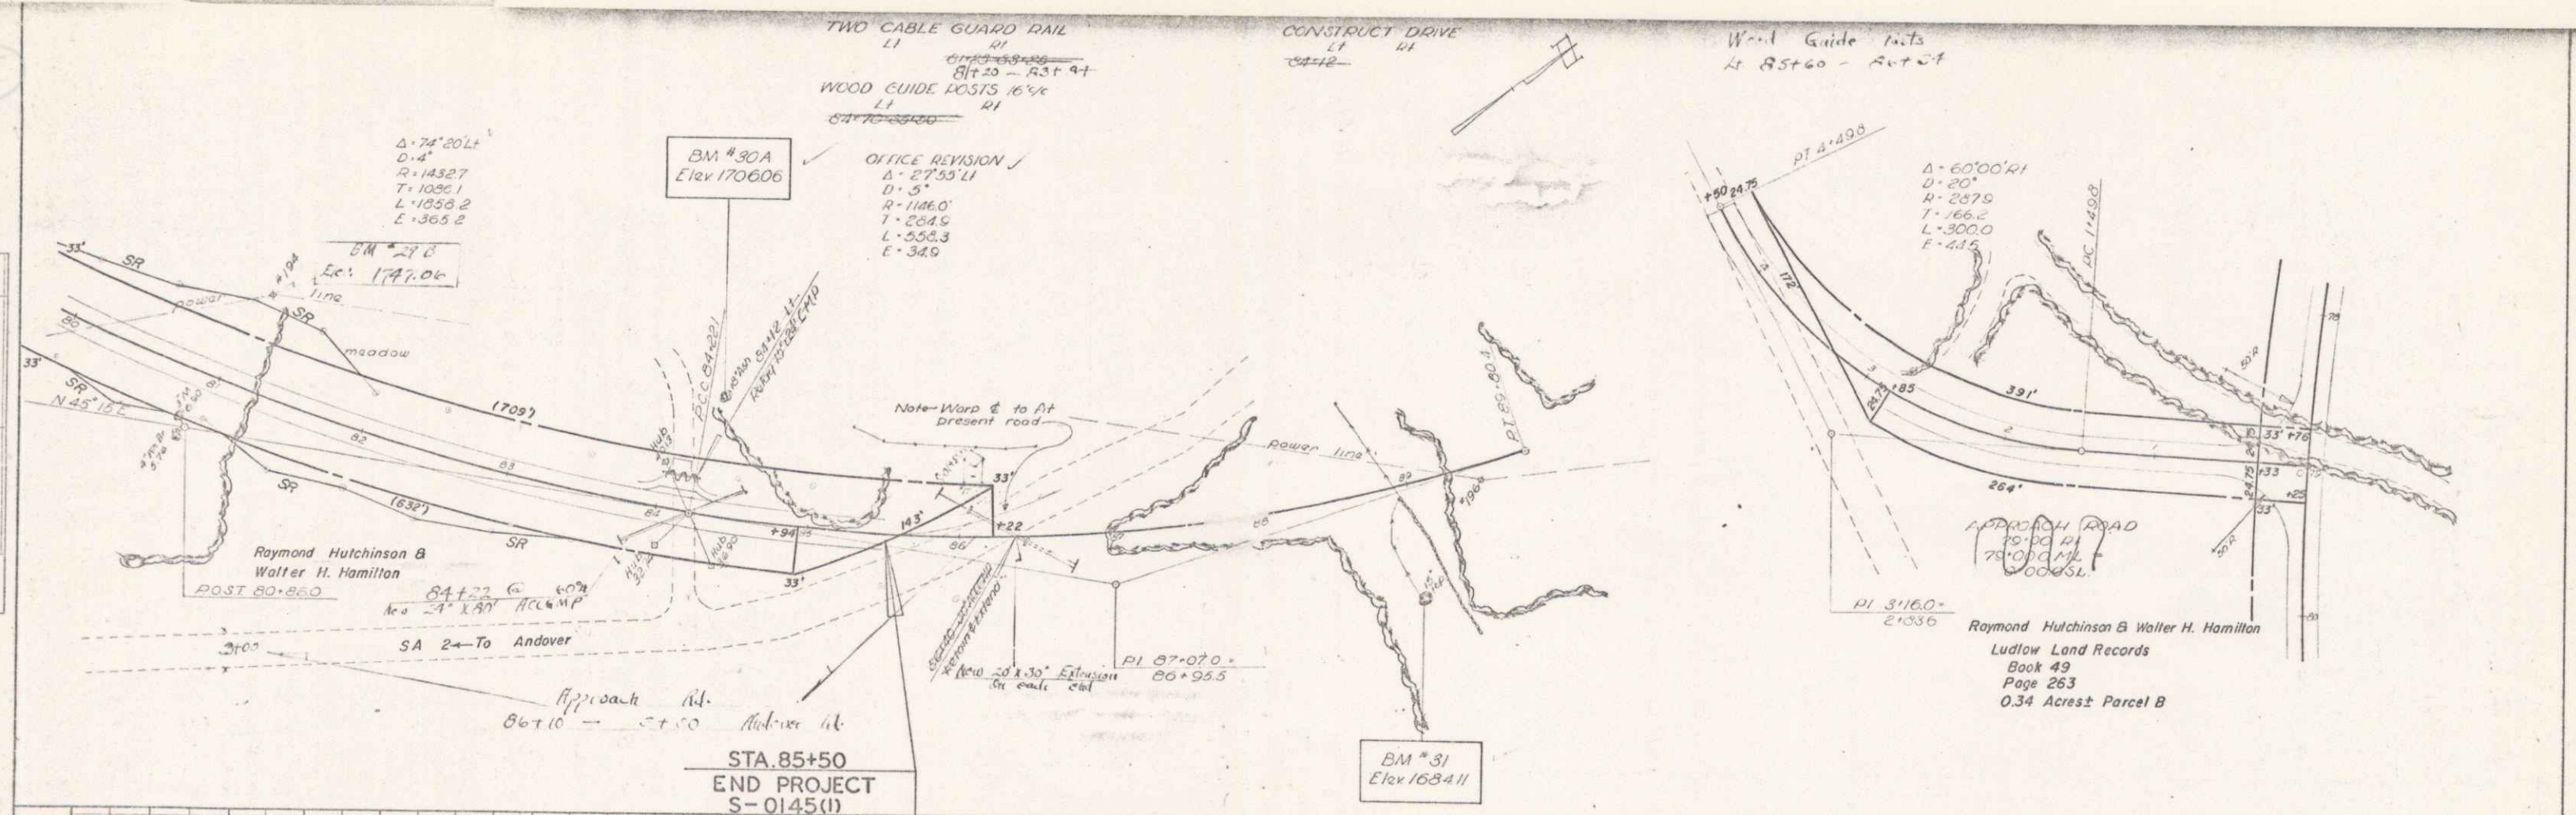


PLATE 11 - PLAN-PROFILE OF F.A.R.E. STATION  
 NEWYORK & ESSER CO., NEW YORK  
 P. E. E. CO. NO. 248-C

LUDLOW  
 Proj. 1045 (1)  
 Sheet 20 of 26