
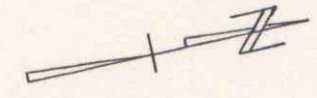


CONSTRUCT DRIVE Lt 168+85 172+50 167+75	TWO CABLE GUARD RAIL Lt 162+00-166+50 165+25-166+75	TREATED TIMBER CURB Lt 162+00-166+35	CONSTRUCT PAVED SHOULDER Lt 11.0m 358 (1 1/2 Depth) 162+00-166+85	UNCLASSIFIED CHANNEL EXCAVATION Lt 162+00-167+50
---	--	--	--	--

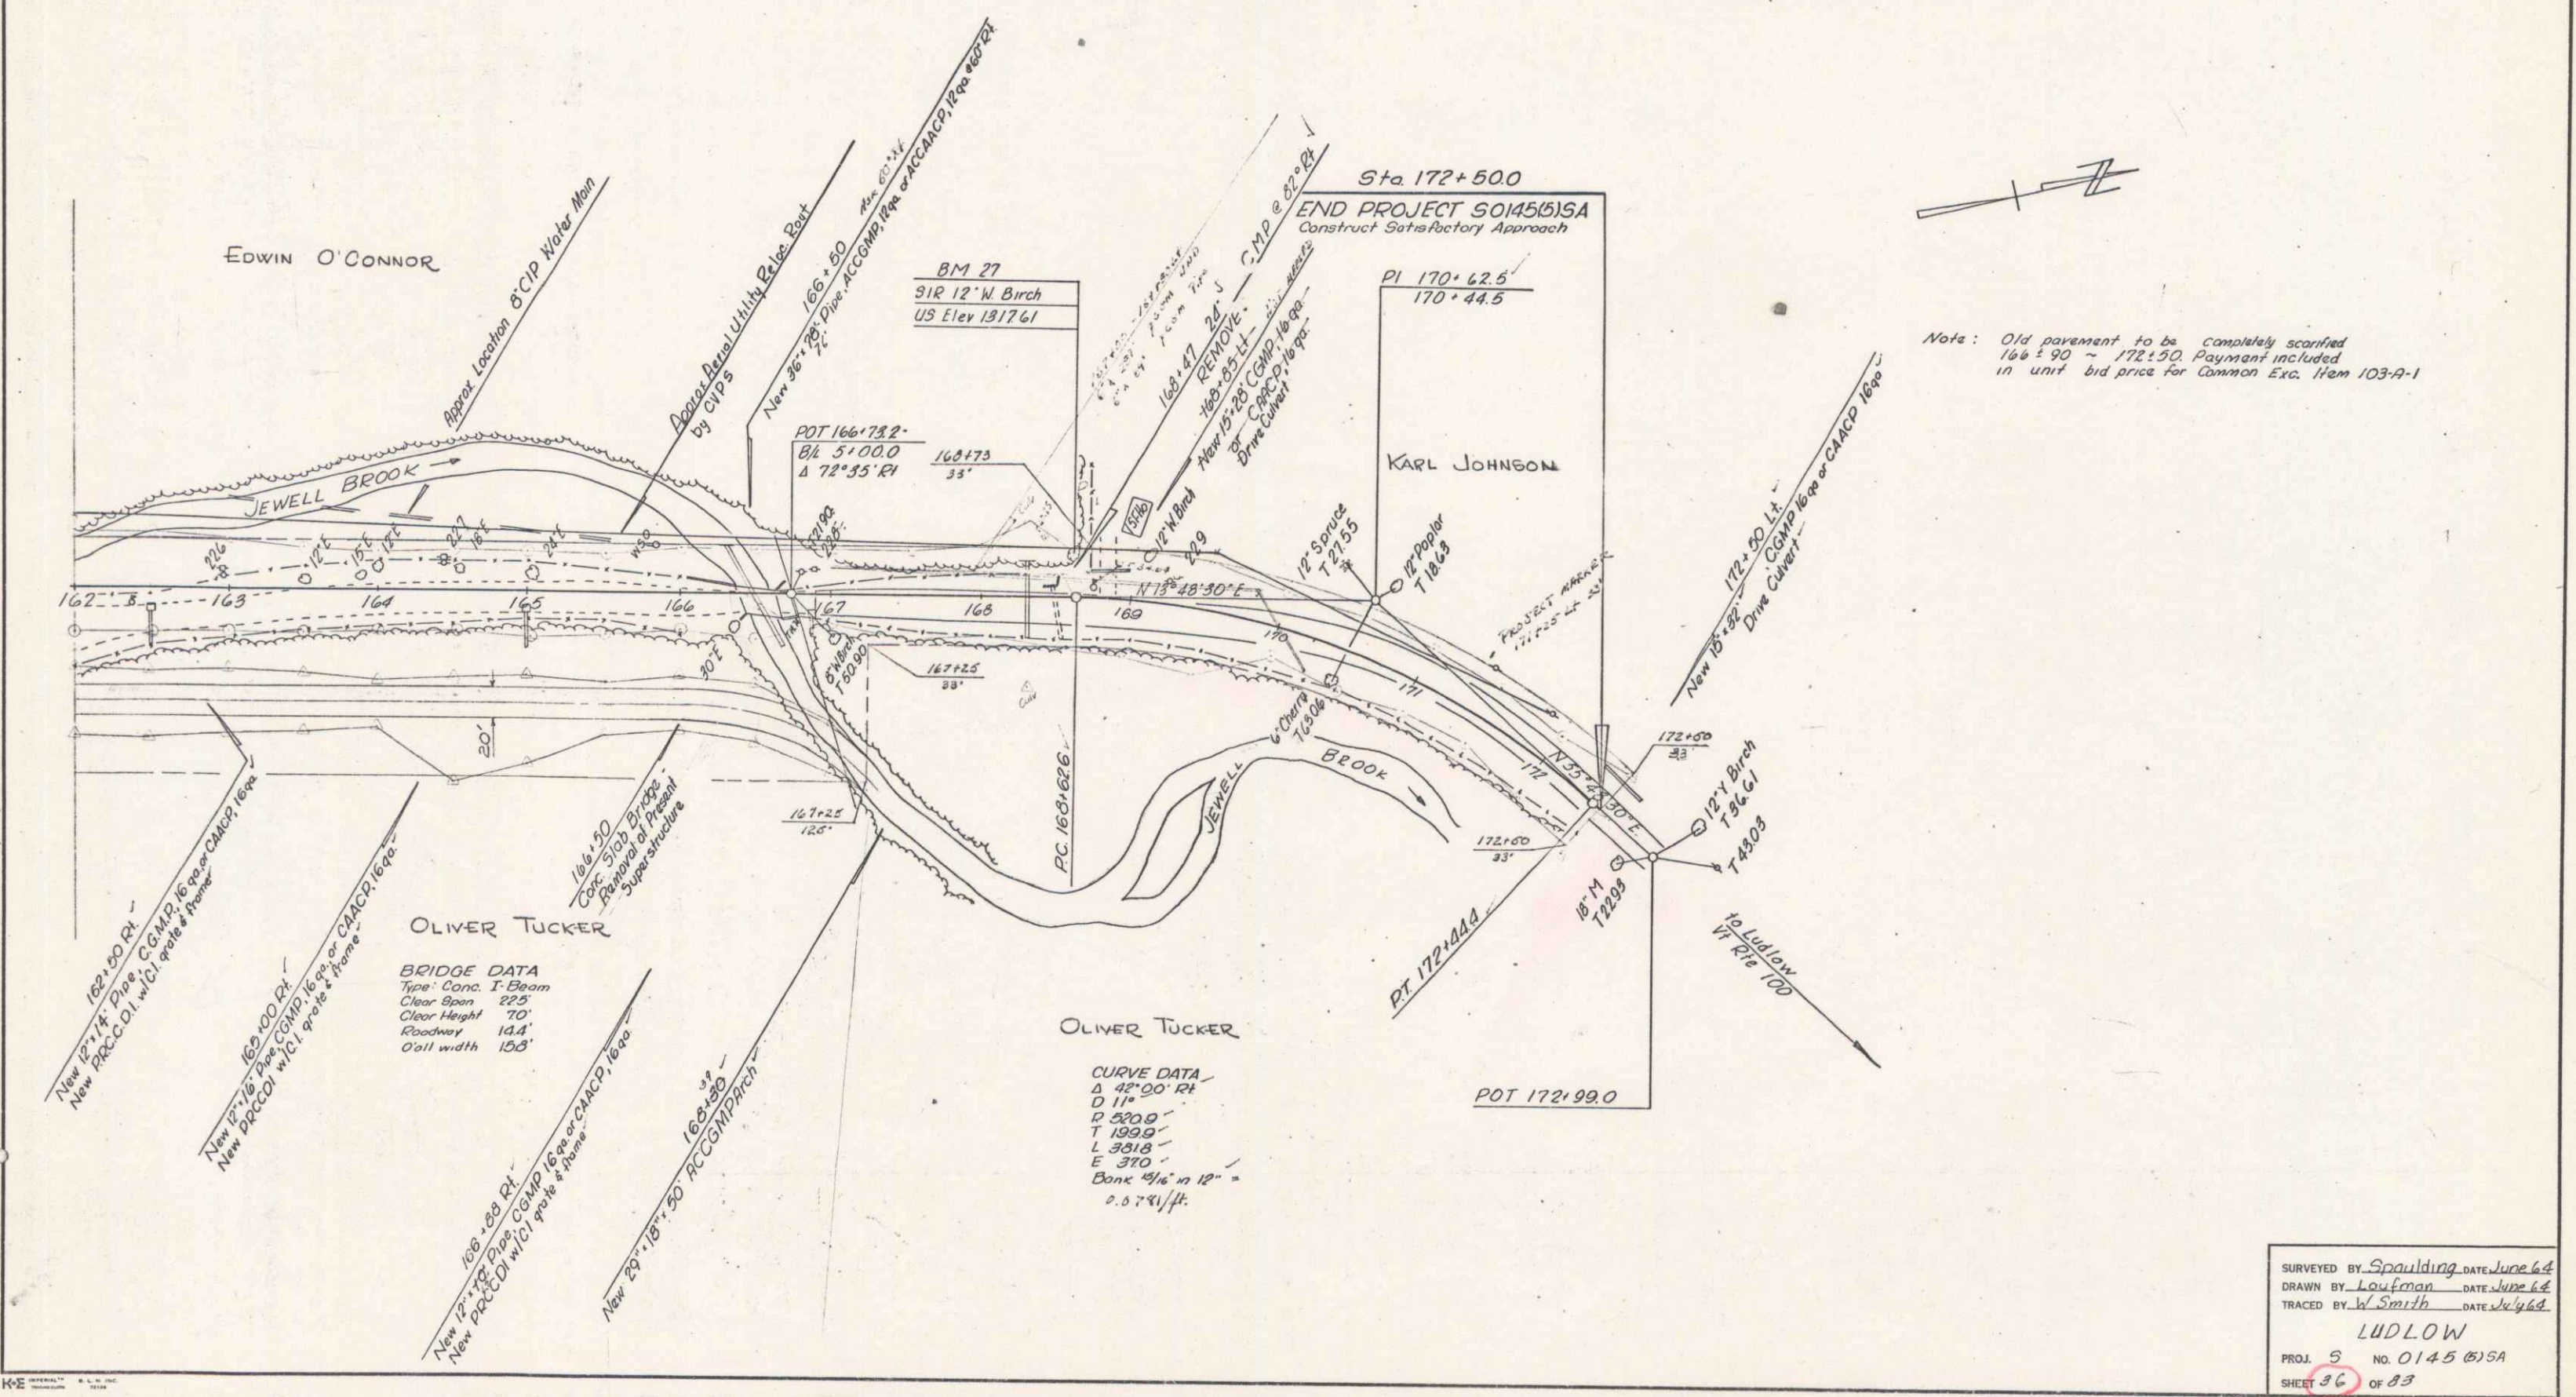

Note: Old pavement to be completely scarified  
168+90 - 172+50. Payment included  
in unit bid price for Common Exc. Item 103-A-1

SURVEYED BY Spaulding DATE June 64  
DRAWN BY Loufman DATE June 64  
TRACED BY W. Smith DATE July 64  
**LUDLOW**  
PROJ. 5 NO. 0145 (B)SA  
SHEET 36 OF 83