
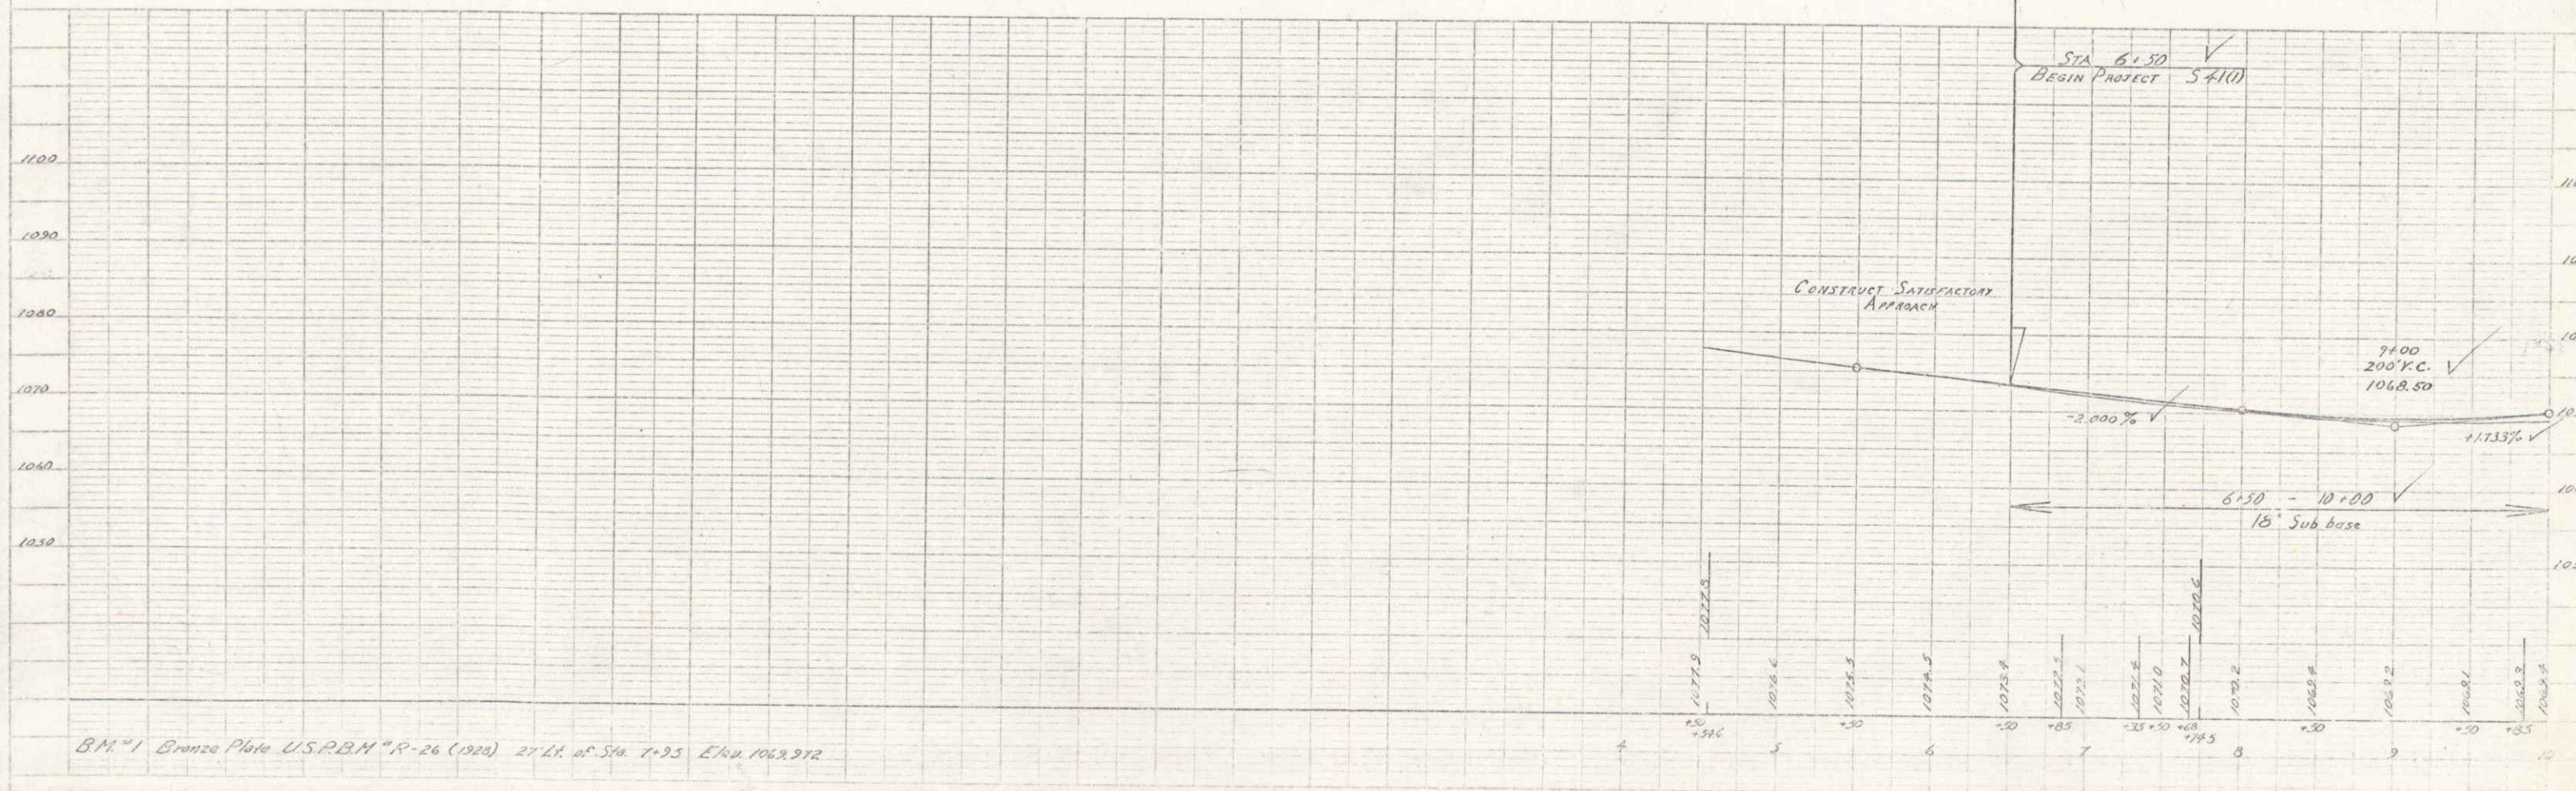


WOOD GUIDE POSTS		
STATION	LT	RT
6+50 - 7+50		5
7+00 APPR.	4	35
7+80 - 10+36		

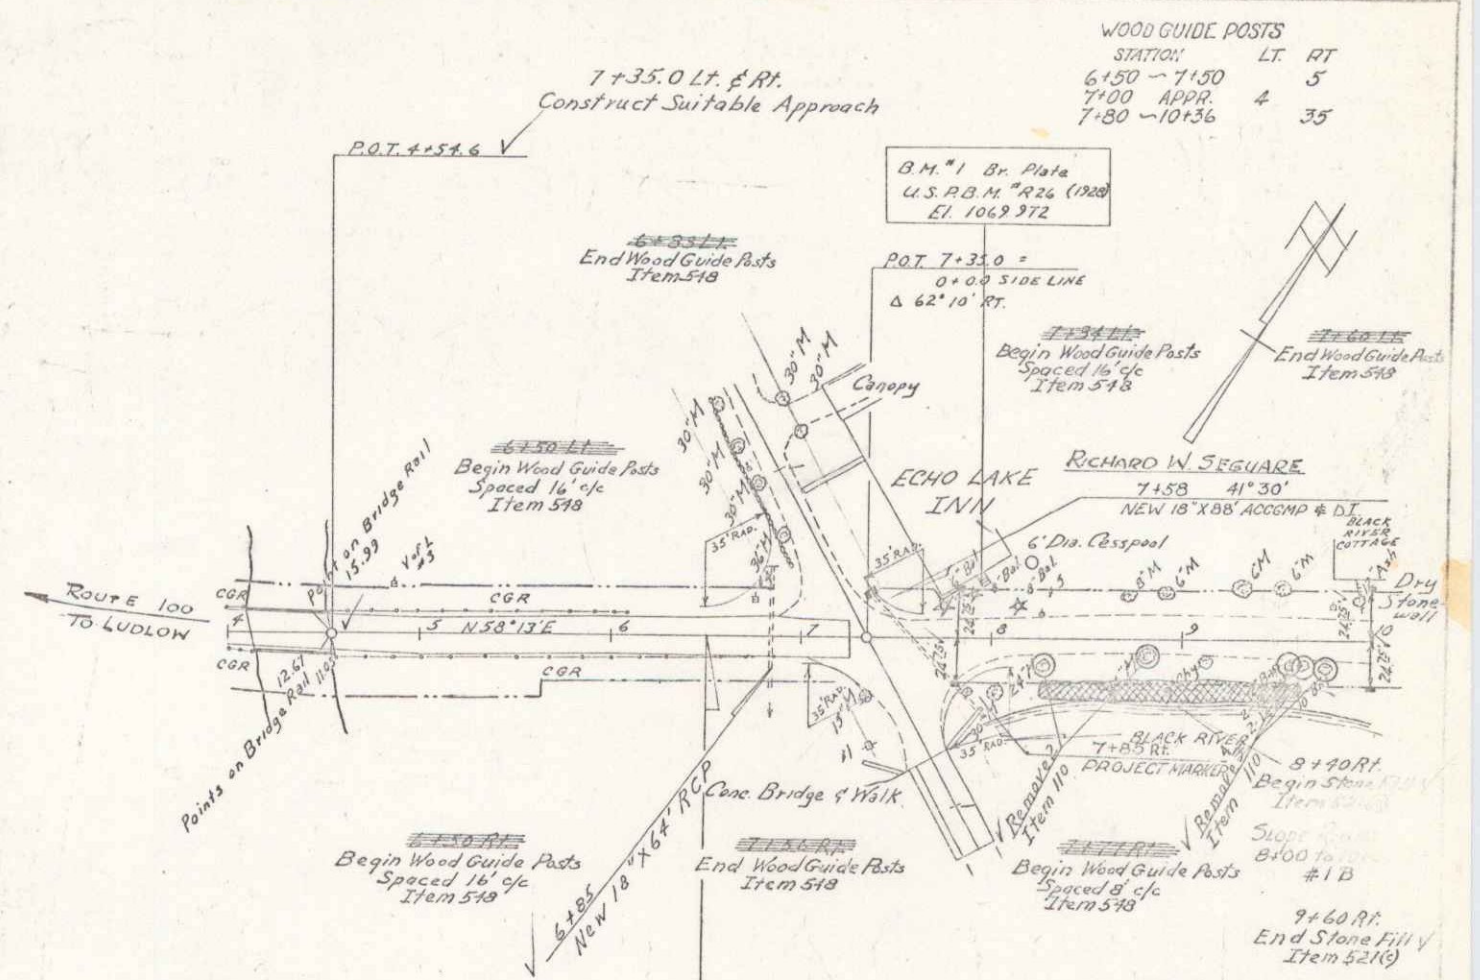

B.M. #1 Bronze Plate U.S.P.B.M. #R-26 (1920) 21' Lt. at Sta. 7+35 Elev. 1069.972