


DATA RELATIVE TO DAM AT OUTLET LAKE AMHERST
 Top Dam - Elev 1075.94
 Top Flashboards - Elev 1069.89
 Top Spillway - Elev 1066.94
 October 1952

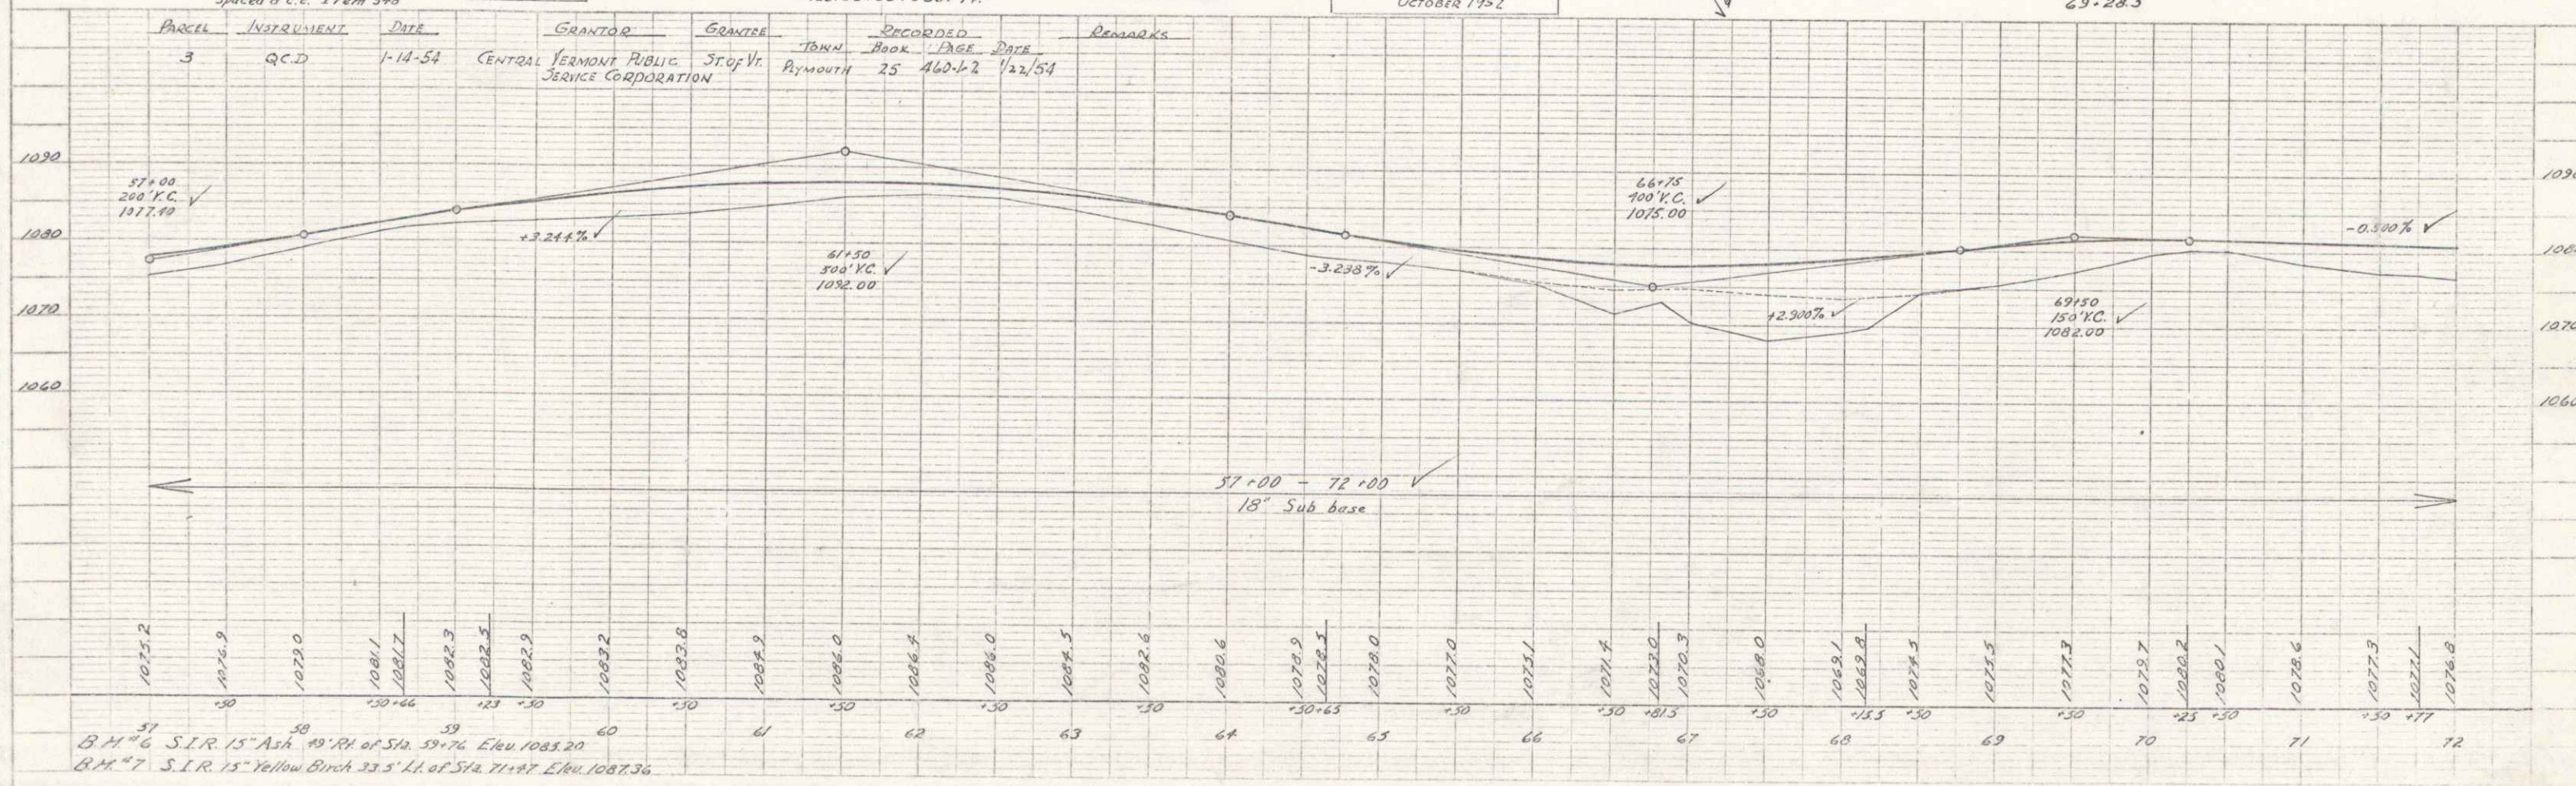

Parcel	Instrument	Date	Grantor	Grantee	Tran. Book	Page	Recorded Date	Remarks
3	Q.C.D.	1-14-54	CENTRAL VERMONT PUBLIC SERVICE CORPORATION	ST of Vt.	Plymouth	25	460-12	1/22/54

B.M. #6 S.I.R. 15" Ash 40' RH of Sta. 59+76 Elev. 1085.20
 B.M. #7 S.I.R. 15" Yellow Birch 33.5' LL of Sta. 71+87 Elev. 1087.36