

PLAN
 DATE: 12-2-53
 DRAWN BY: [Signature]

PROFILE
 DATE: 12-2-53
 DRAWN BY: [Signature]

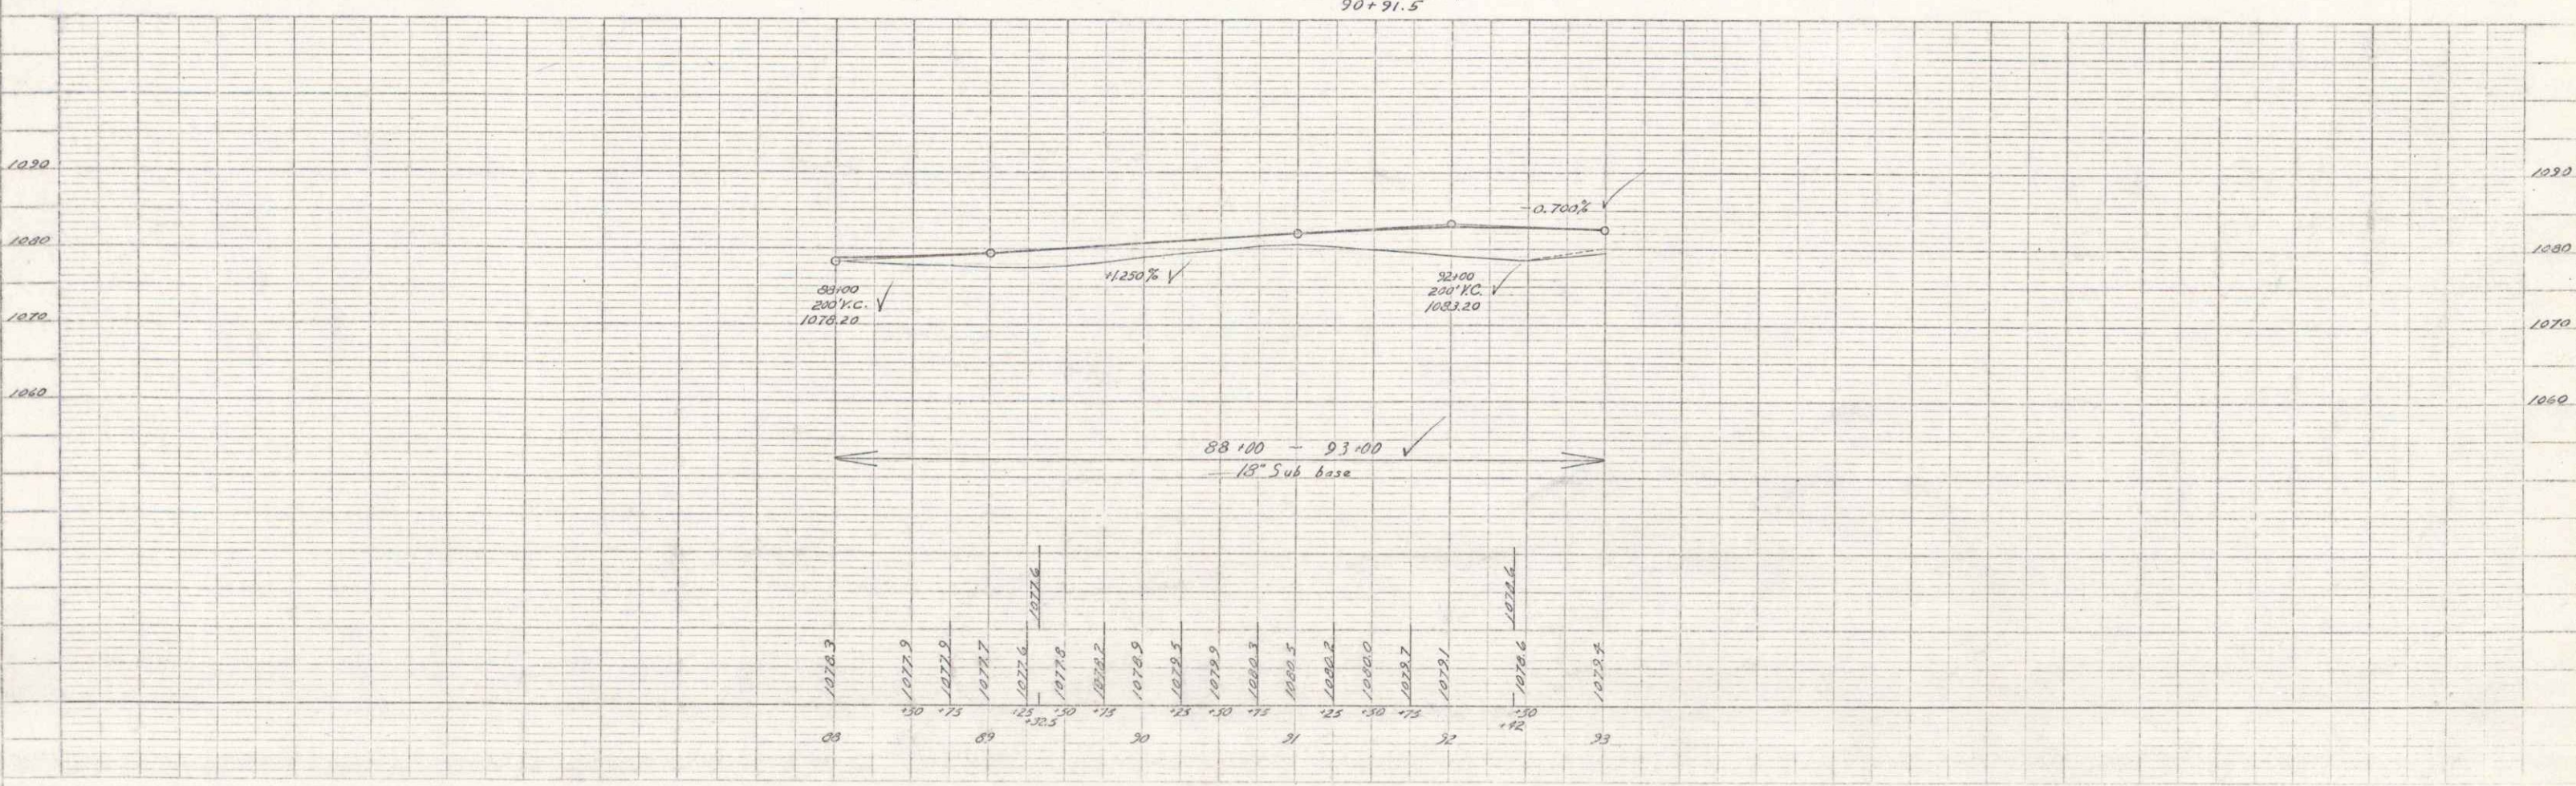
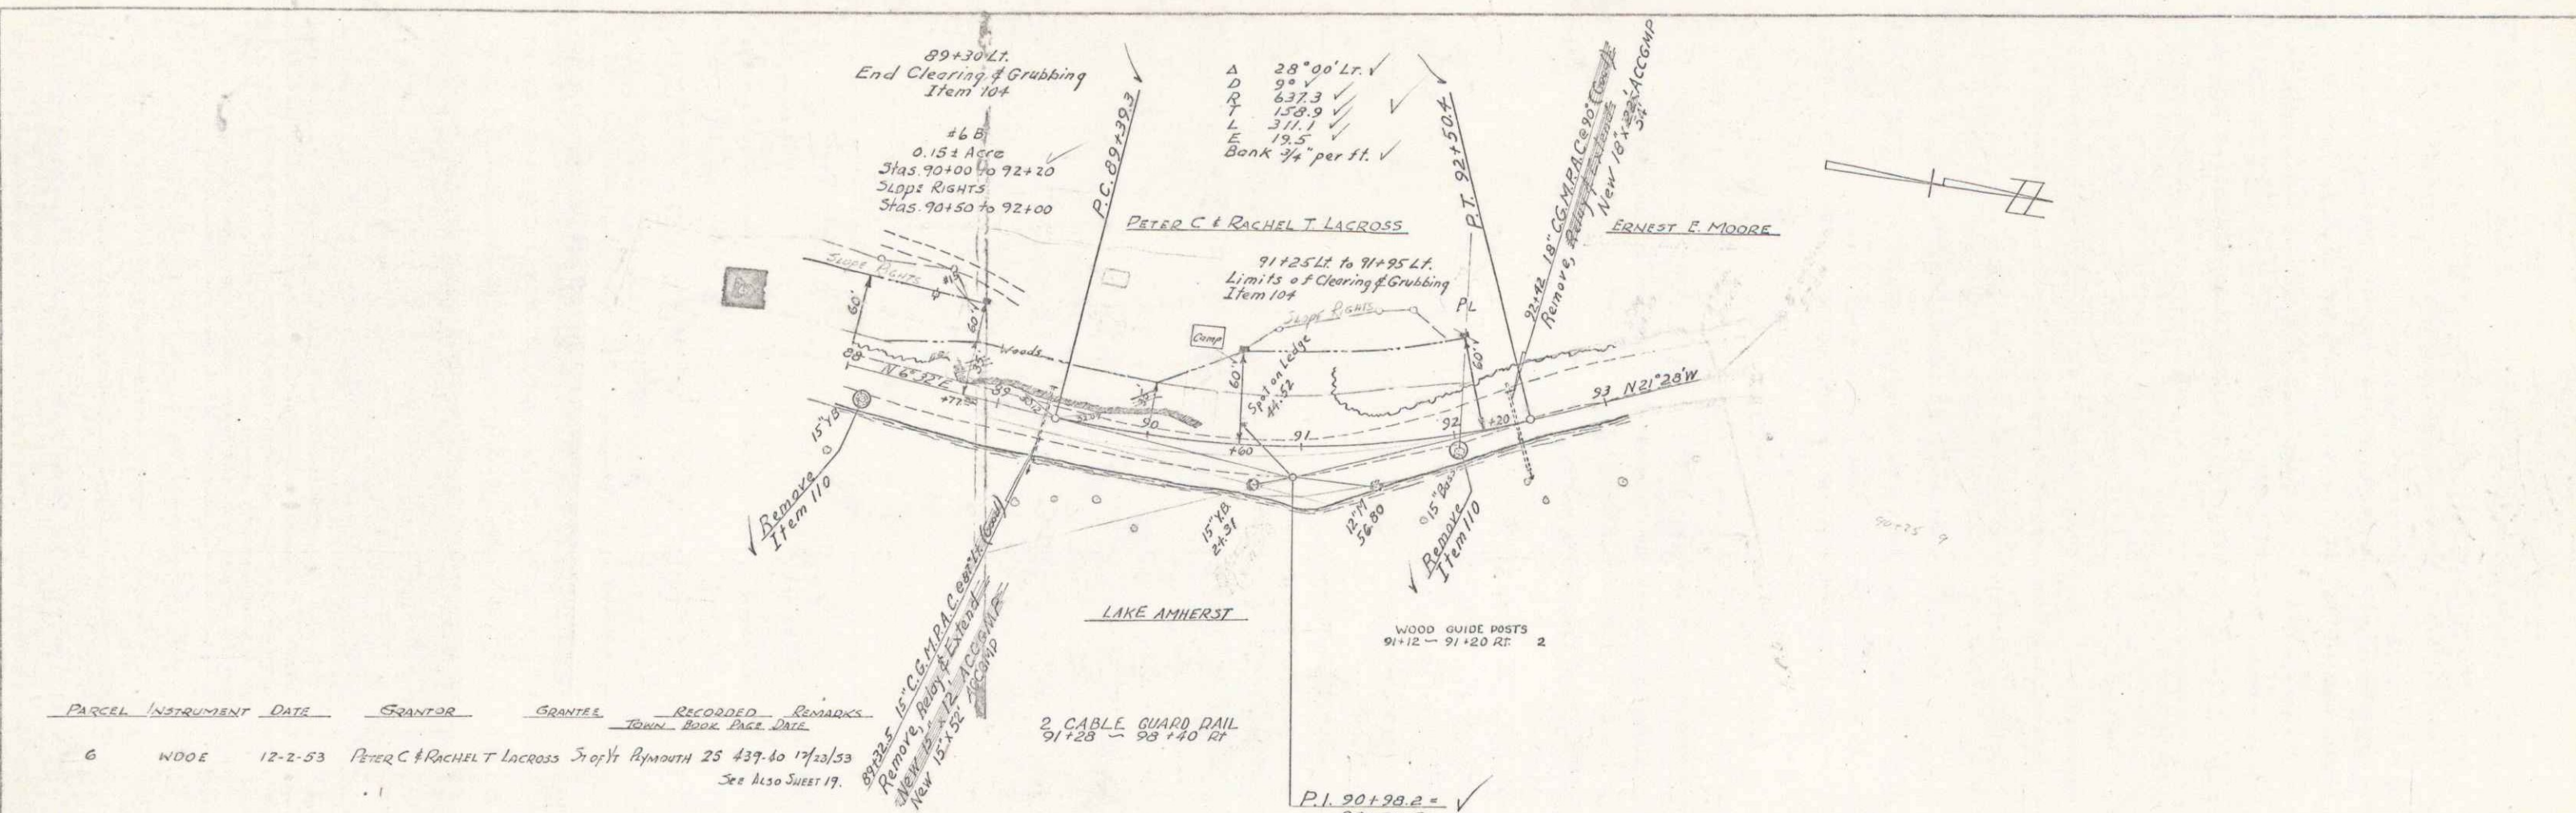


PLATE 1. PLYMOUTH 25 437-40 17/10/53
 DRAWN BY: [Signature]

PLYMOUTH
 Project 5 No 41(1)
 Sheet 20 of 150
 8