
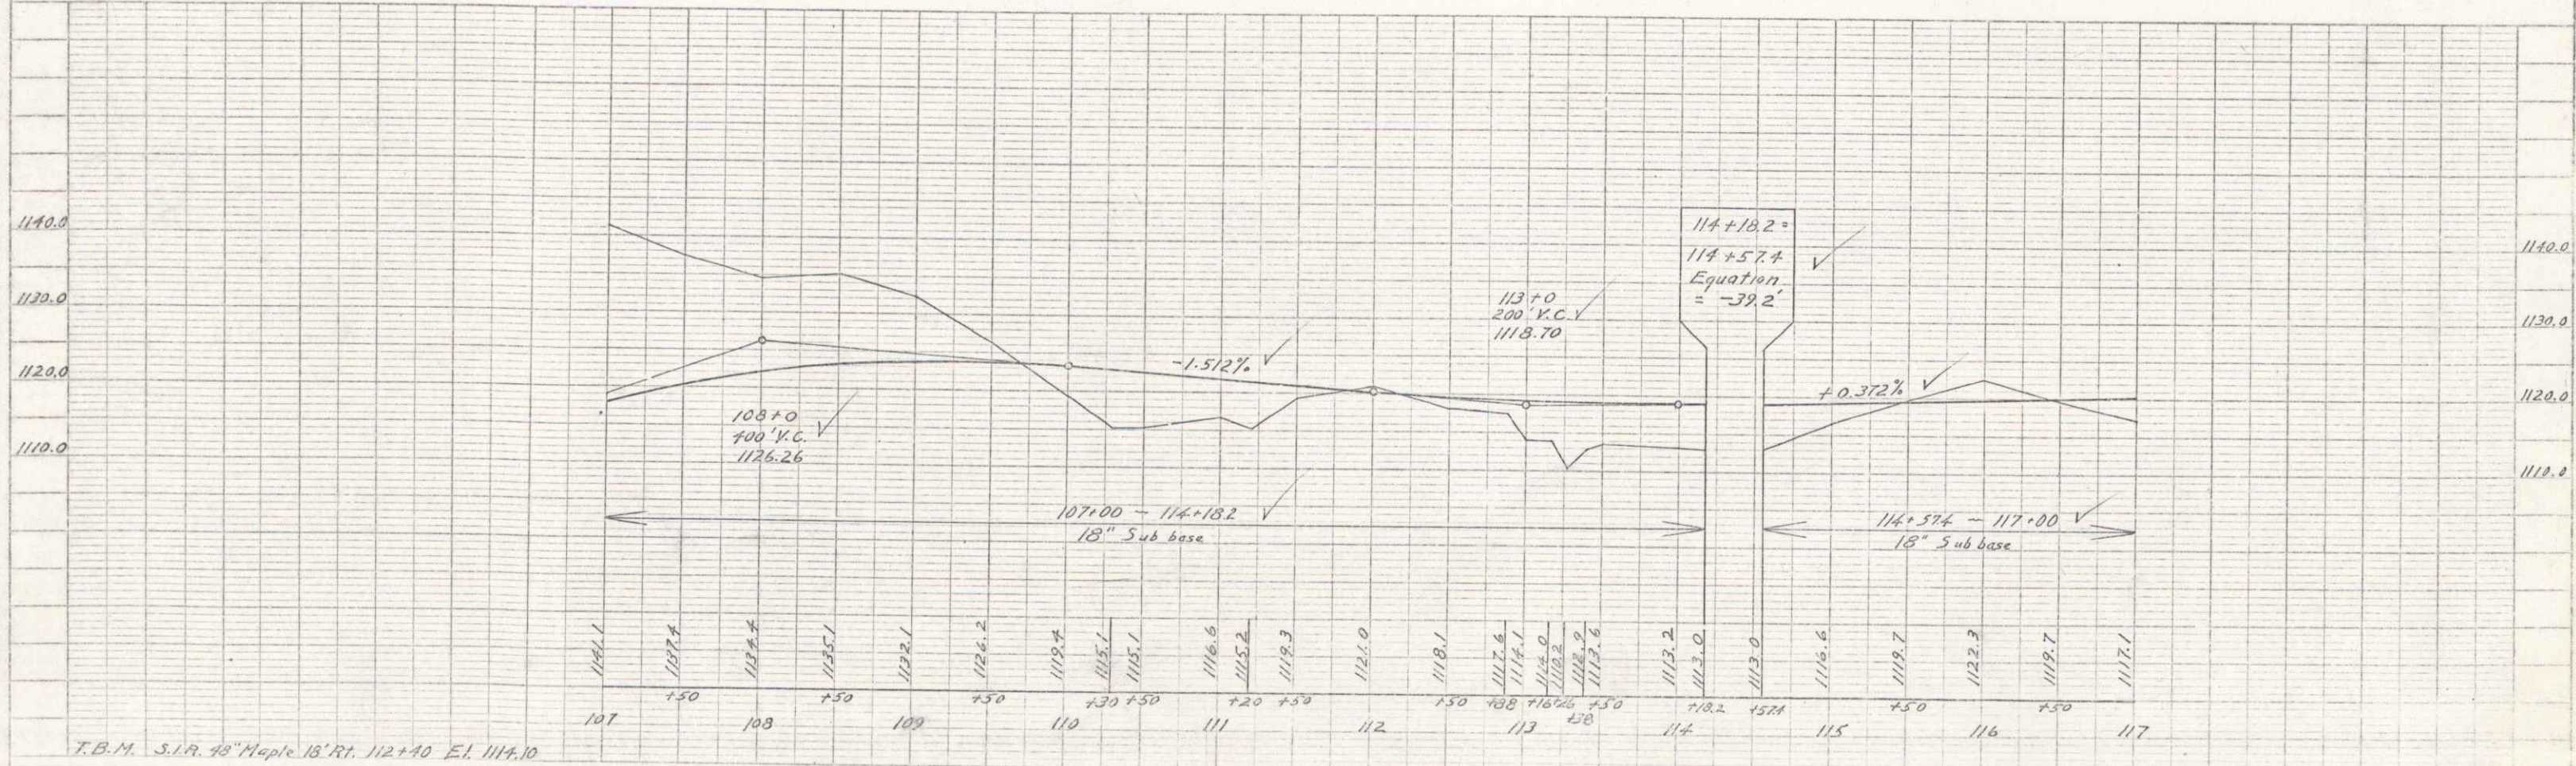


PLAN
 SCALE: AS SHOWN
 DATE: 11/3/53
 DRAWN BY: T.B.M.

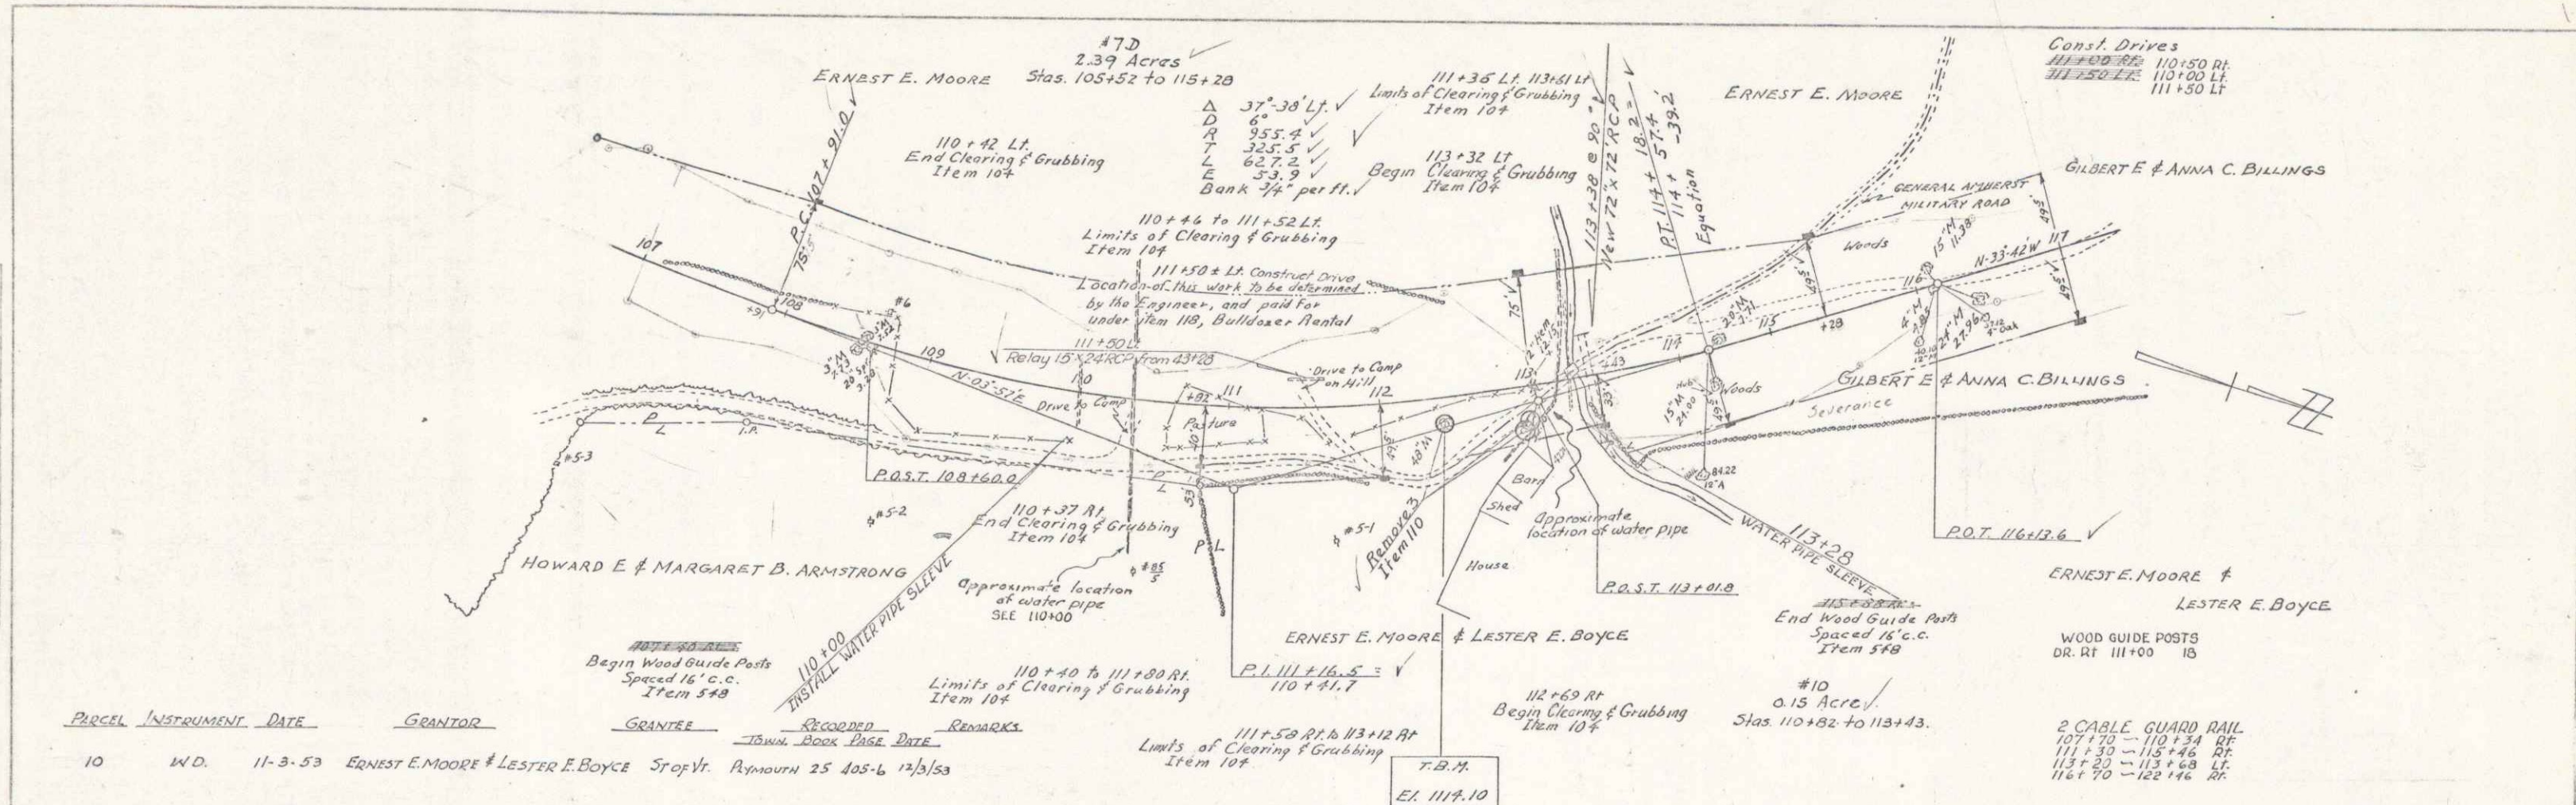

T.B.M. S.L.R. 48" Maple 18' Rt. 112+70 El. 1117.10

PLATE 1 - PROFILE VIEW OF CLEARING DRIVE

PLYMOUTH
 Project S. N. 410
 Sheet 22 of 140
 10