


NO	REMARKS
222	\$4.50 FEE

STATE OF VERMONT
DEPARTMENT OF HIGHWAYS
LUDLOW - WEST BRIDGEWATER ROUTE
VERMONT ROUTE 100

TOWN OF PLYMOUTH
HIGHWAY PROJECT 561
UT 100

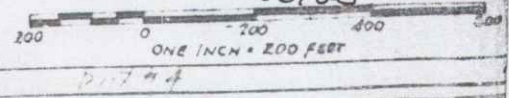

22A