
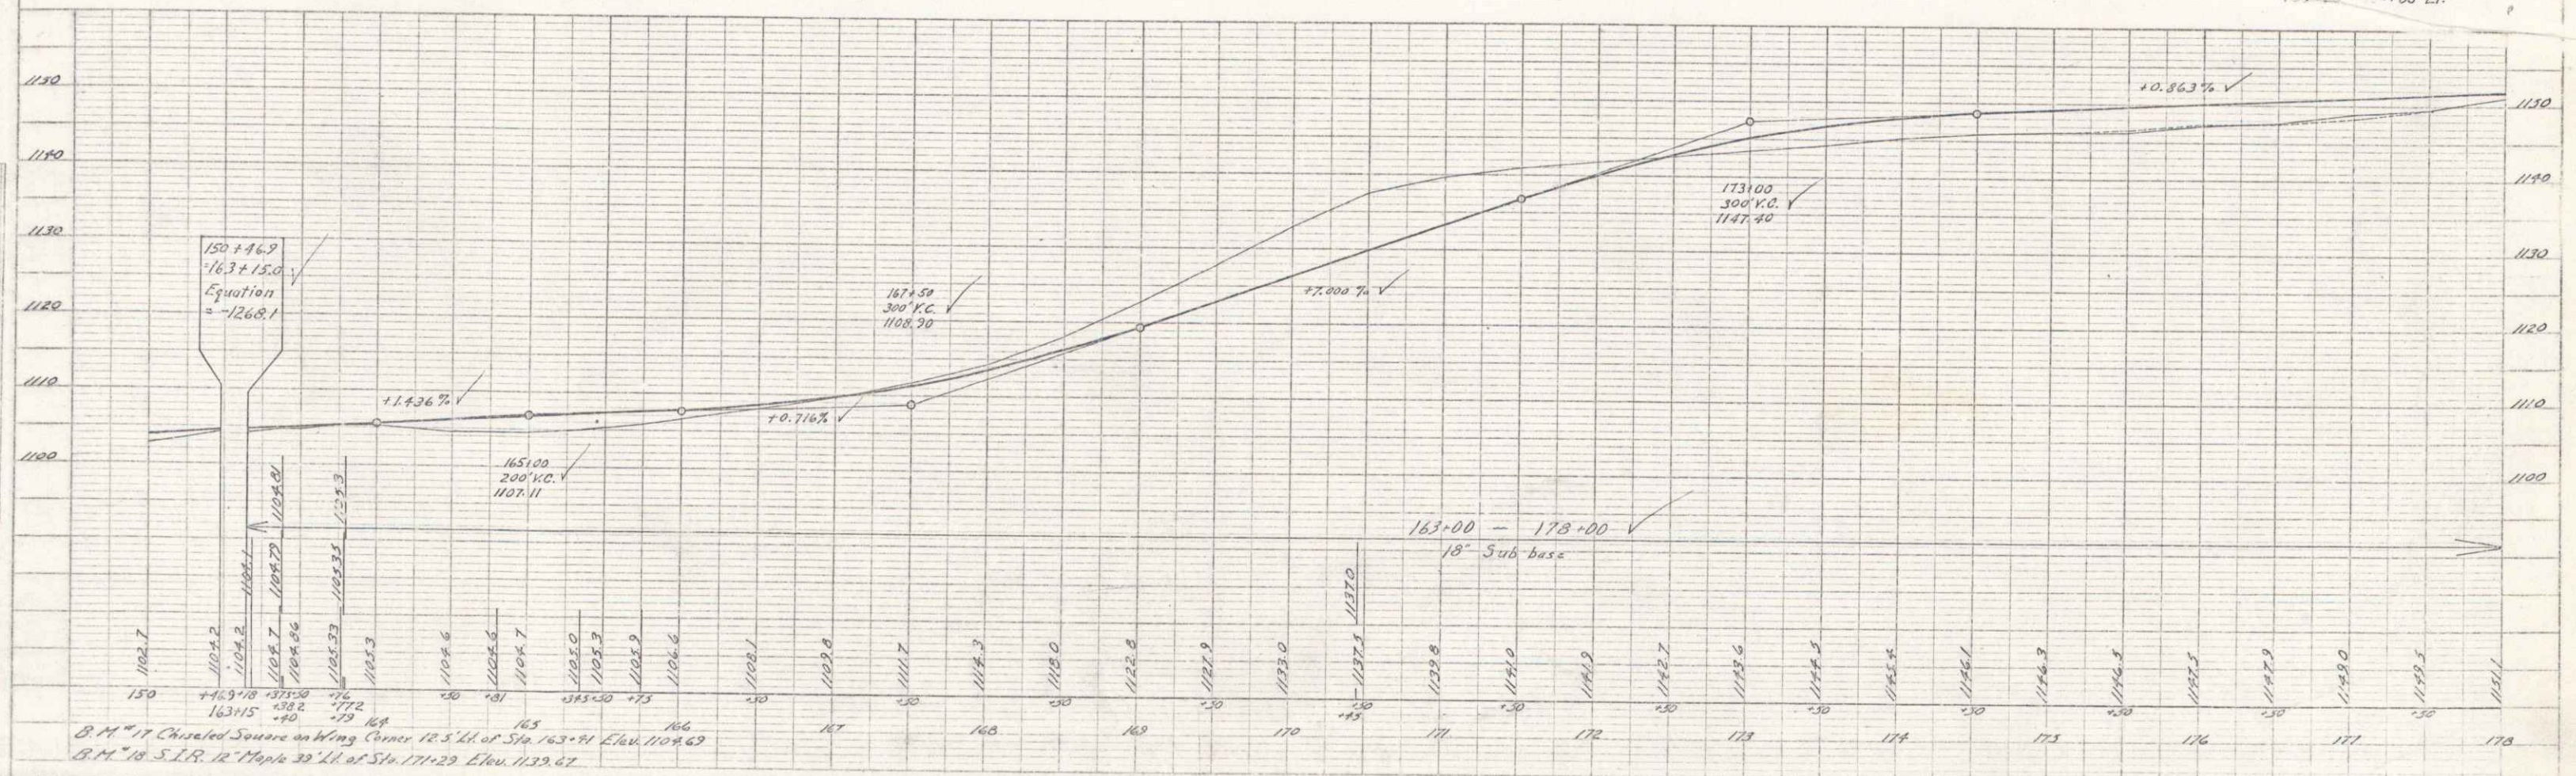


PLAN
 SHEET NO. 26 OF 140
 DATE 11/25/53
 PROJECT NO. 5-2100

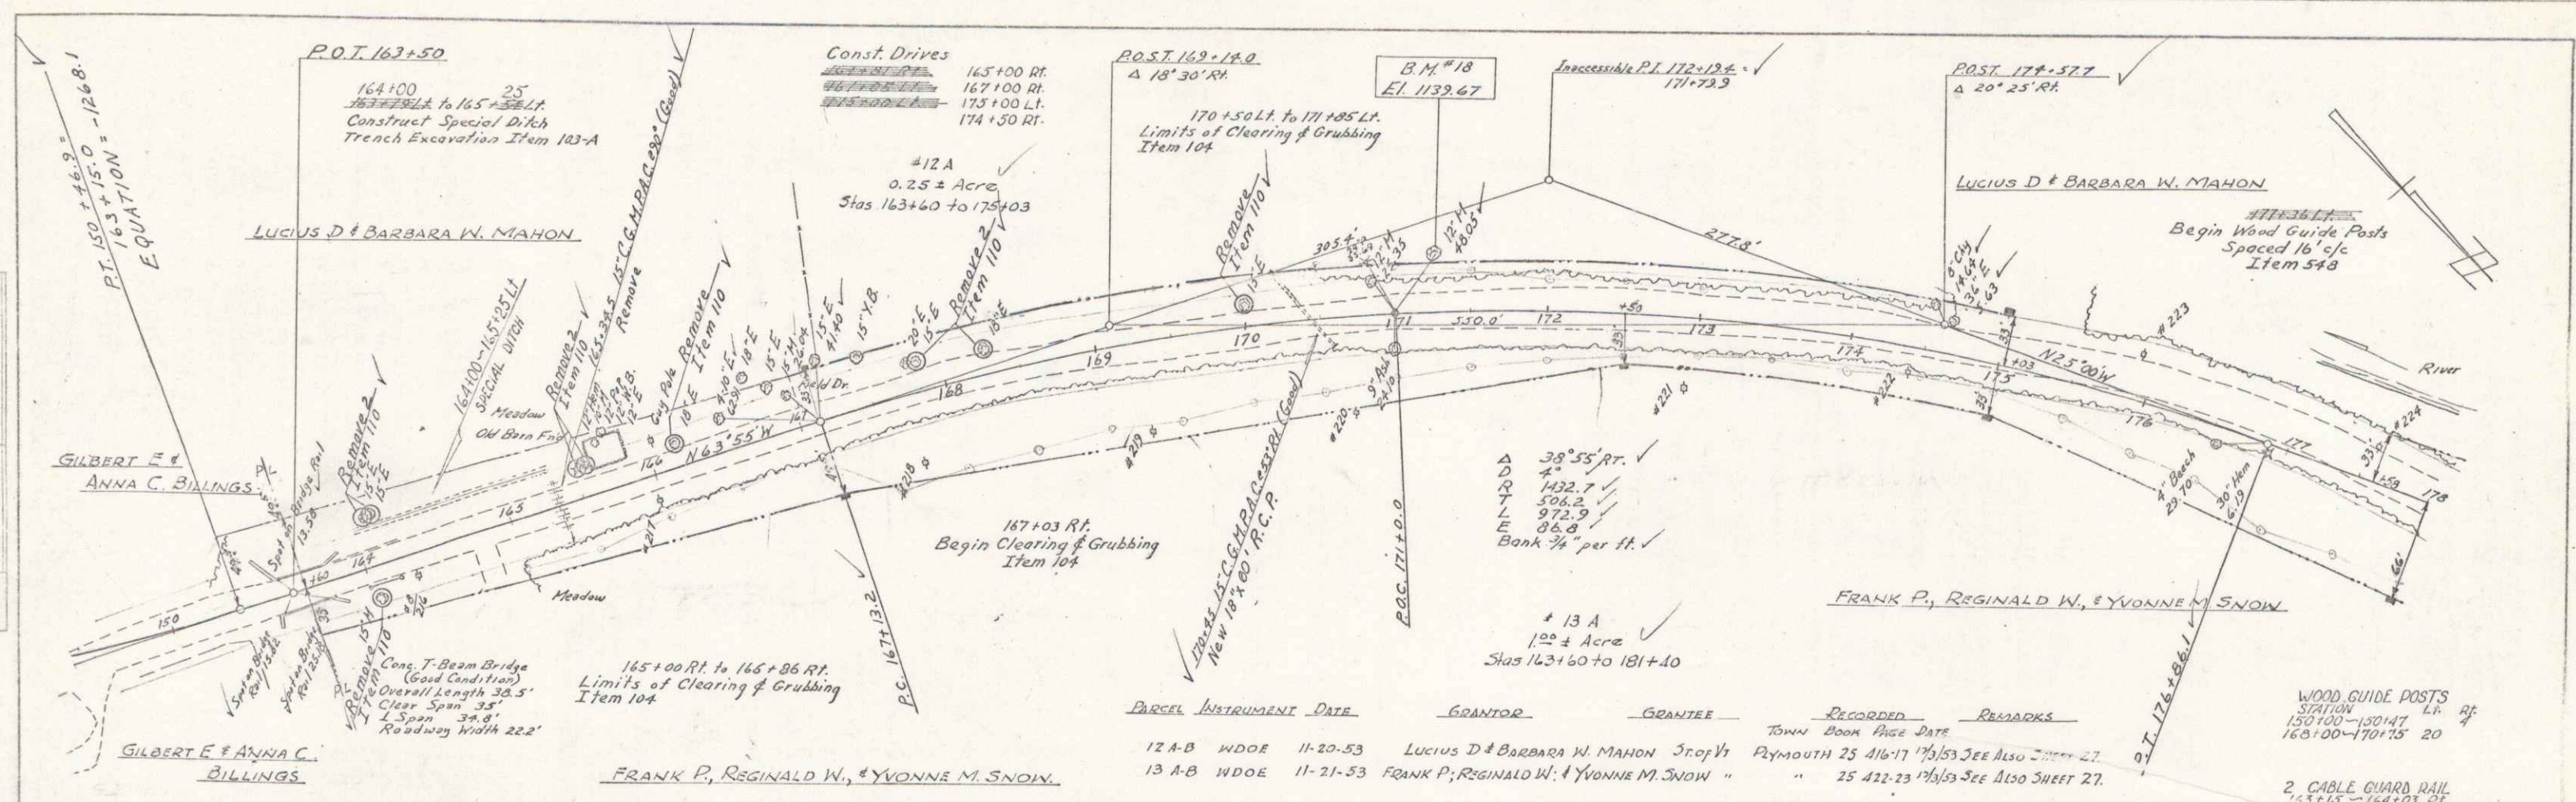

PROFILE
 SHEET NO. 26 OF 140
 DATE 11/25/53
 PROJECT NO. 5-2100

PLATE 1 - PLAN-PROFILE C.P. & S. GRADING
 REPORT & RECORD OF NEW ROAD
 BY R. E. FAY, INC.

Plymouth
 Project 5-2100
 Sheet 26 of 140
 16