
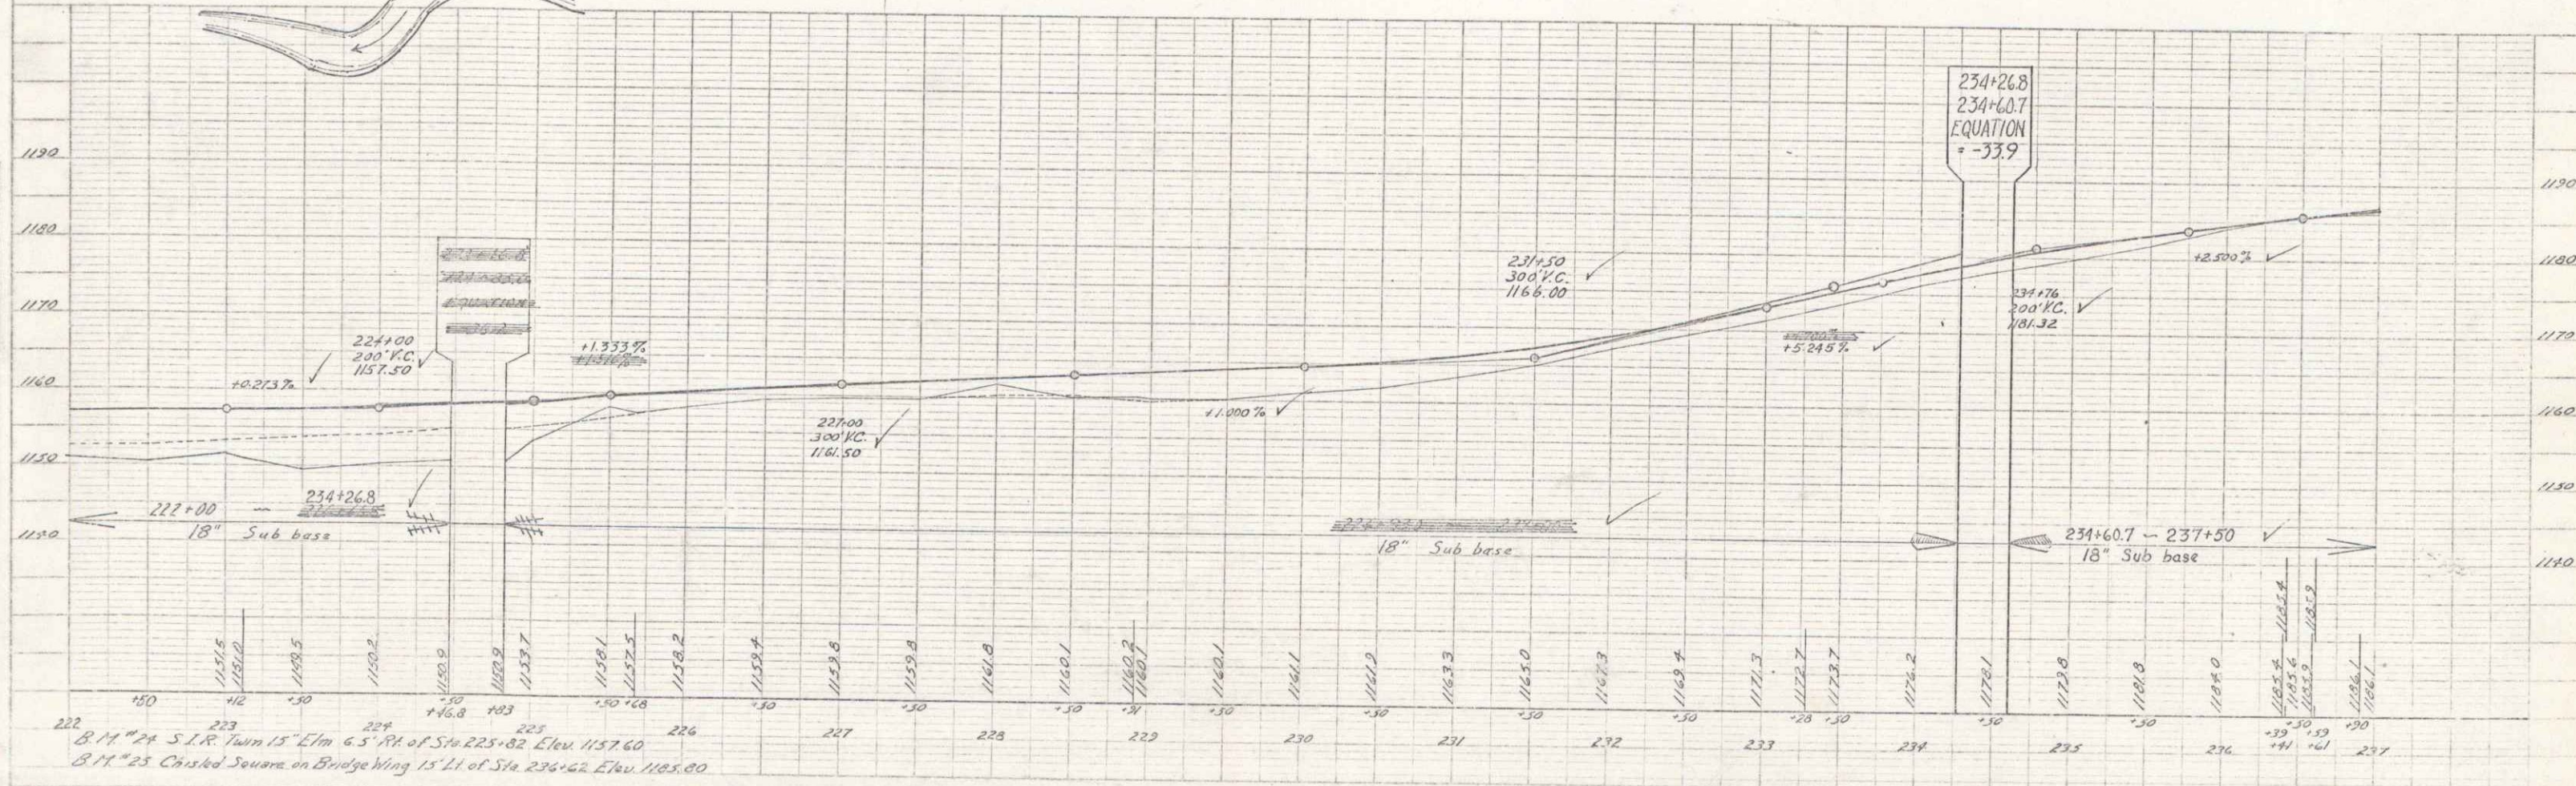


PLAN
 DIVISION OF HIGHWAYS
 BUREAU OF HIGHWAYS
 STATE OF MASSACHUSETTS
 PROJECT NO. 41(1)
 SHEET NO. 30 OF 110

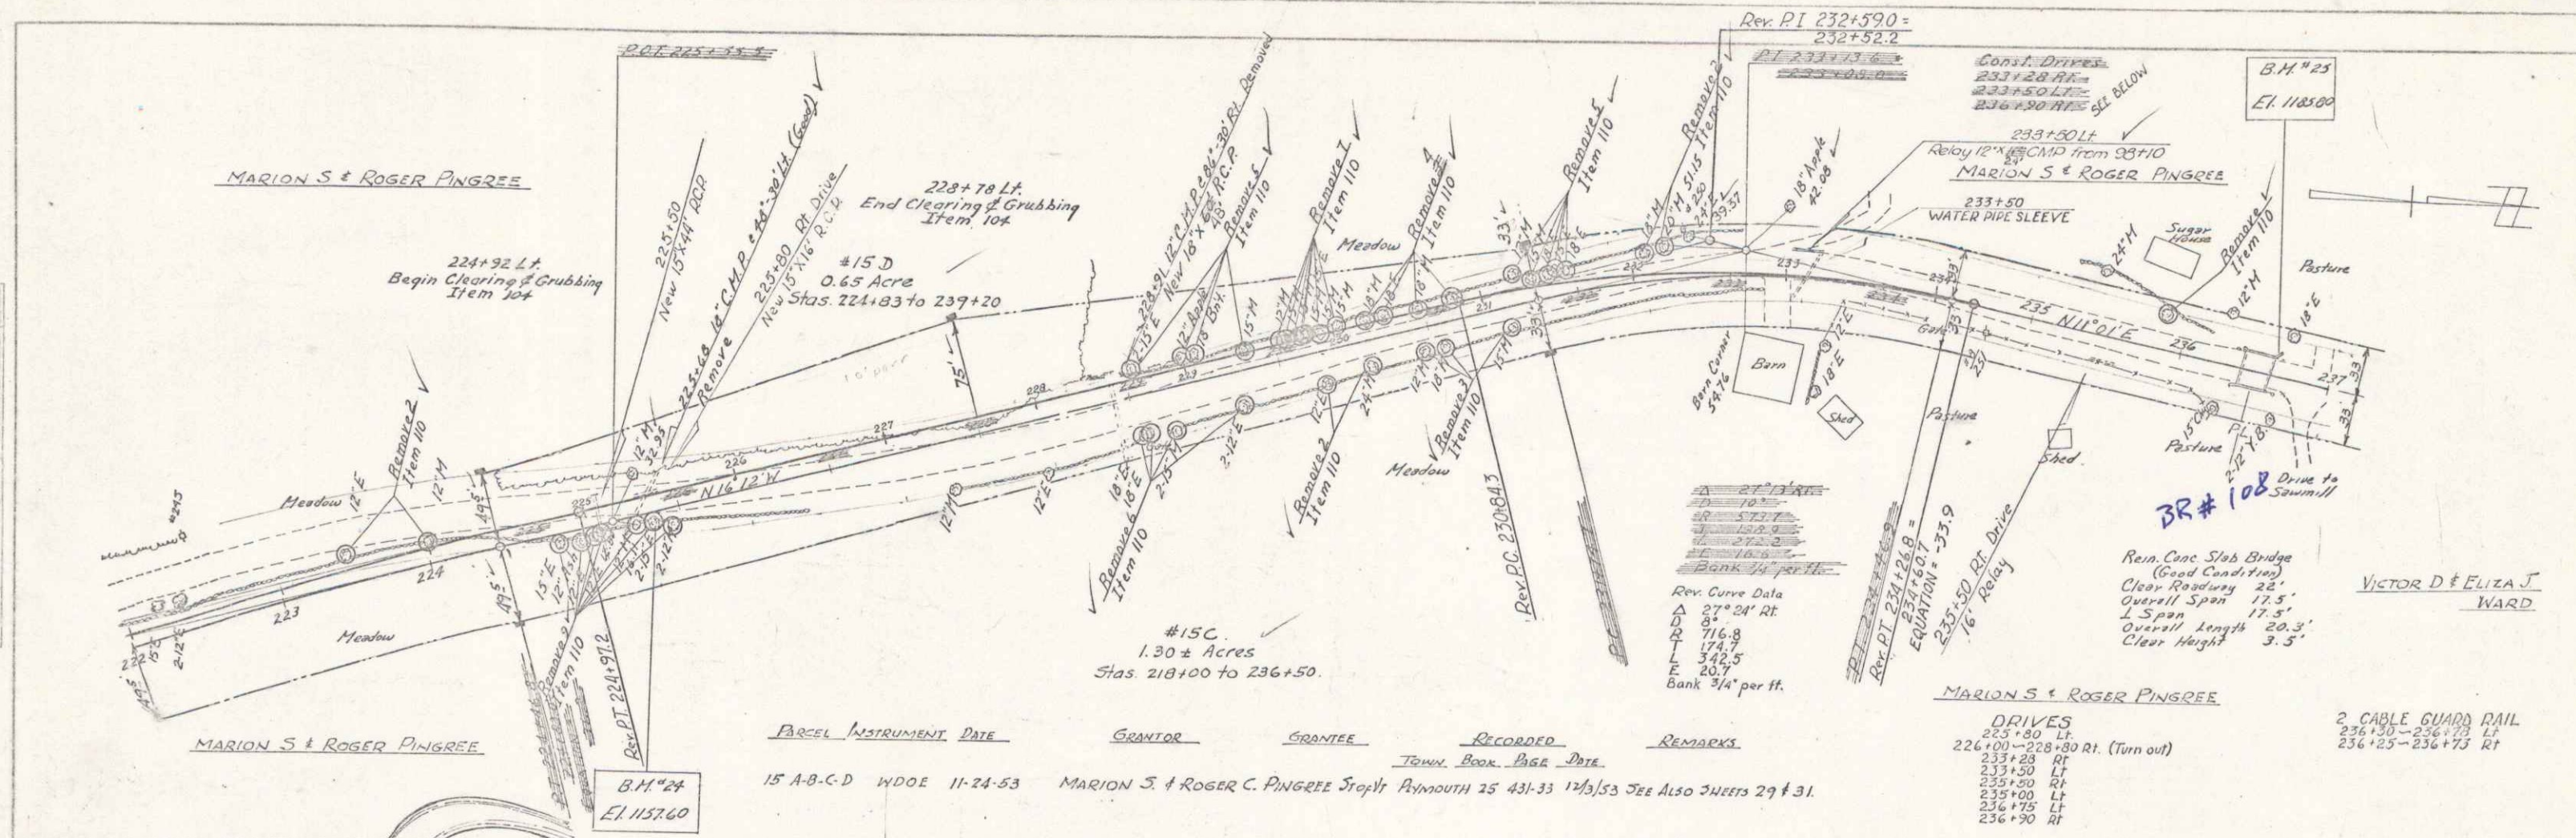

PLYMOUTH
 Project S. N. 41(1)
 Sheet 30 of 110
 20