
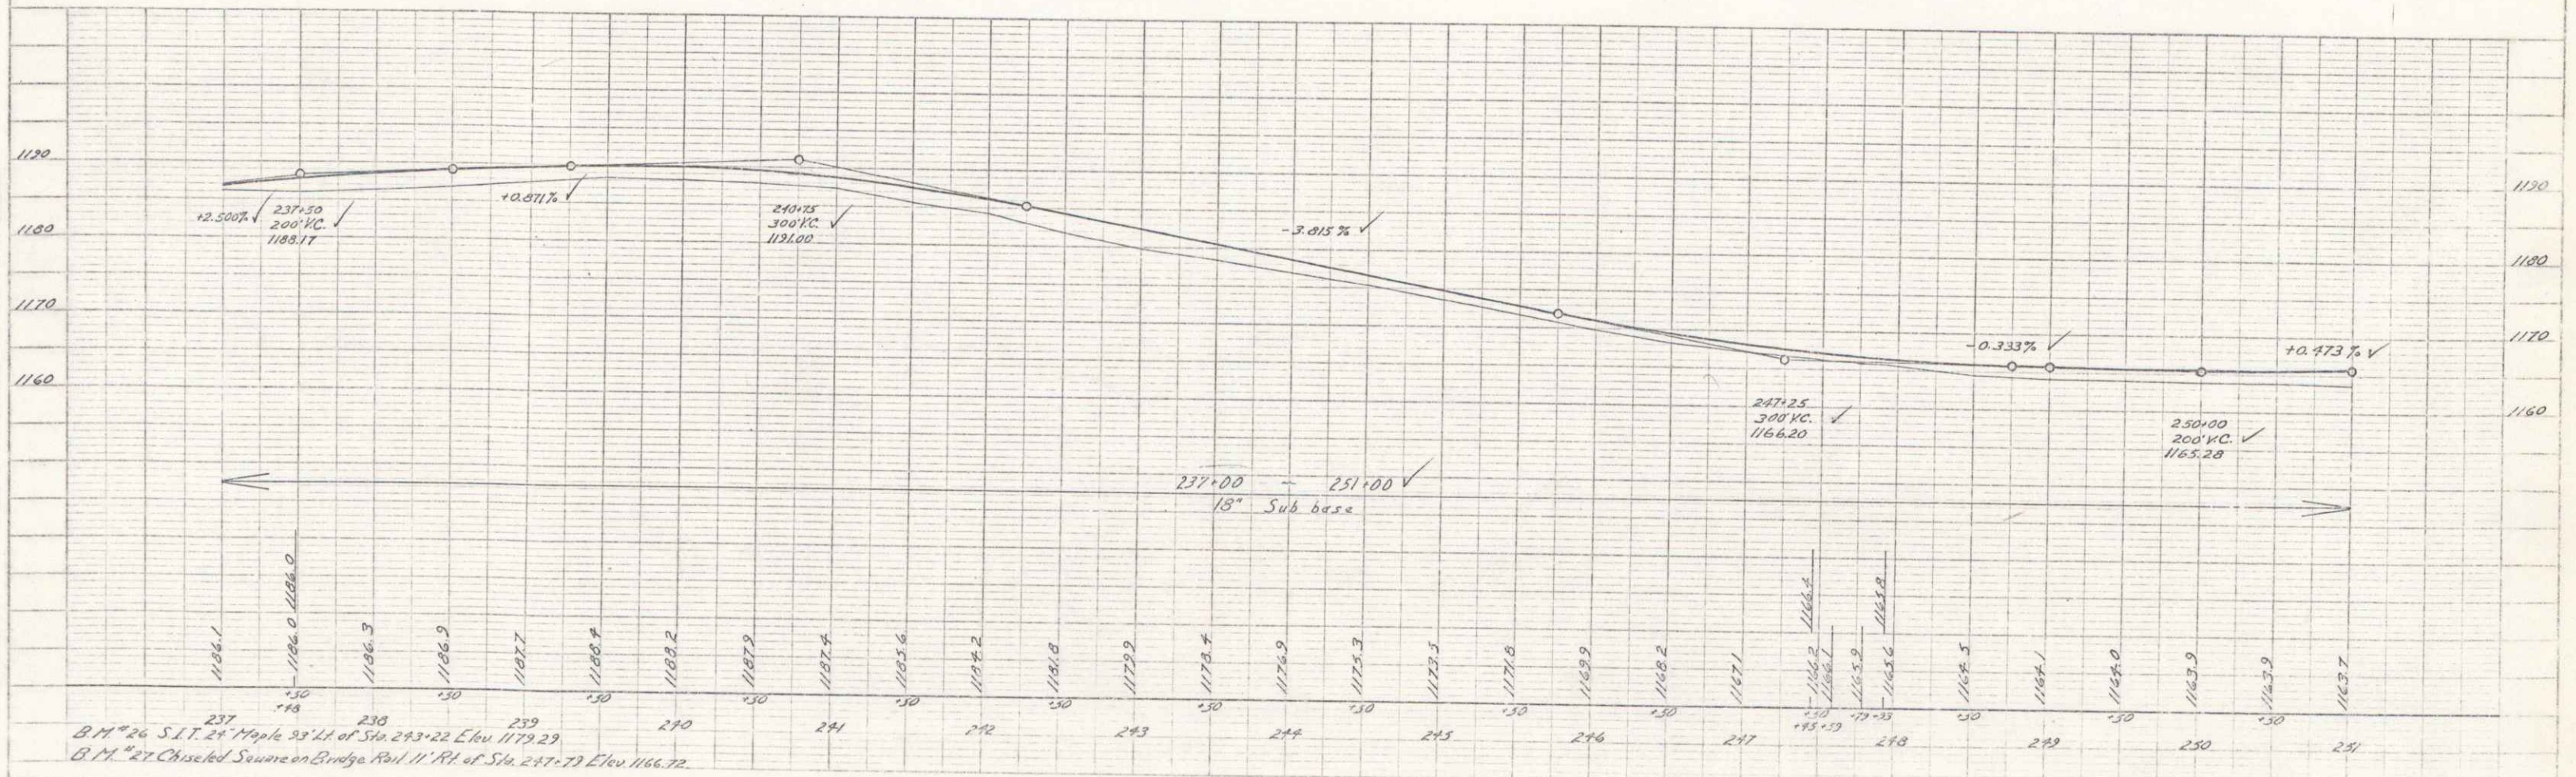


PLAN
 DATE: 10/25/23
 DRAWN BY: [Signature]
 CHECKED BY: [Signature]

PROFILE
 DATE: 10/25/23
 DRAWN BY: [Signature]
 CHECKED BY: [Signature]

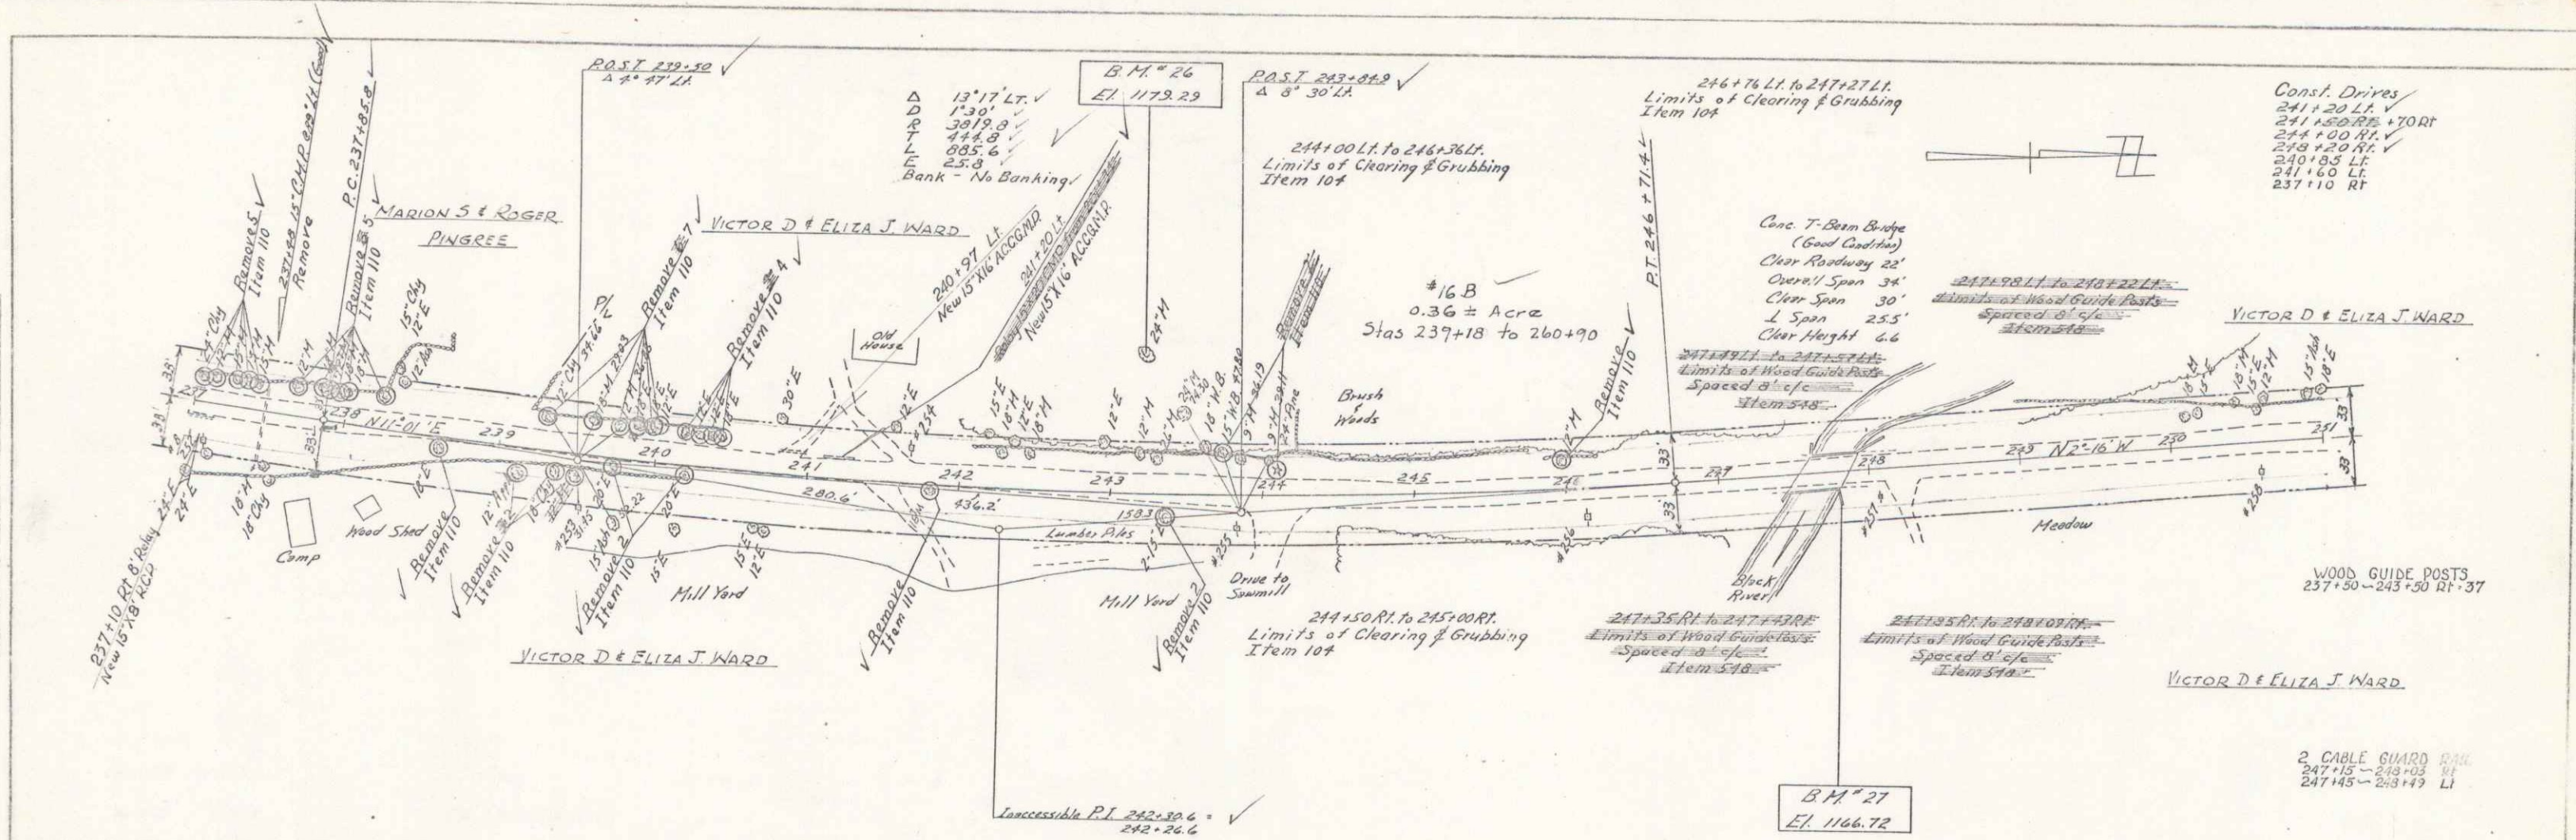

B.M. #26 S.I.T. 24 Maple 33' LT. of Sta. 243+22 El. 1179.29
 B.M. #27 Chiseled Swaine on Bridge Rail 11' RT. of Sta. 247+77 El. 1166.72

PLYMOUTH PROJECT 5 No 41(1) SHEET 31 OF 100

PLYMOUTH
 Project 5 No 41(1)
 Sheet 31 of 100
 21