


6014
 Plymouth
 6014

INDEX OF SHEETS

SHEET NO.	TITLE PAGE
1	TITLE PAGE
2	TYPICAL CROSS SECTION OF IMPROVEMENT (SINGLE TACK COAT OF REFINED TAR AND BLADE MIX)
3	STANDARD SHEET B-1 (BANKING)
4	QUANTITY SHEET (ITEMS)
5	QUANTITY SHEET (DRAINAGE)
6-7	EARTHWORK SHEETS
8-11	PLAN & PROFILE SHEETS
12	DETAILS OF ABUTMENTS "1" & "2" BRIDGE STA 314+28 - 315+12
13	REINFORCING STEEL SCHEDULE (BRIDGE STA 314+28 - 315+12)
14	SUPERSTRUCTURE DETAILS BRIDGE STA 329+07 - 329+37
15	DETAILS OF ABUTMENT "1"
16	DETAILS OF ABUTMENT "2"
17	BRIDGE STD. SHEET SIB-30 (H-20) MODIFIED 84' SPAN
18	BRIDGE STD. SHEET SB-5C-1 (TWO CABLE GUARD RAIL)
19	BRIDGE STD. SHEET SB-20-56, DETS A, B, C, D, E, F OR G.
20	STANDARD SHEET B-5 (TYPICAL SLOPE GRADING)
21	STANDARD SHEET B-6 (MUCK EXCAVATION)
22	STANDARD SHEET D-1 (P.R.C.P. DROP INLETS)
23	STANDARD SHEET D-2 (HEADWALLS & UNDERDRAIN)
24	STANDARD SHEET E-1 (BARRICADES, SIGNS, & LIGHTS)
25	STANDARD SHEET G-2 (TWO CABLE GUARD RAIL) and G-2b
26	STANDARD SHEET G-4 (GUIDE POSTS & MARKER POSTS)
27	STANDARD SHEET J-1 (MARKERS)
28-45	CROSS SECTIONS
46-48	CHANNEL SECTIONS

STATE OF VERMONT
DEPARTMENT OF HIGHWAYS
PROPOSED IMPROVEMENT
TOWN OF PLYMOUTH
COUNTY OF WINDSOR
LUDLOW - W. BRIDGEWATER ROAD
VERMONT ROUTE 100

FEDERAL AID SECONDARY PROJECT
 BEGINNING AT THE INTERSECTION OF VT. ROUTES 100 & 100A IN THE HAMLET OF PLYMOUTH UNION AND EXTENDING NORTHERLY 1.021 MILES
 LENGTH OF ROADWAY 5,275.8 FT. = 0.999 MILES
 LENGTH OF BRIDGES 114.0 FT. = 0.022 MILES
 LENGTH OF PROJECT 5,389.8 FT. = 1.021 MILES

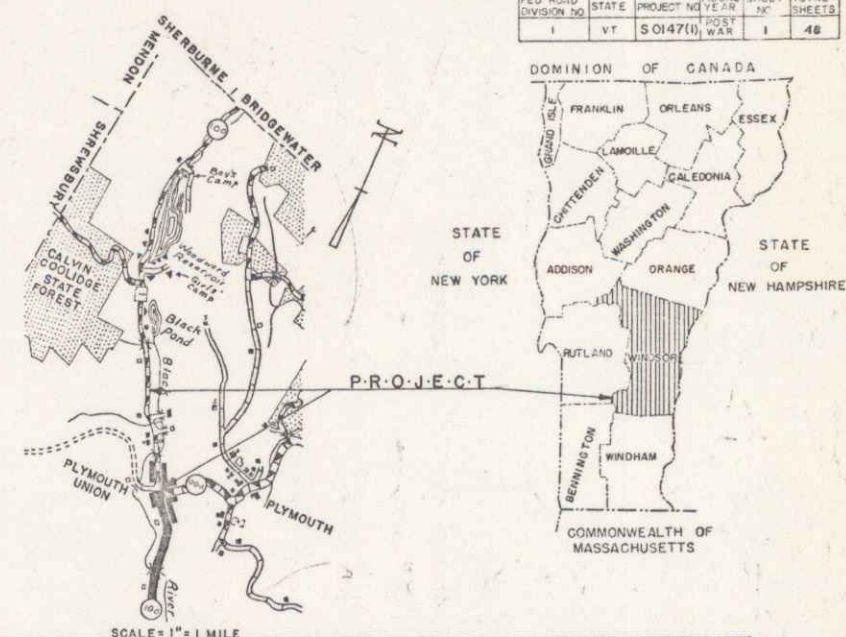

PROJECT NAME & NUMBER	TYPE	PAVEMENT AREA
PLYMOUTH S 0147(1) SA	SINGLE TACK COAT OF REFINED TAR & BLADE MIX FEA STONE SEAL W/CUTBACK ASPHALT.	12,905 SY


RECORD PLANS

MATERIALS

GRANULAR BORROW - MOORE PIT - PLYMOUTH, VERMONT.
 SUBBASE OF GRAVEL & GRAVEL BACKFILL - MOORE PIT & BILLINGS PIT - PLYMOUTH, VERMONT.
 REFINED TAR - OLD COLONY TAR CO. - WORCESTER, MASSACHUSETTS.
 CUTBACK ASPHALT - MOBIL OIL CO. - PROVIDENCE, RHODE ISLAND.
 PEA STONE - TWIN STATE SAND & GRAVEL CO. - W. LEBANON, NEW HAMPSHIRE.
 REINF. CONC. PIPE, PREC. REINF. CONC. PIPE DROP INLETS W/COVERS & GRATES - VERMONT CONCRETE PIPE CO. - WINDSOR, VERMONT.
 CONCRETE CLASS "B" - JOSEPH P. CARRARA - RUTLAND, VERMONT.
 BITUMINOUS CONCRETE - ELACKTOP INC. - W. LEBANON, NEW HAMPSHIRE.
 REINF. STEEL - VT. STRUCTURAL STEEL CO. - BURLINGTON, VT.
 STRUCTURAL STEEL - A. LEO NASH STEEL CORR. - PITTSFIELD, MASS.
 TREATED TIMBER PILING - KOPPERS CO. - CONCORD, N. H.
 CABLE GUARD RAIL, WOOD GUIDE & MARKER POSTS - ST. GRISWOLD & CO. INC. - ESSEX JUNCTION, VERMONT.
 CONTRACTORS - E. R. PUTNAM & SAILER BROTHERS - PLYMOUTH & BRIDGEWATER CORNERS, VT.
 RESIDENT ENGINEER - EARL NEWTON | RECORD PLANS - E. NEWTON & F. WIMBLE.
 INSPECTOR - G. REED.

BENCH MARKS ARE BASED UPON U.S.G.S. ELEVATIONS

1959 ADT 230
1980 ADT 340
1980 DHV 75
D 68%
T 6%
V 40

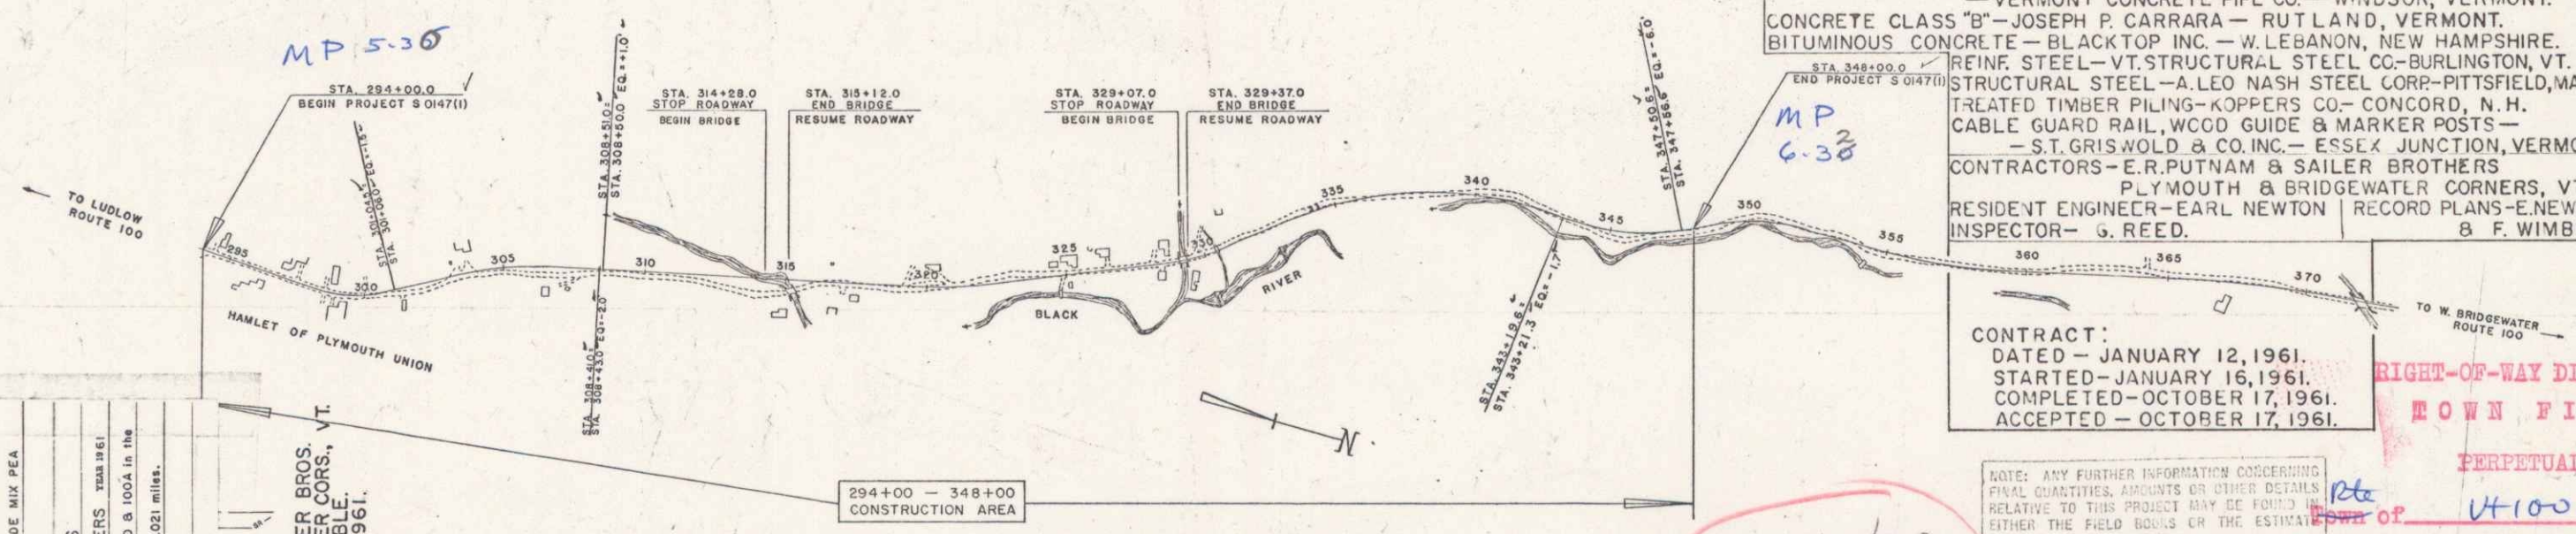

CONTRACT:
 DATED - JANUARY 12, 1961.
 STARTED - JANUARY 16, 1961.
 COMPLETED - OCTOBER 17, 1961.
 ACCEPTED - OCTOBER 17, 1961.

RIGHT-OF-WAY DIVISION
 TOWN FILE
 PERPETUAL

NOTE: ANY FURTHER INFORMATION CONCERNING FINAL QUANTITIES, AMOUNTS OR OTHER DETAILS RELATIVE TO THIS PROJECT MAY BE FOUND IN EITHER THE FIELD BOOKS OR THE ESTIMATE FILE.

To Be Returned To R.O.W. Division

DATE: 09/29/1960
 P.N. 00R615

PLYMOUTH
 PROJECT S 0147(1) SA
 THIS SINGLE TACK COAT OF REFINED TAR & BLADE MIX FEA STONE SEAL WITH CUTBACK ASPHALT.
 CONSULTORS: E. R. PUTNAM & SAILER BROTHERS
 PLYMOUTH & BRIDGEWATER CORNERS, VT.
 Location Beginning at the intersection of Vt. Routes 100 & 100A in the Hamlet of Plymouth Union and extending northerly 1.021 miles.

PLYMOUTH - S 0147(1) SA
 CONTRACTORS - E. R. PUTNAM & SAILER BROS., PLYMOUTH & BRIDGEWATER CORNERS, VT.
 CONST. COMPLETED - OCTOBER 17, 1961.

SCALES

TITLE	1" = 300'
TYPICAL	1" = 2'
PLAN	1" = 50'
PROFILE	HORIZONTAL 1" = 50'
	VERTICAL 1" = 10'
CROSS-SECTIONS	1" = 5'

APPROVED: [Signature] DATE: Nov 29, 1960 SECONDARY ENGINEER	APPROVED: [Signature] DATE: Nov 29, 1960 CONSTRUCTION ENGINEER	APPROVED: [Signature] DATE: Nov 29, 1960 BRIDGE ENGINEER	APPROVED: [Signature] DATE: Nov 29, 1960 DISTRICT ENGINEER	APPROVED: [Signature] DATE: Nov 29, 1960 ALDER ENGINEER	APPROVED: [Signature] DATE: Nov 29, 1960 CHIEF ENGINEER
--	---	---	---	--	--

DEPARTMENT OF COMMERCE
 BUREAU OF PUBLIC ROADS

APPROVED: [Signature] DATE: []
 DIVISION ENGINEER

PROJECT S NO. 0147(1) SA
 SHEET 1 OF SHEETS 48