
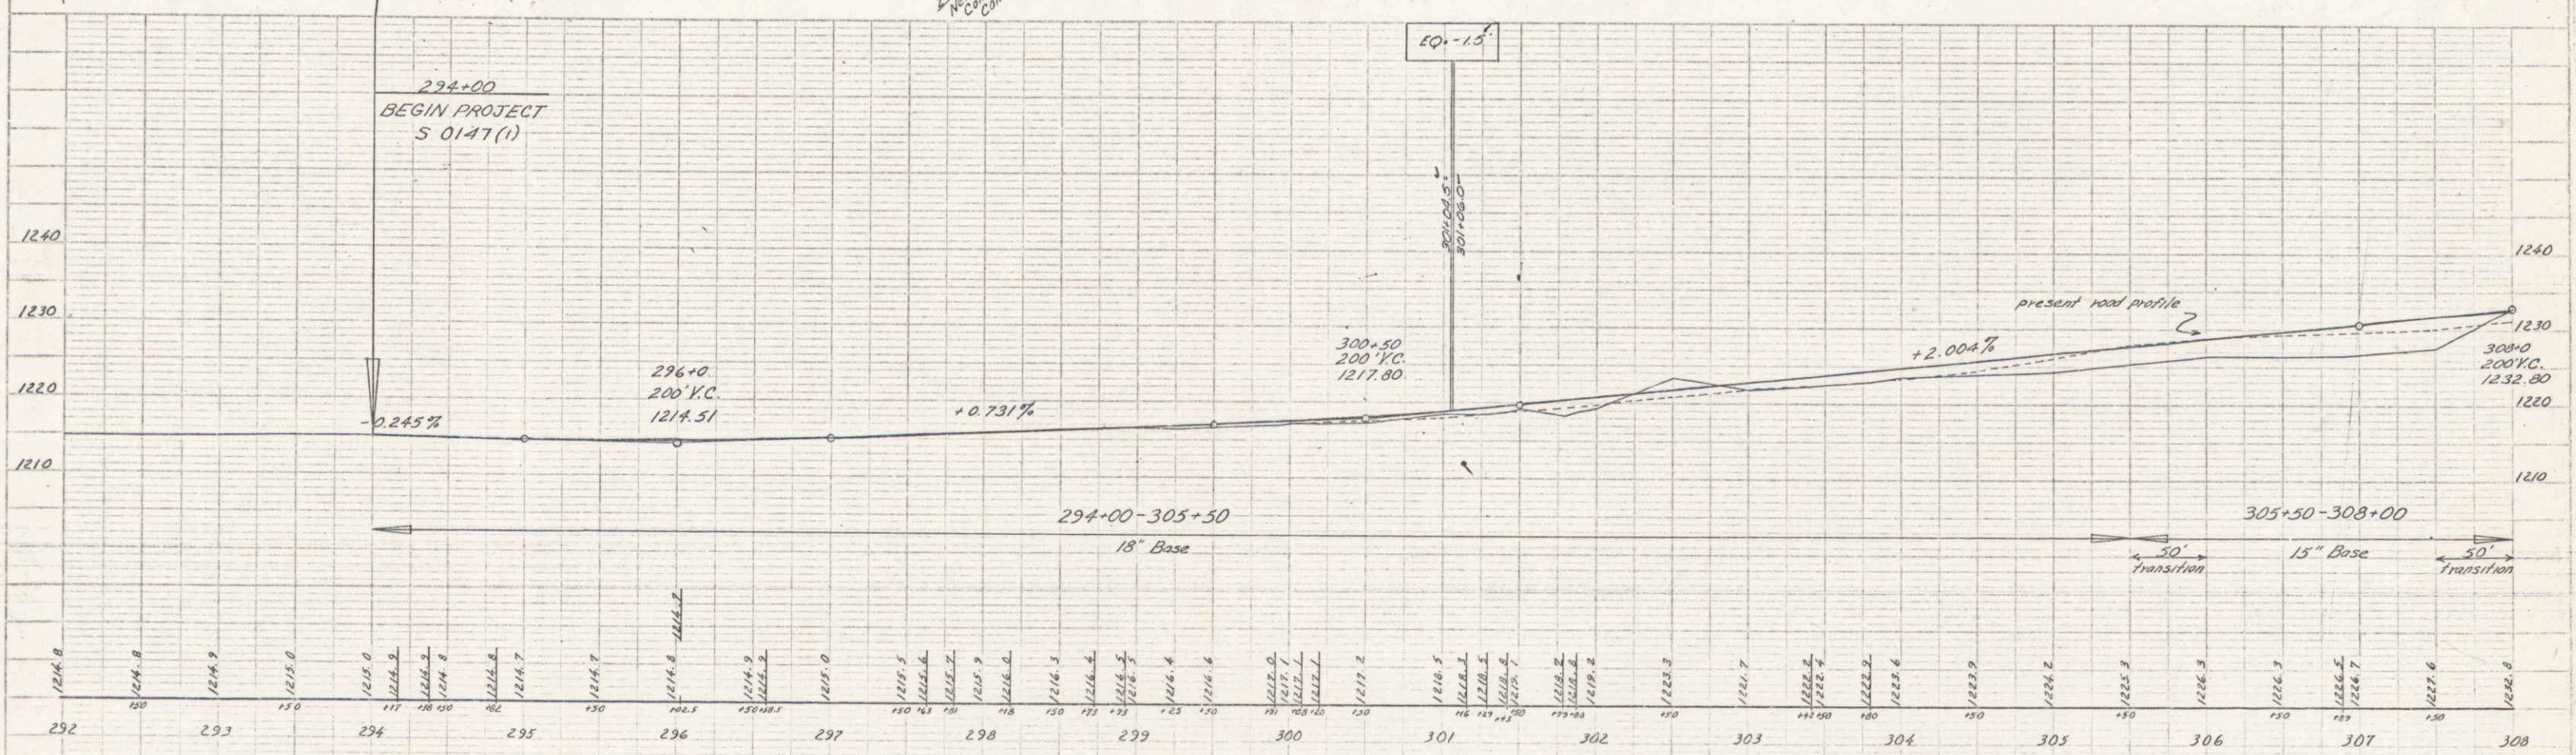


PLAN  
 DATE: 10/15/54  
 DRAWN BY: H. B. BROWN  
 CHECKED BY: H. B. BROWN  
 SCALE: AS SHOWN

PROFILE  
 DATE: 10/15/54  
 DRAWN BY: H. B. BROWN  
 CHECKED BY: H. B. BROWN  
 SCALE: AS SHOWN

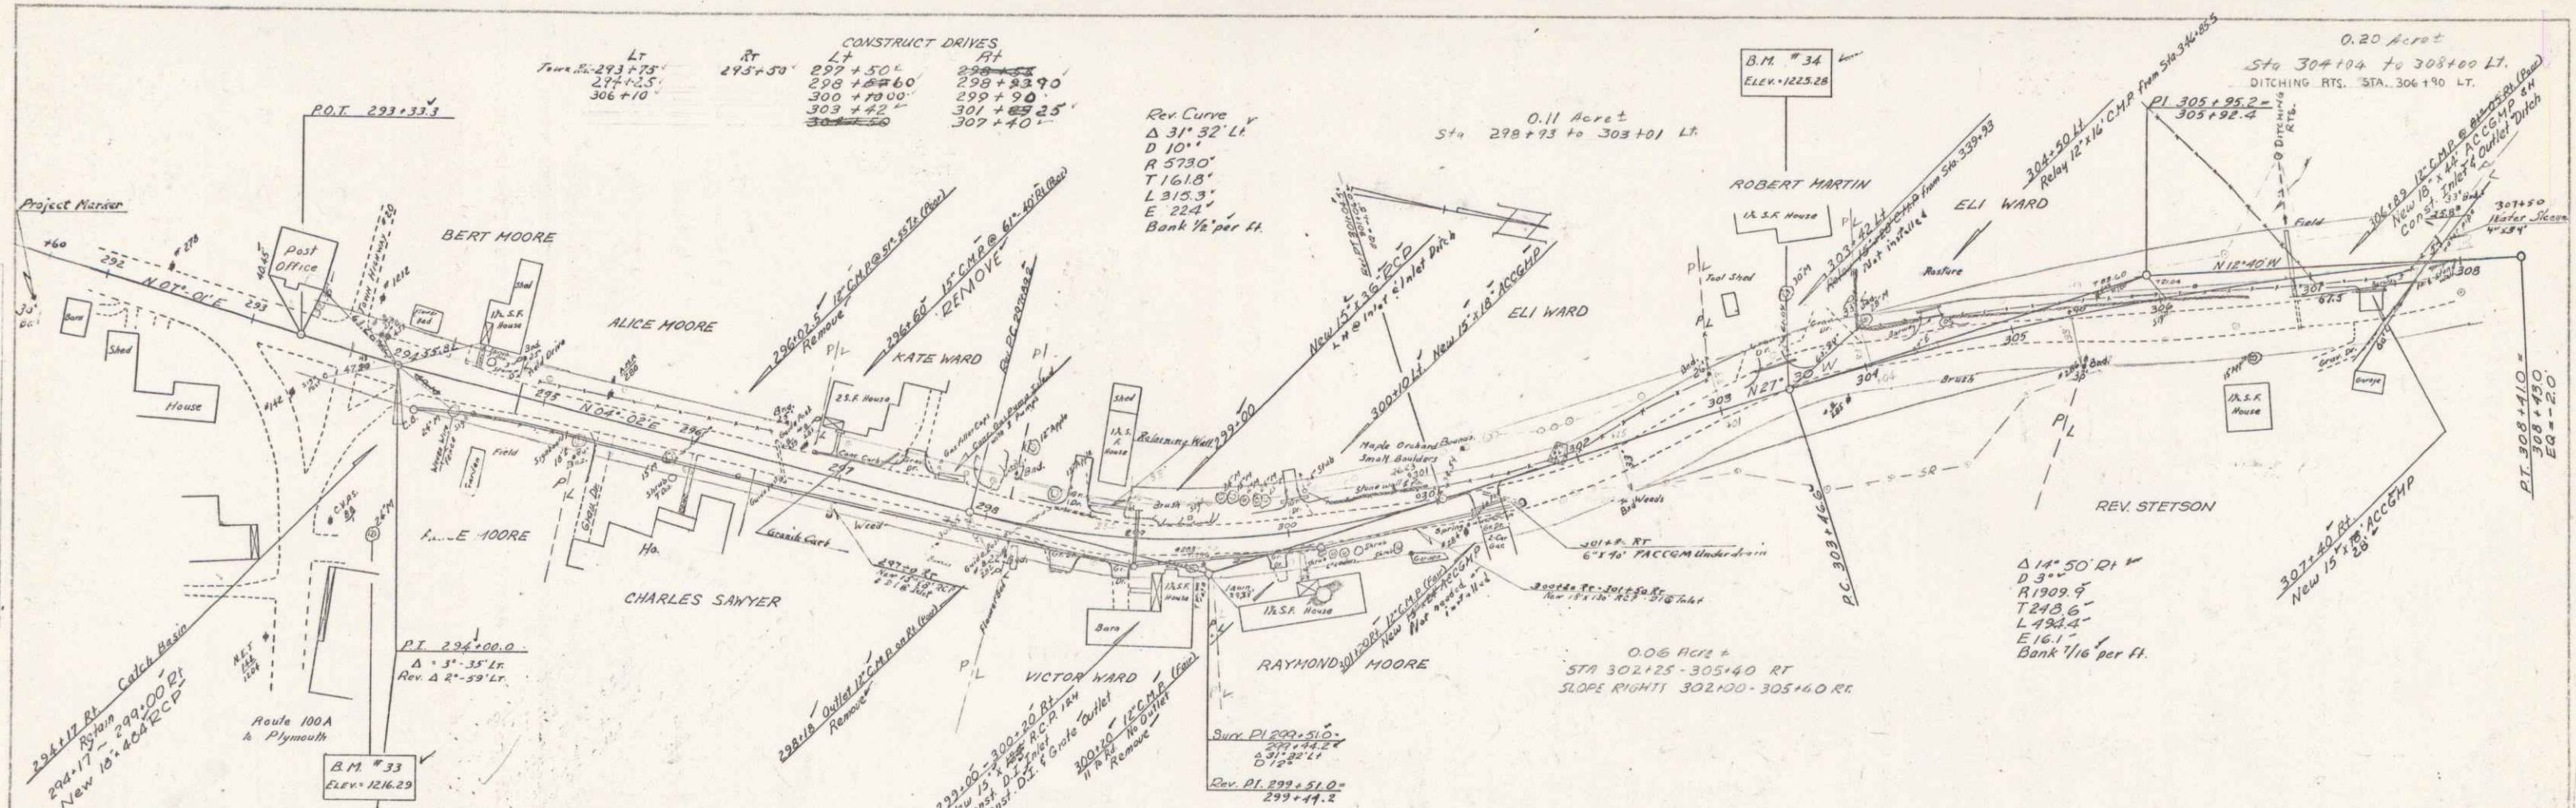

B.M. 33 S.I.R. 24' M 10817 RH Sta. 294+11. B.M. 34 S.I.R. 30' M 3617 LH Sta. 303+65.

PLYMOUTH  
 Project S No. 0147 (1) SA  
 Sheet 8 of 18 Sheets