


CONSTRUCTION NOTES:
 Drives Are To Be Constructed To A Minimum Width Of 12 Feet With A Minimum Radius Of 20 Feet On The Flare Unless Otherwise Indicated On The Plans Or Ordered By The Engineer.
 Rock Fills Are To Be Made With Rock Excavated On The Project. No Further Compensation Will Be Made For This Item.
 See Special Provisions For Channel Treatment In Relocated Channel Areas

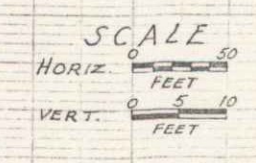

SCALE
 HORIZ. 1" = 50'
 VERT. 1" = 10'

Sta. 343 Rev. 344 Rev. 345 Rev. 346 Rev. 347 Rev. 348 Rev. 349 Rev. 350 Rev. 351 Rev. 352 Rev. 353 Rev. 354 Rev. 355 Rev. 356 Rev. 357 Rev. 358 Rev. 359

PLYMOUTH BRIDGE WATER PROJECT N° J-7-20 Sheet 16 of 175 sheets