
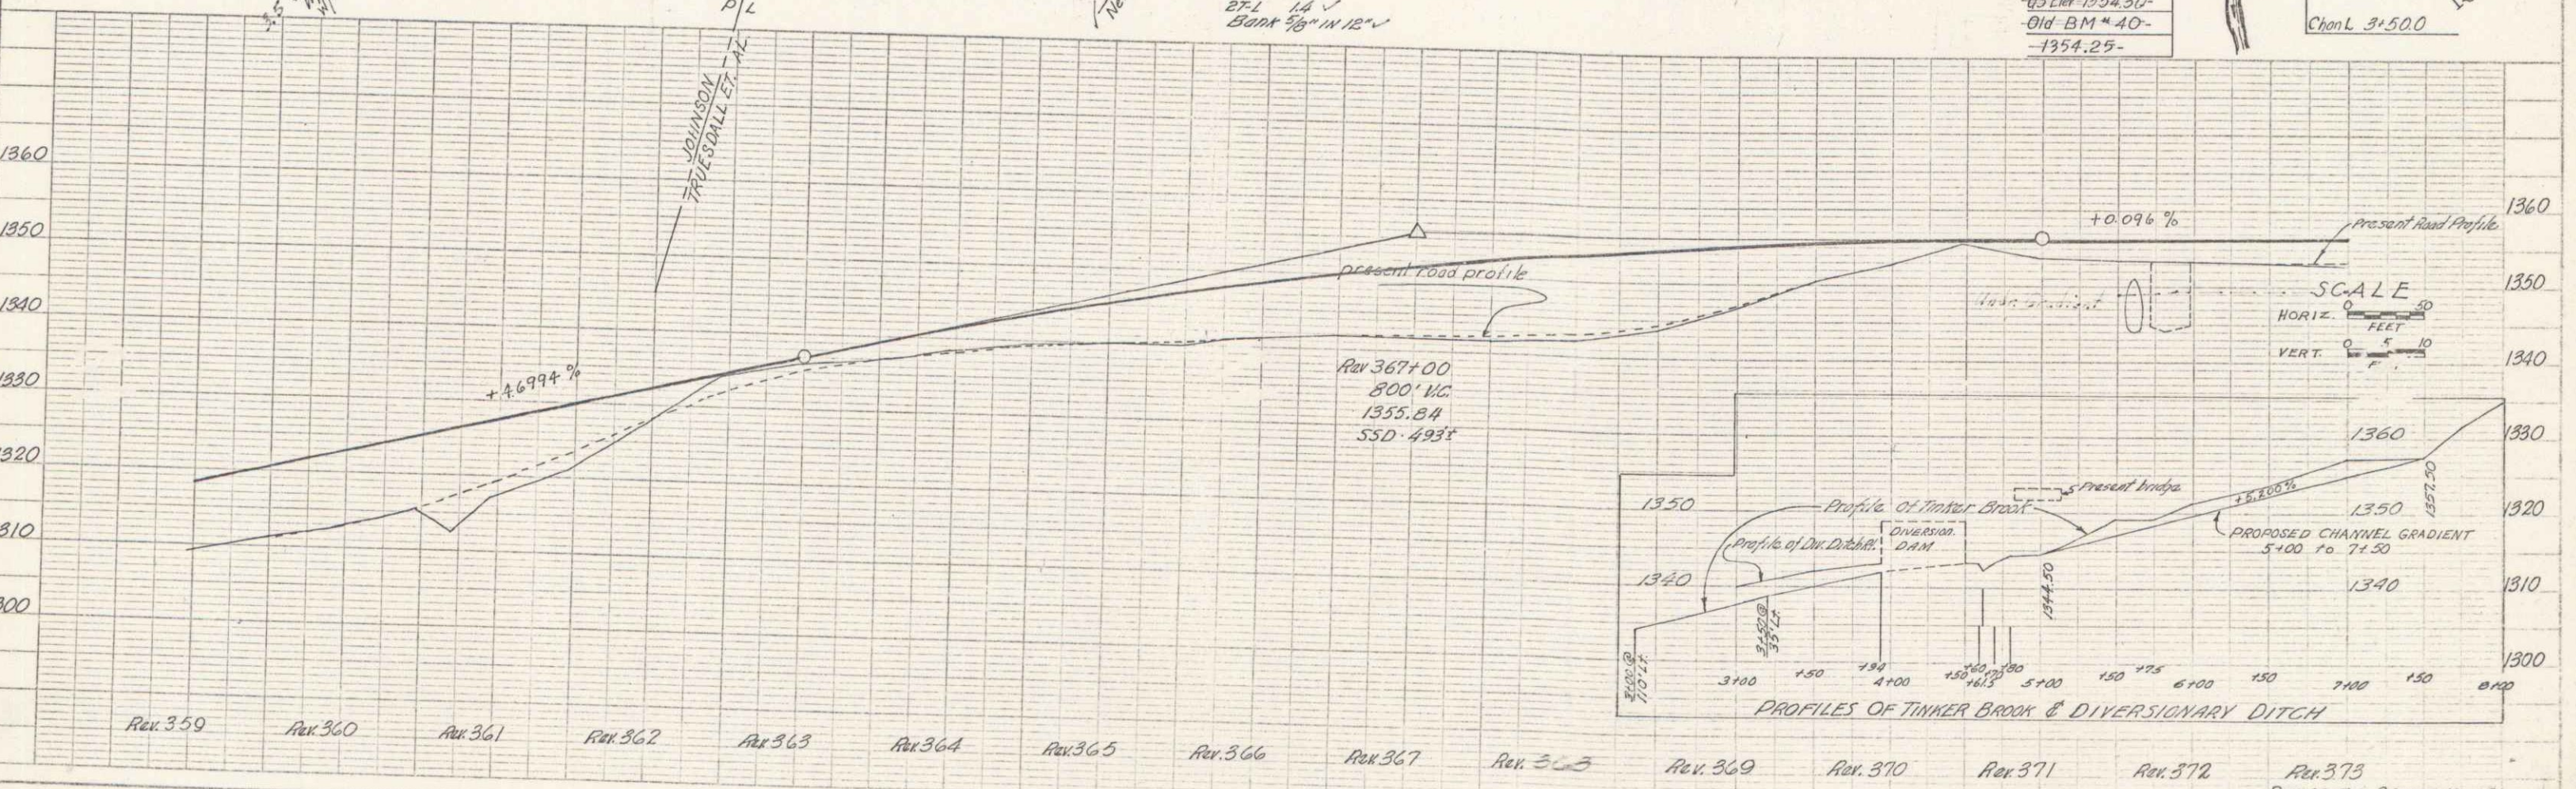


PLANNING
 TRACER
 M. Smith
 4/22

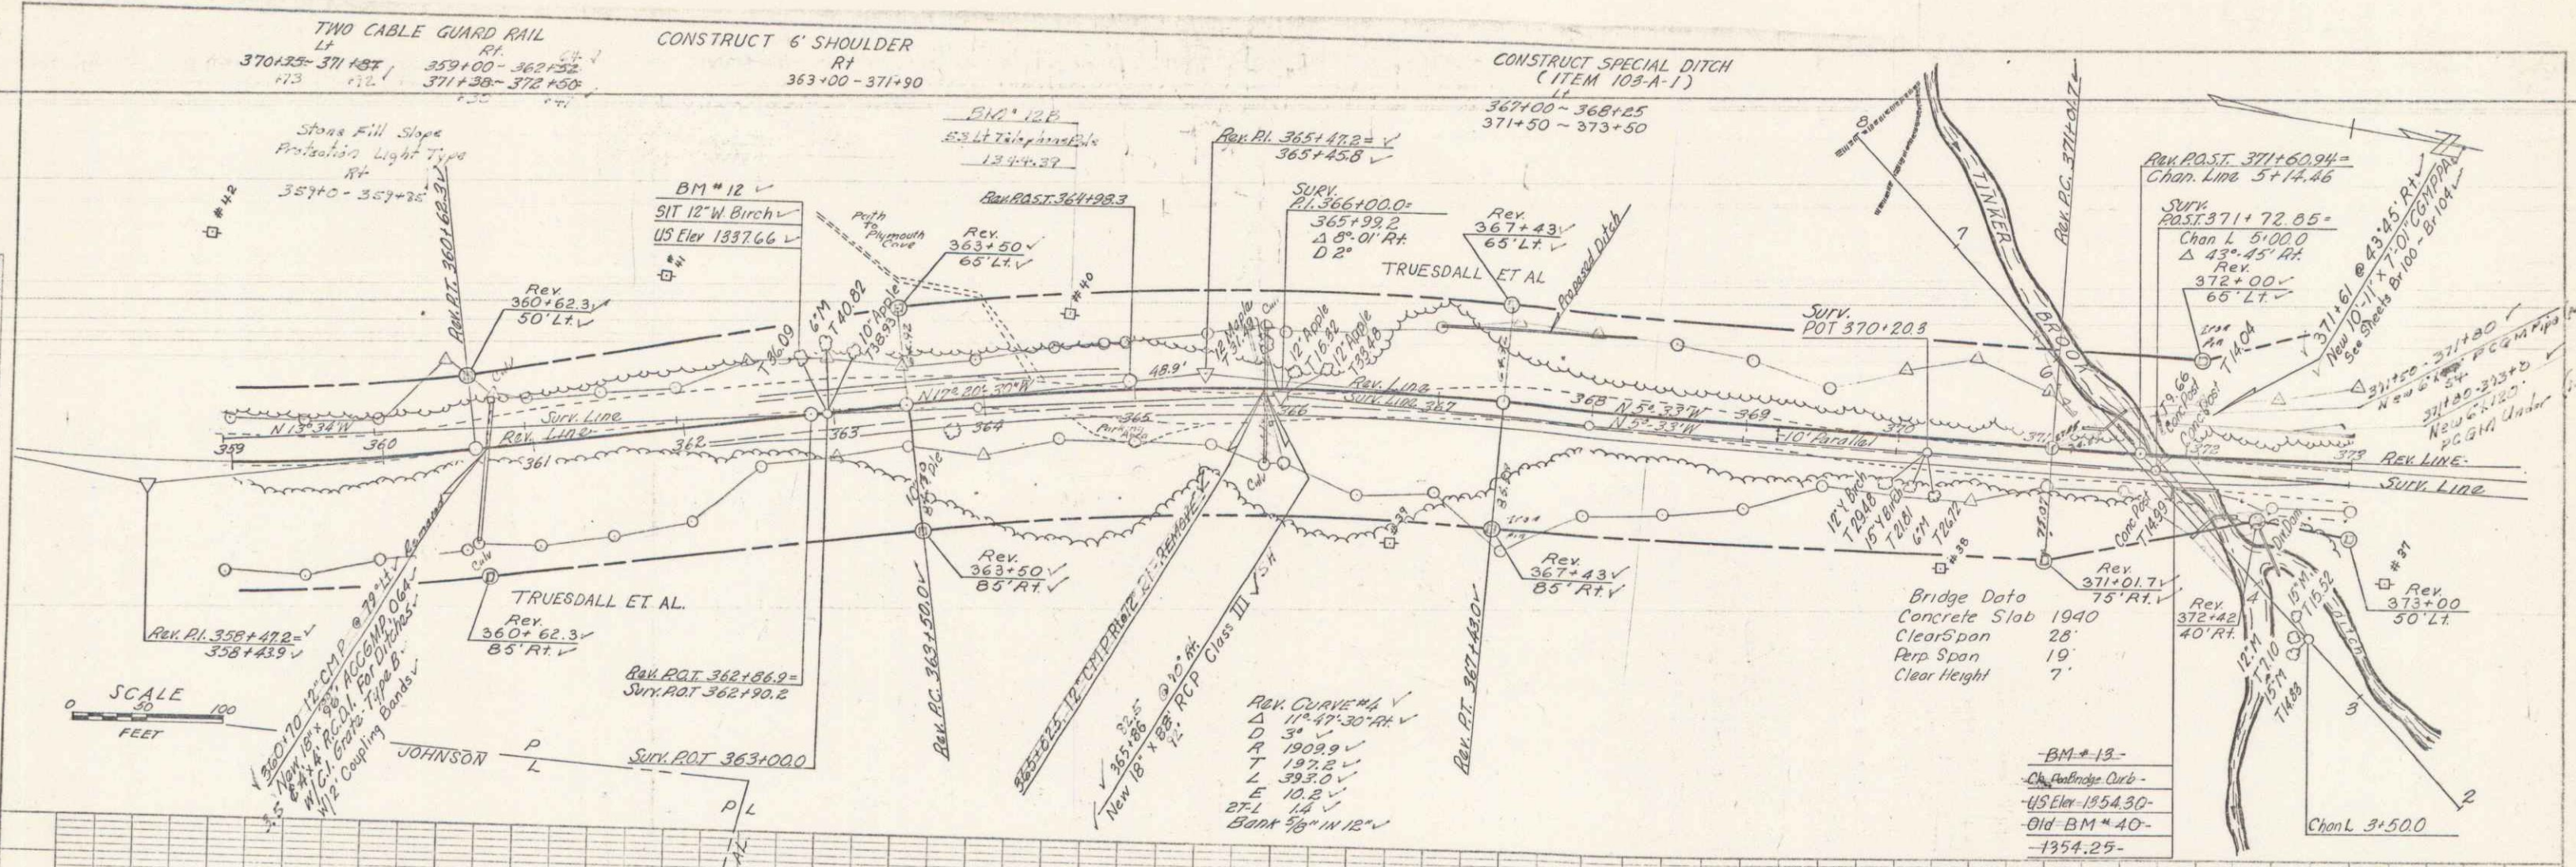

FILE
 4/22
 M. Smith