
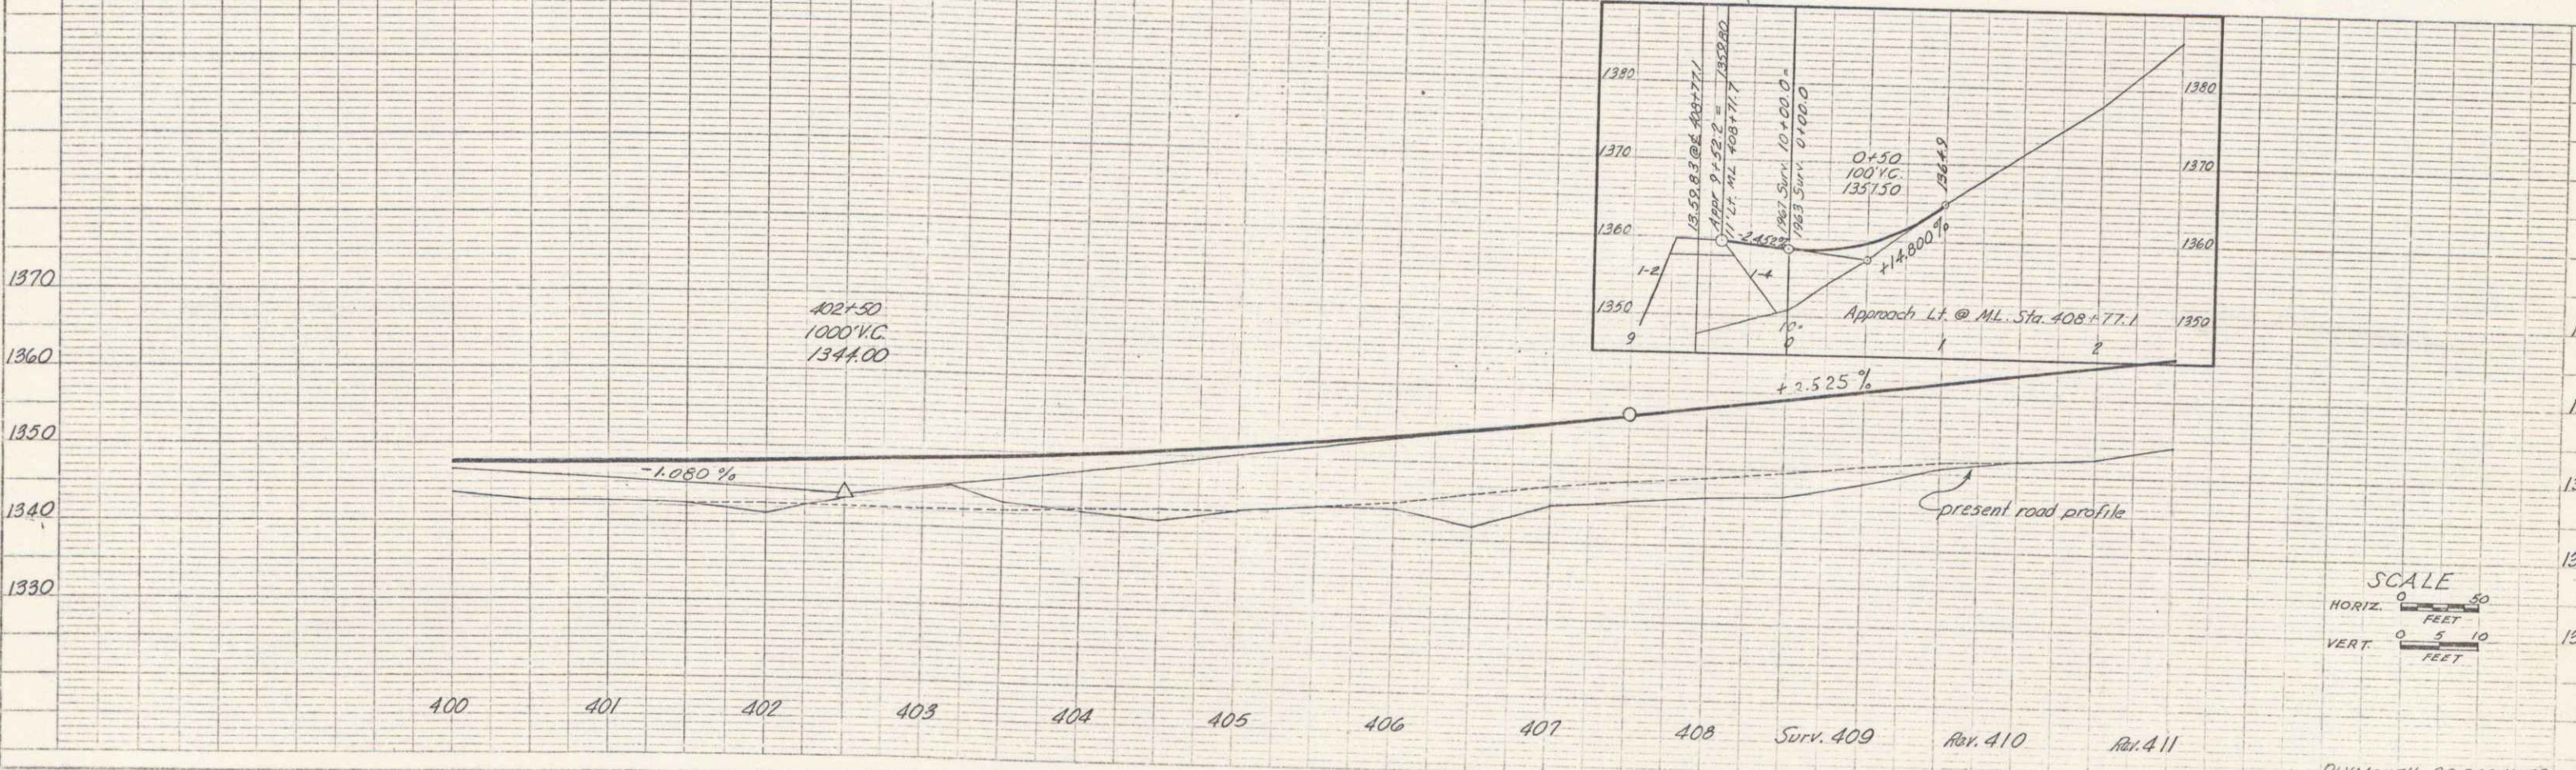


PLAN  
 DATE: 10/1/67  
 DRAWN BY: J. Smith  
 CHECKED BY: J. Smith

FILE  
 PROJECT: PLYMOUTH BRIDGEWATER  
 SHEET: 20 of 175 sheets

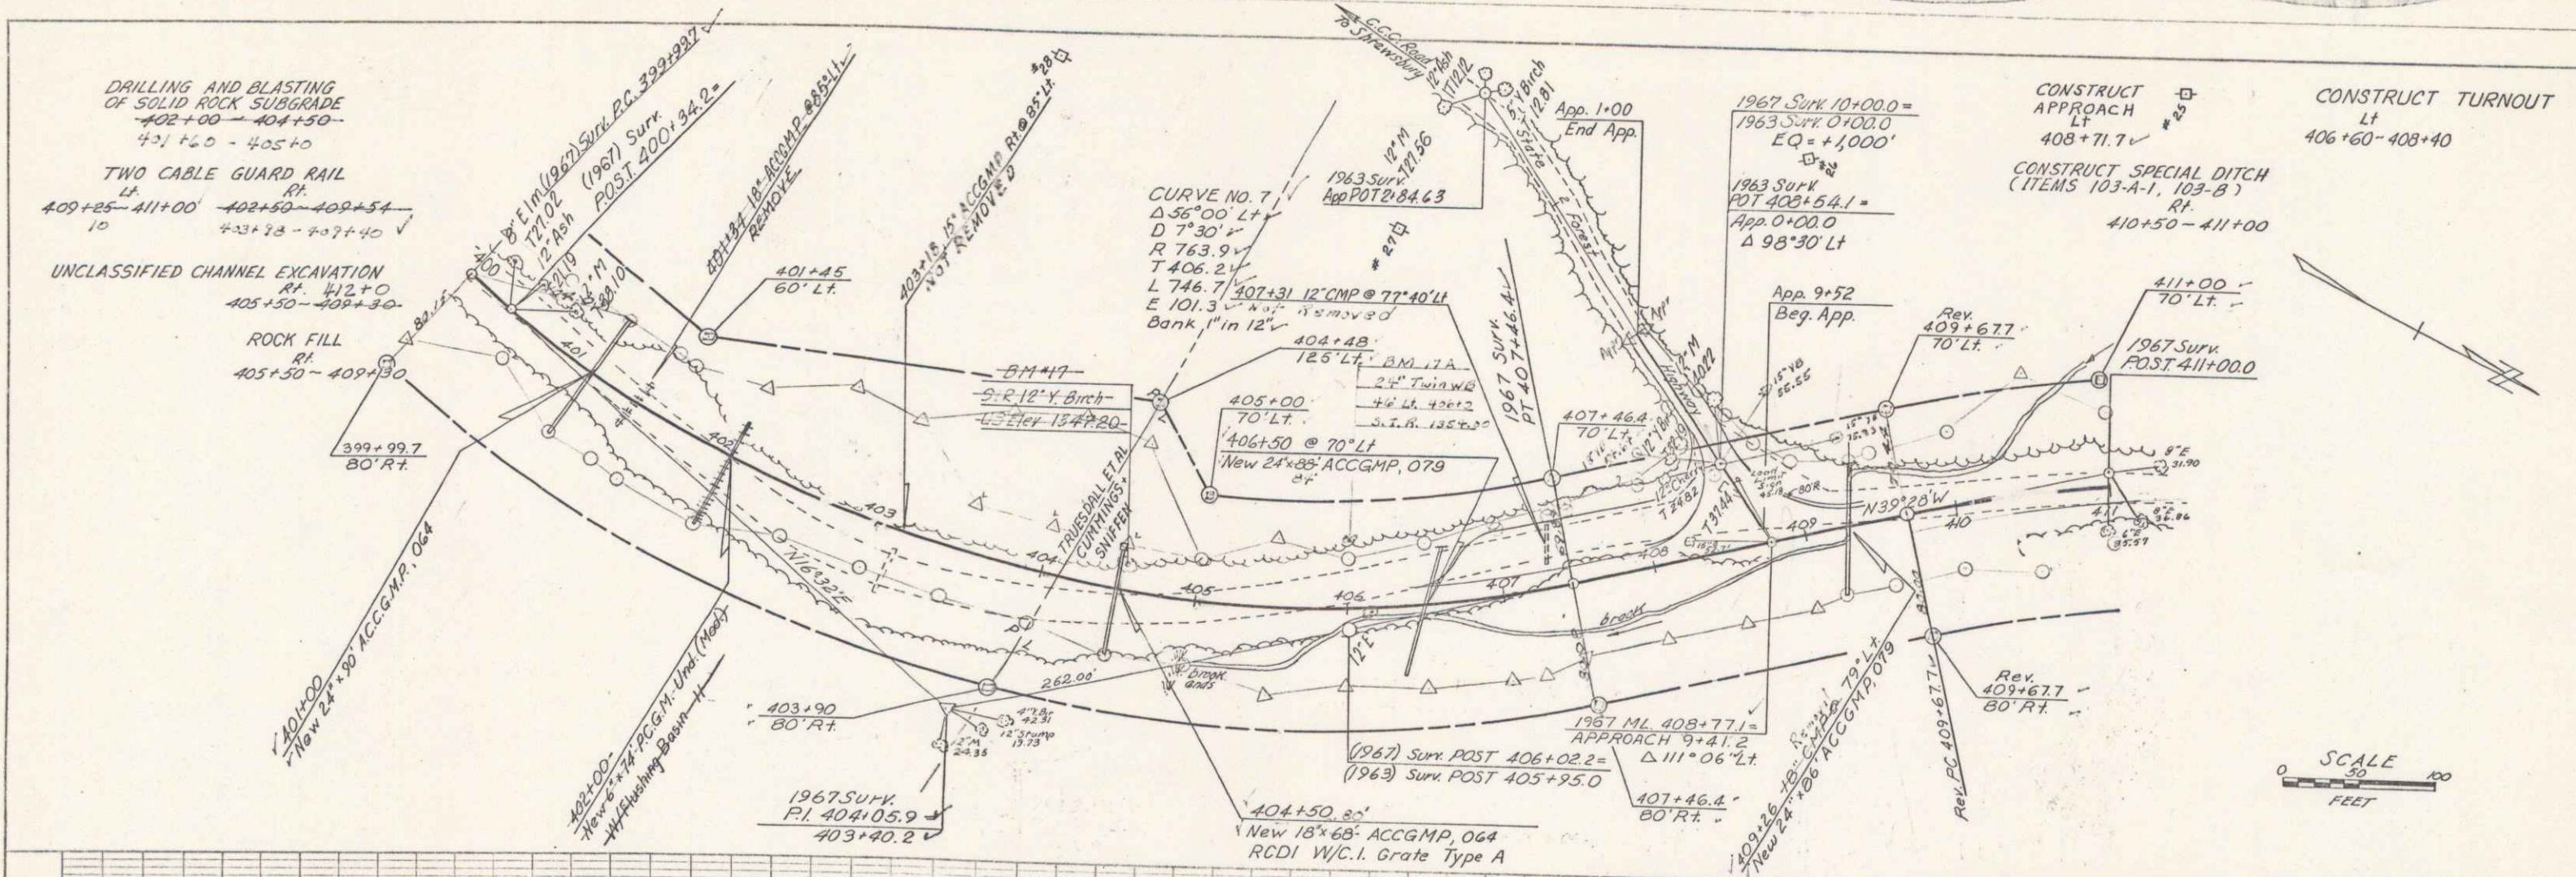

PLYMOUTH BRIDGEWATER  
 Project 2-N-014(12)  
 Sheet 20 of 175 sheets