


7/68
 3/24
 4/64
 Spaulding
 Smith
 Coak
 4/64
 PLAN
 100' = 1"



4/68
 4/68
 Berger
 Cook
 4/68
 FILE
 100' = 1"

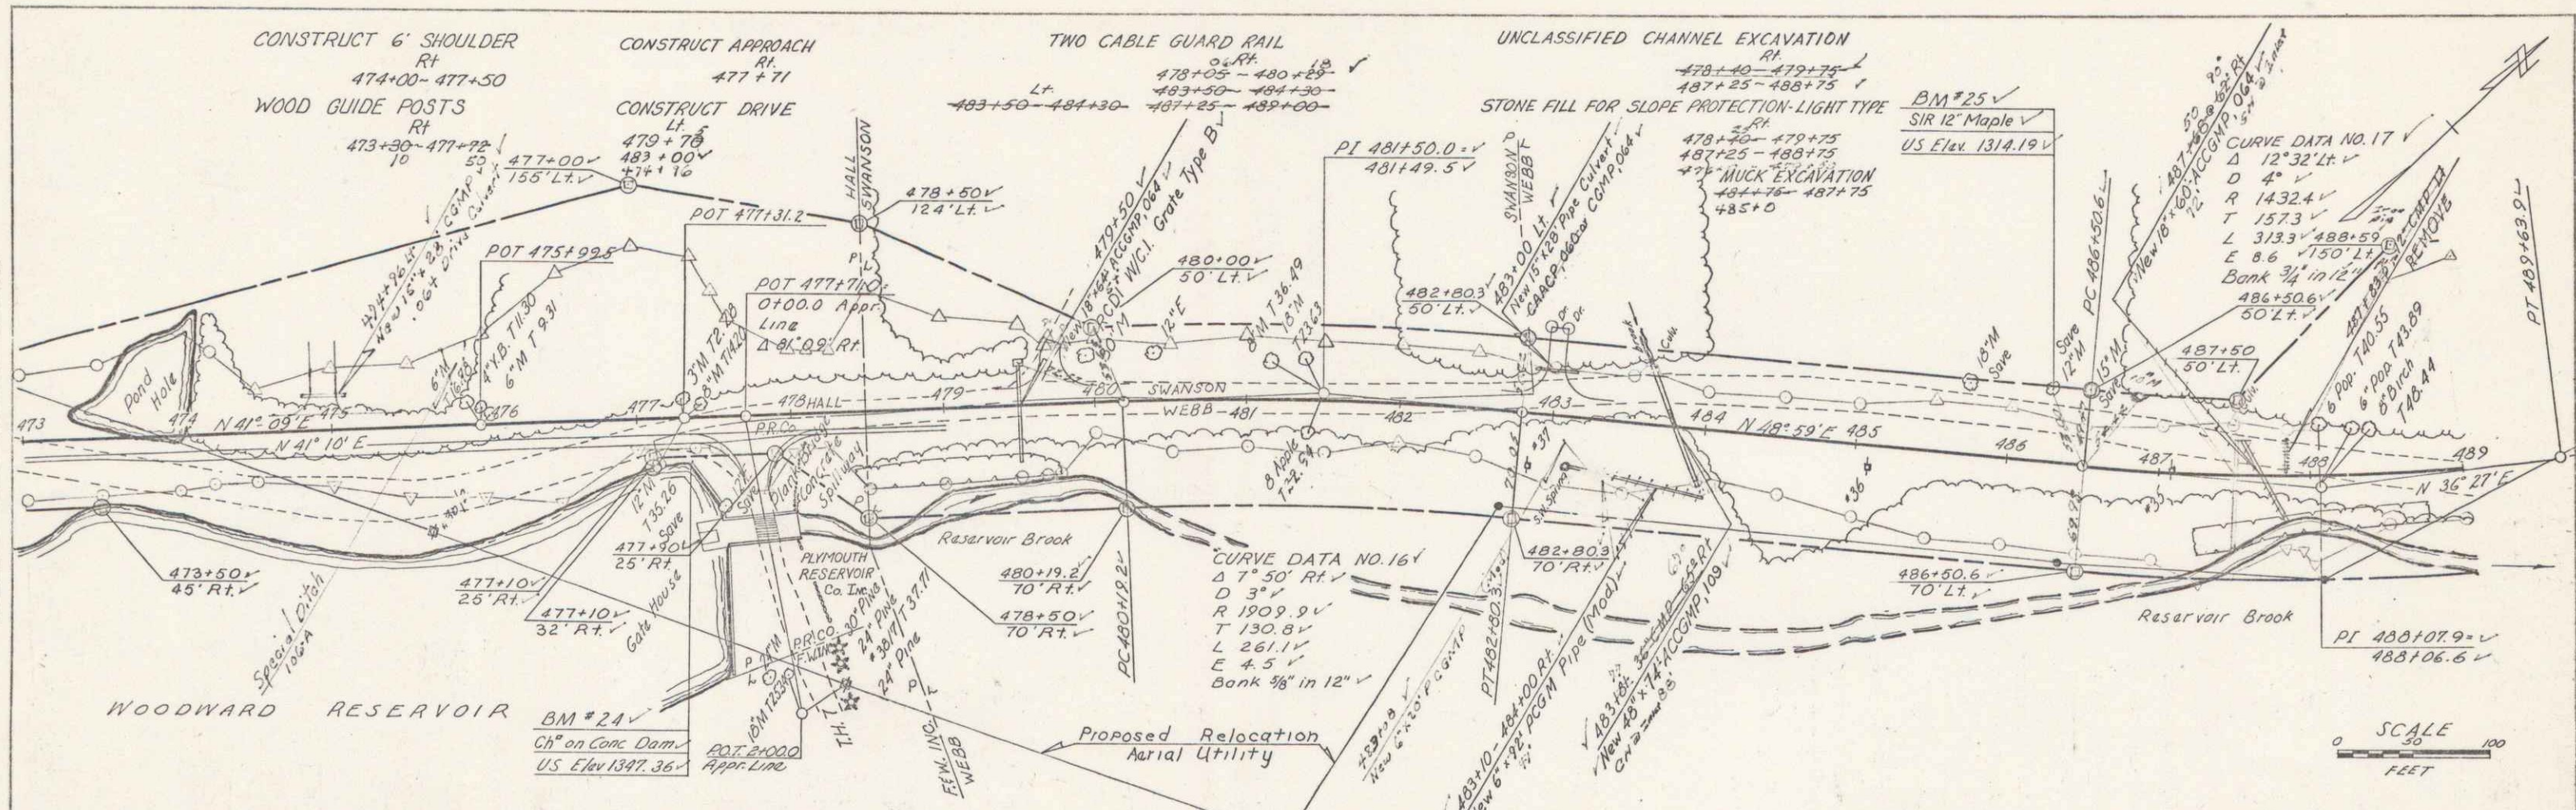