
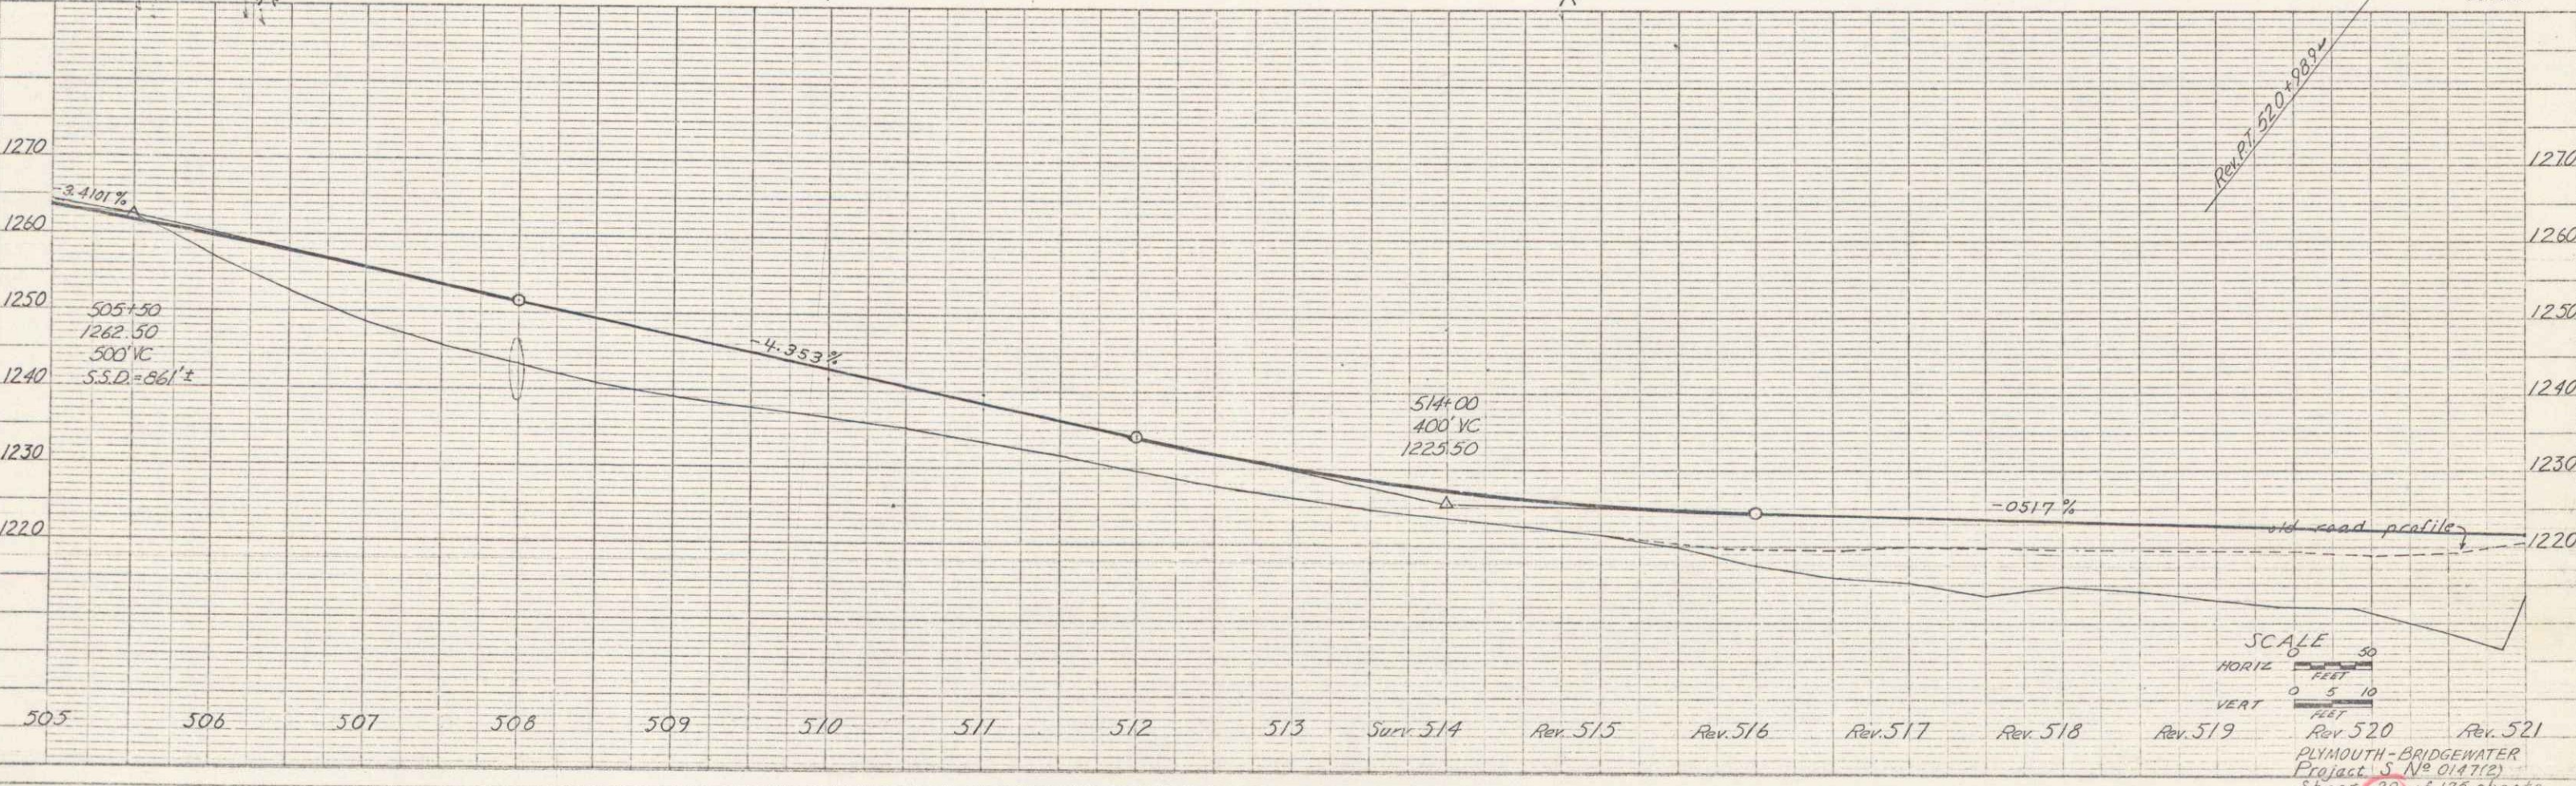


PLAN
 S. Murray
 Traced

FILE
 S. Murray
 10/1/53

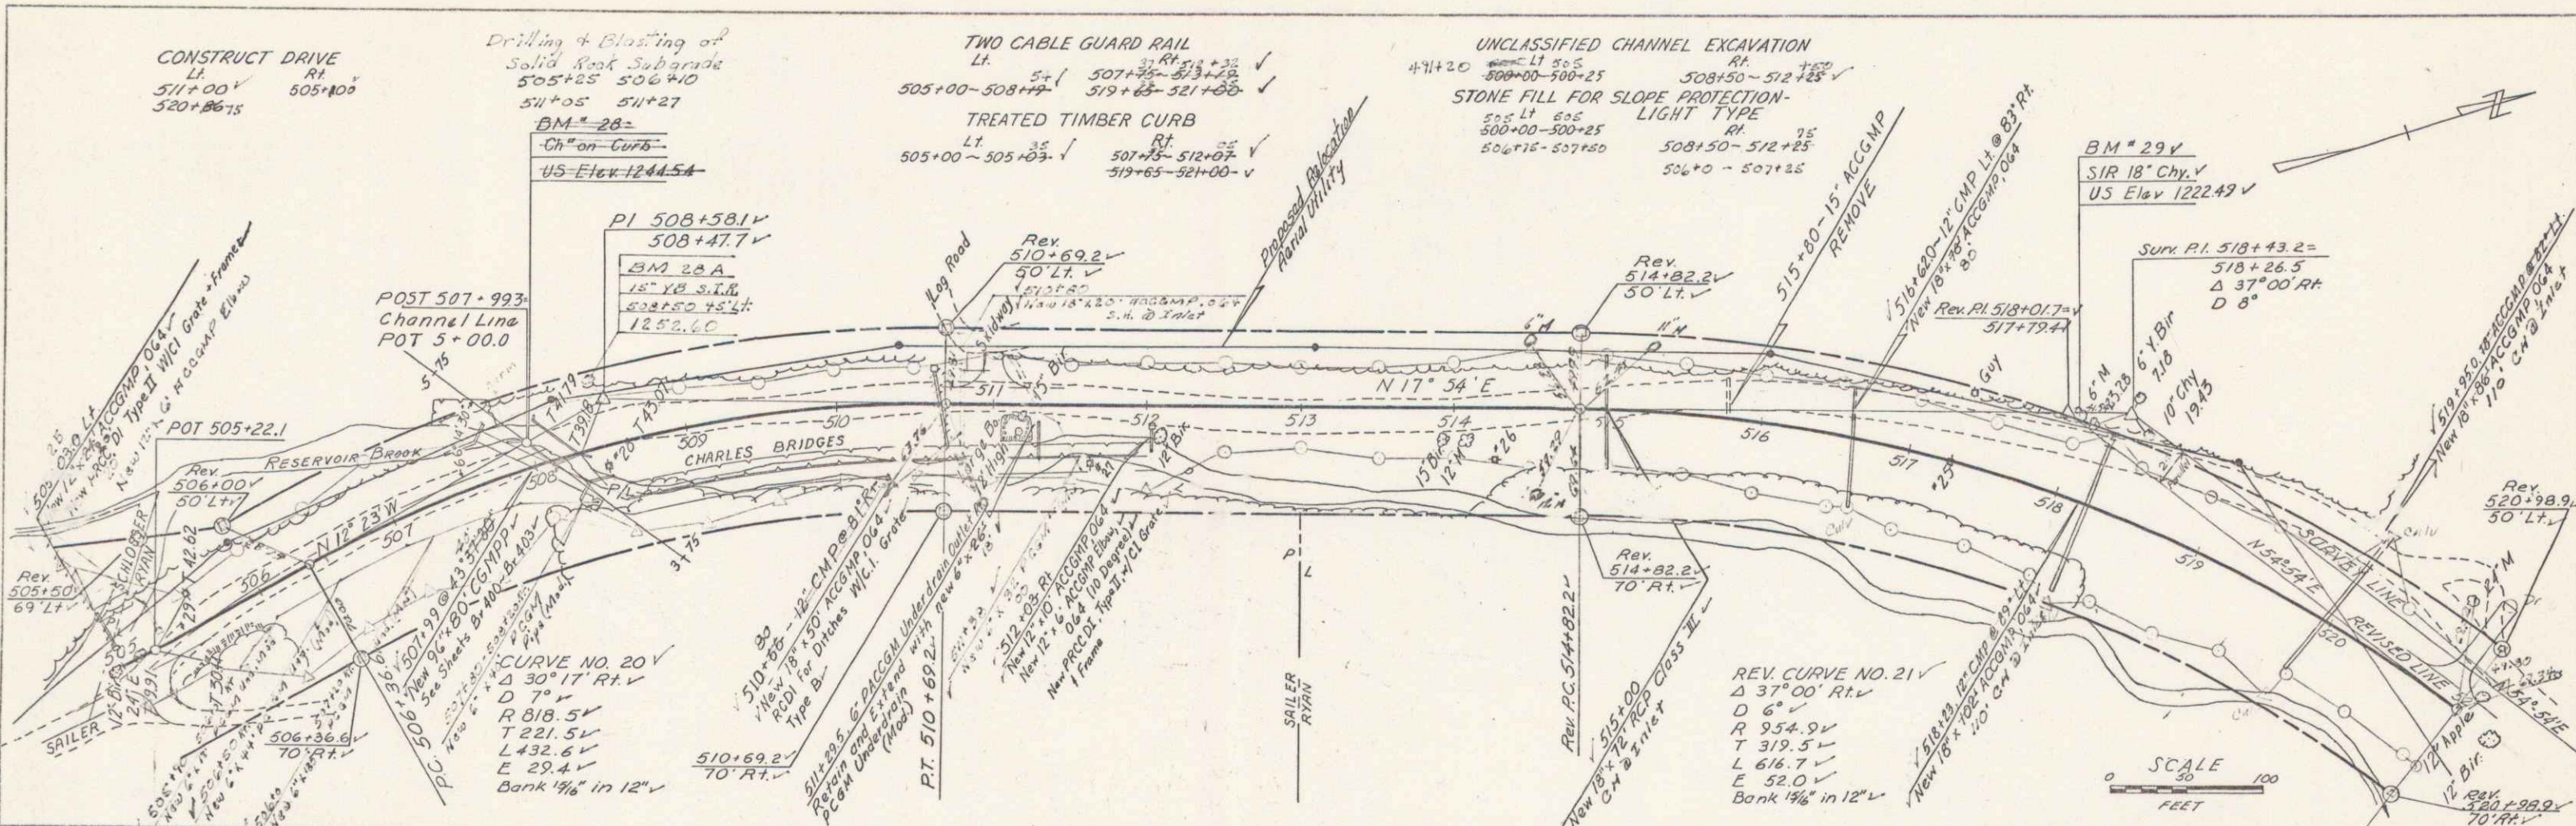

SCALE
 HORIZ 50 FEET
 VERT 5 FEET
 Rev. 520 Rev. 521
 PLYMOUTH-BRIDGWATER
 Project S No 014712
 Sheet 29 of 175 sheets