
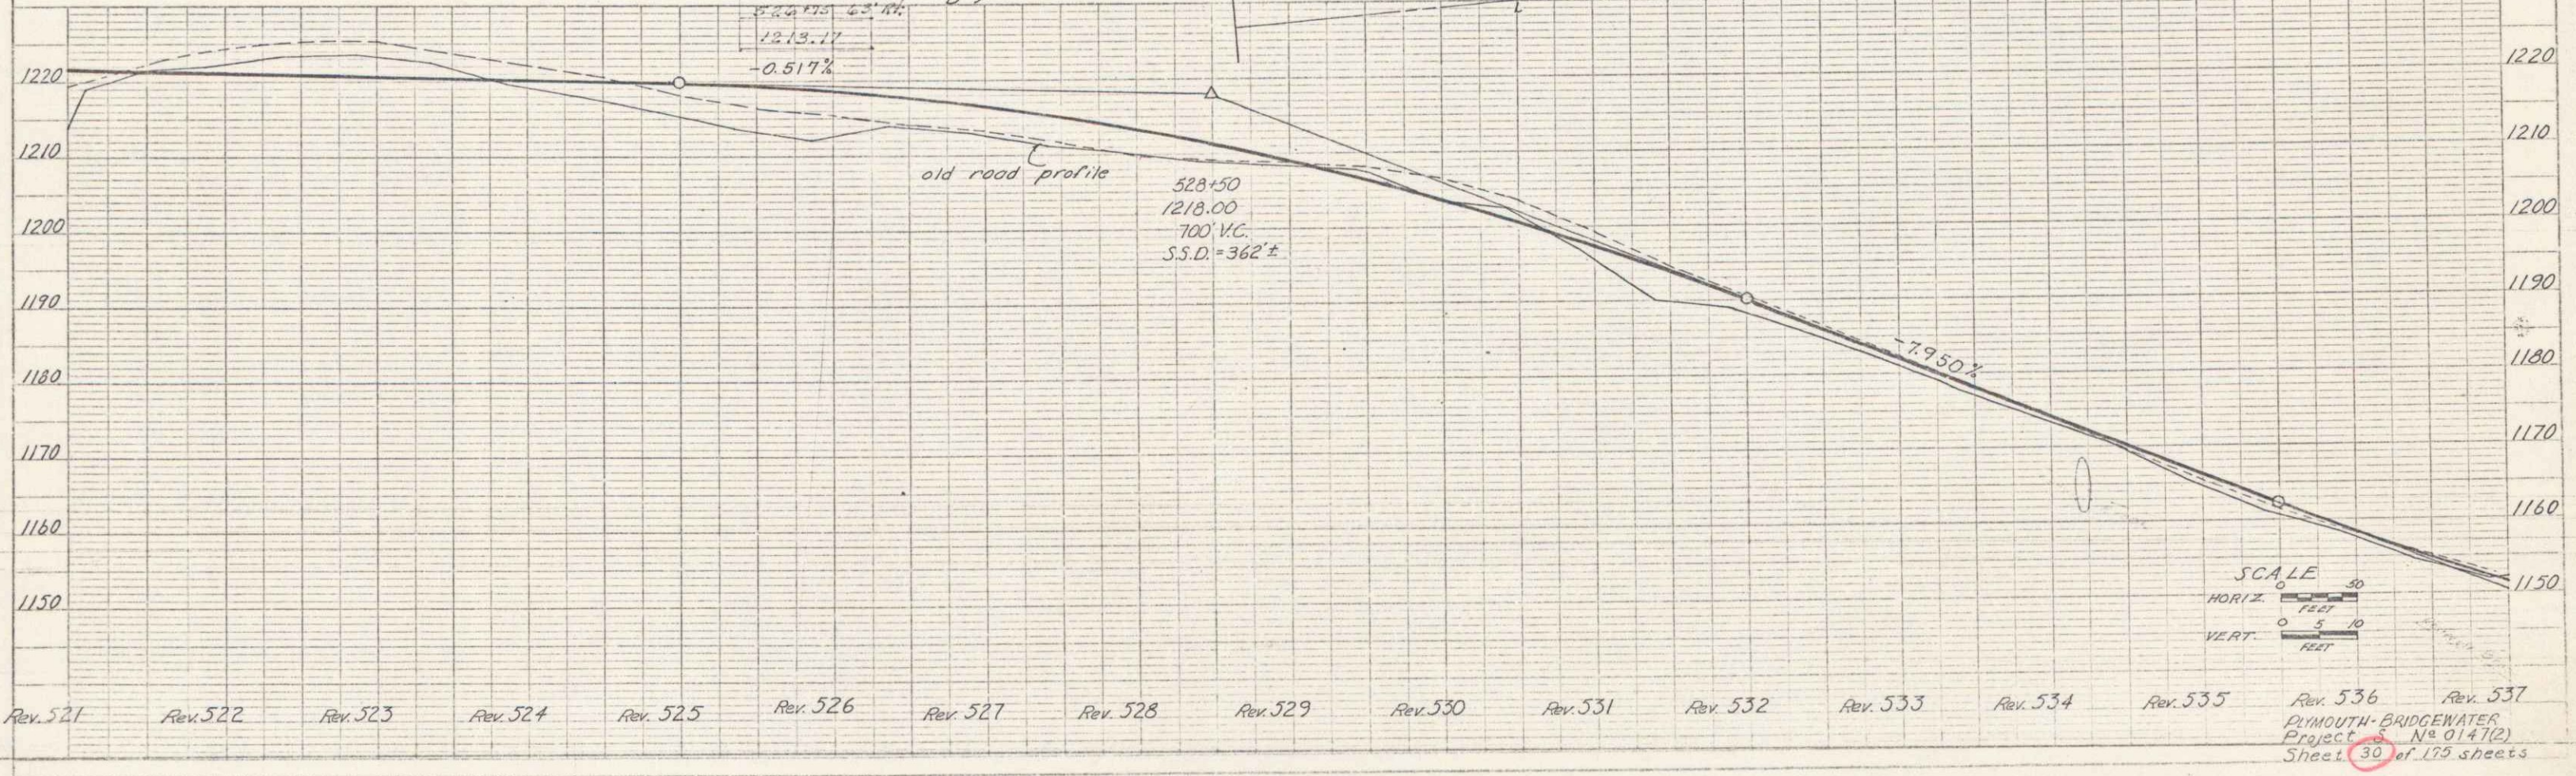


PLAN
 S. C. MURRAY
 1948

PROFILE
 S. C. MURRAY
 1948

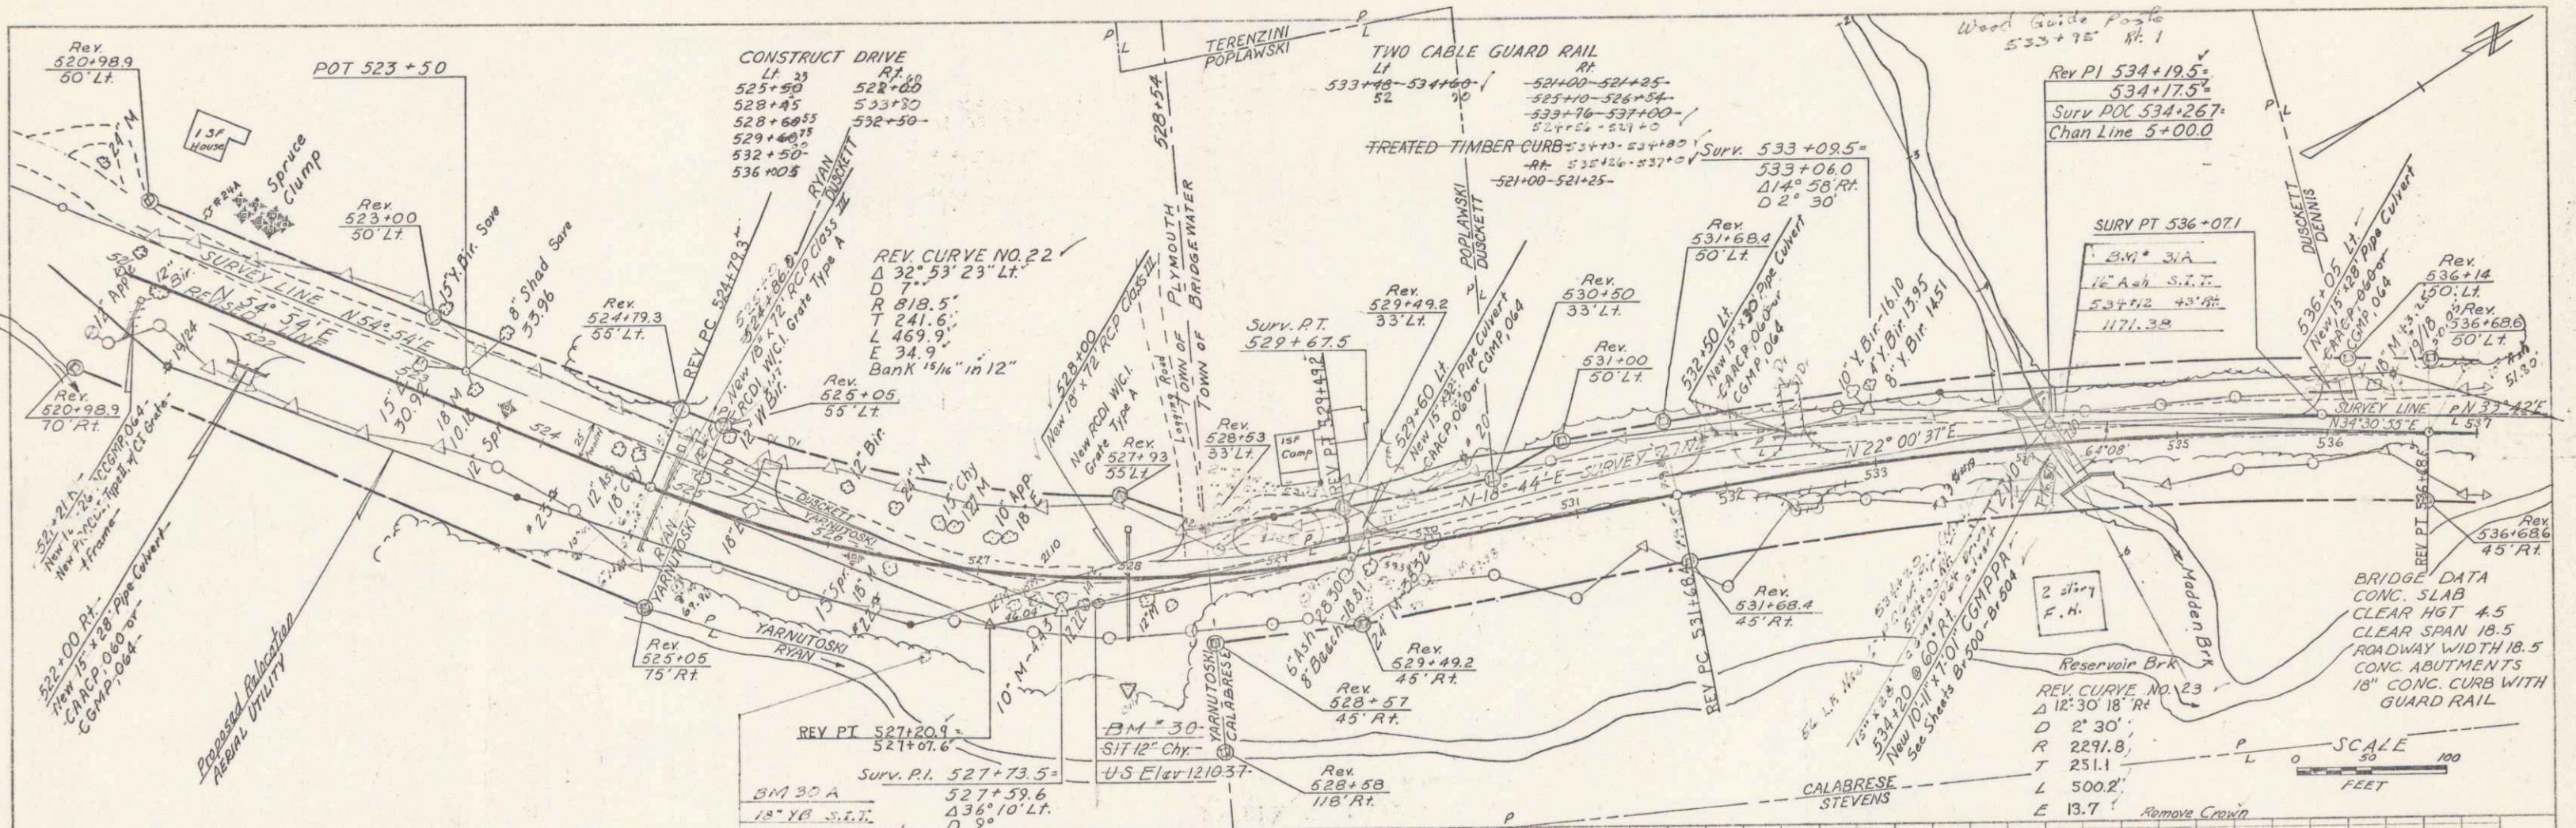

Rev. 536 Rev. 537
 PLYMOUTH BRIDGEWATER
 Project No. 0147(2)
 Sheet 30 of 155 sheets