
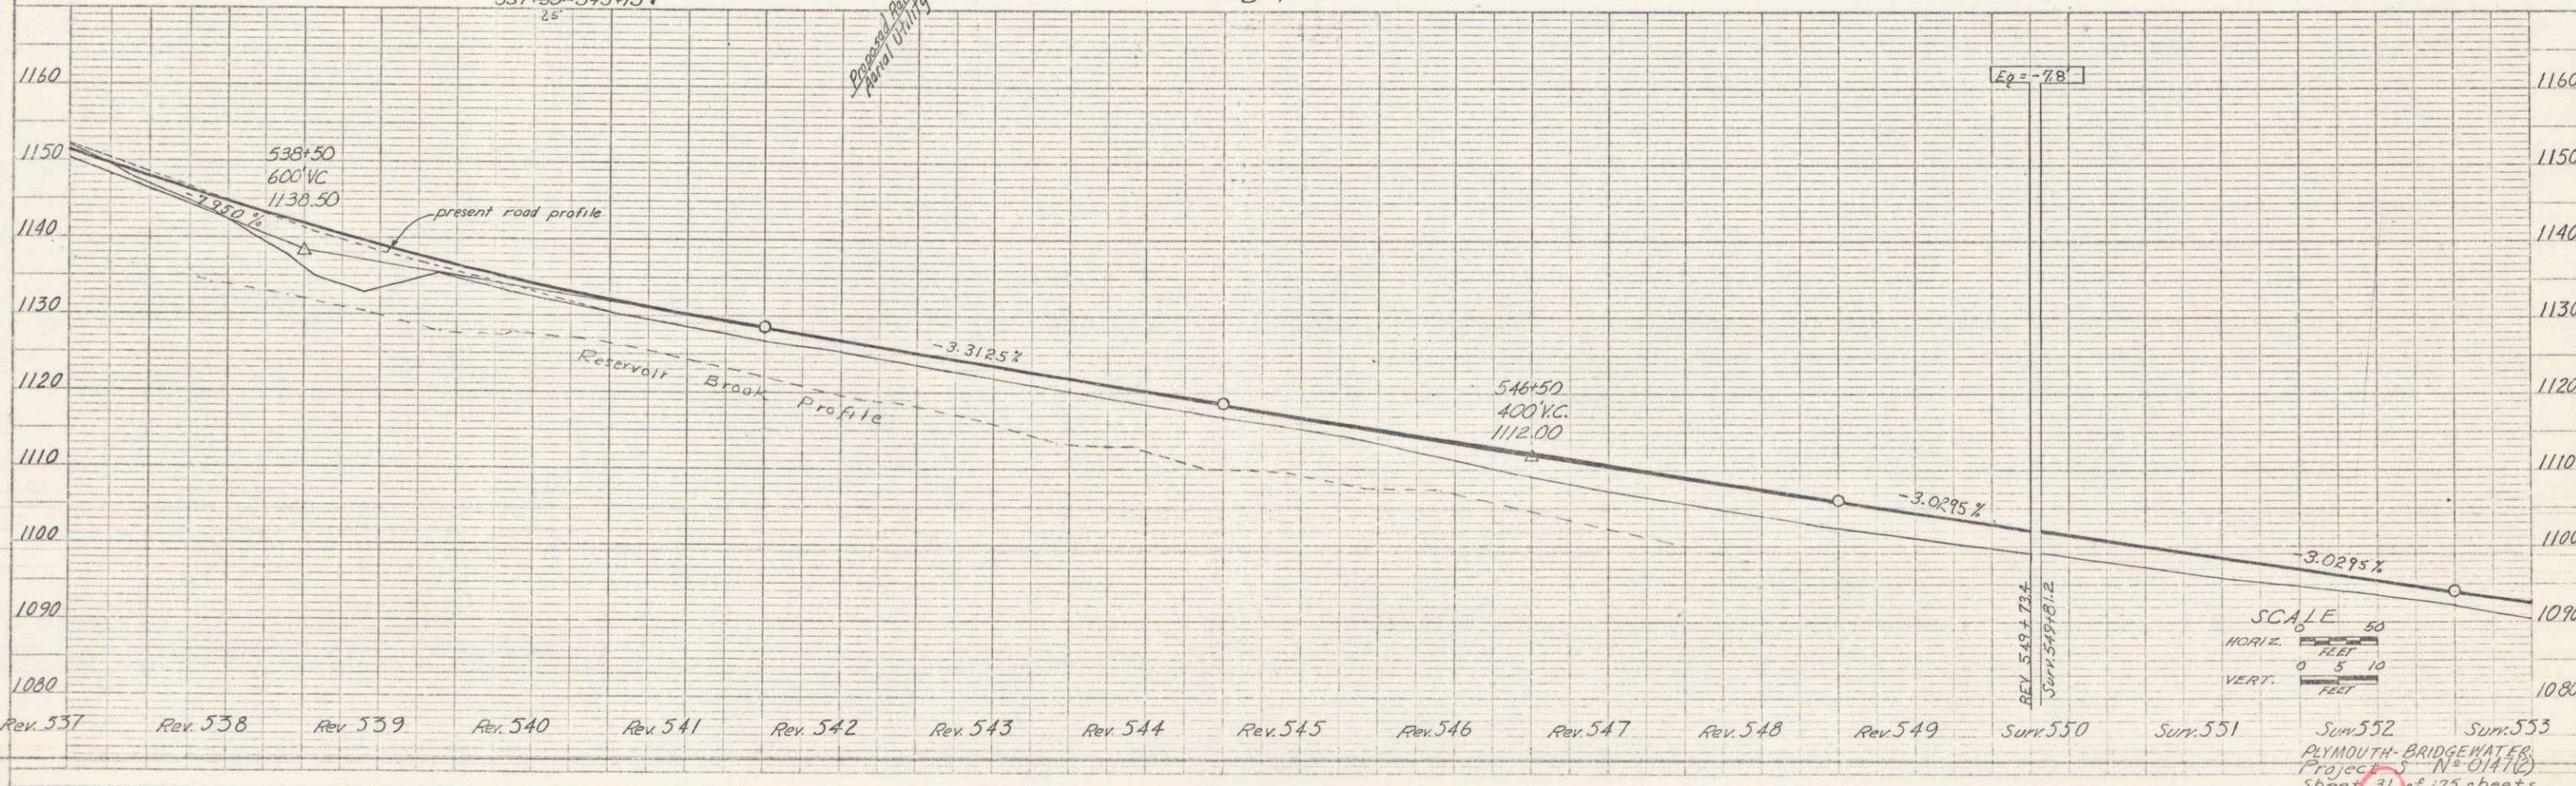


PLAN
 DRAWN BY: S.C. Murray
 DATE: Feb 83
 CHECKED BY: S.C. Murray
 DATE: Feb 83

PROFILE
 DRAWN BY: S.C. Murray
 DATE: Feb 83
 CHECKED BY: S.C. Murray
 DATE: Feb 83

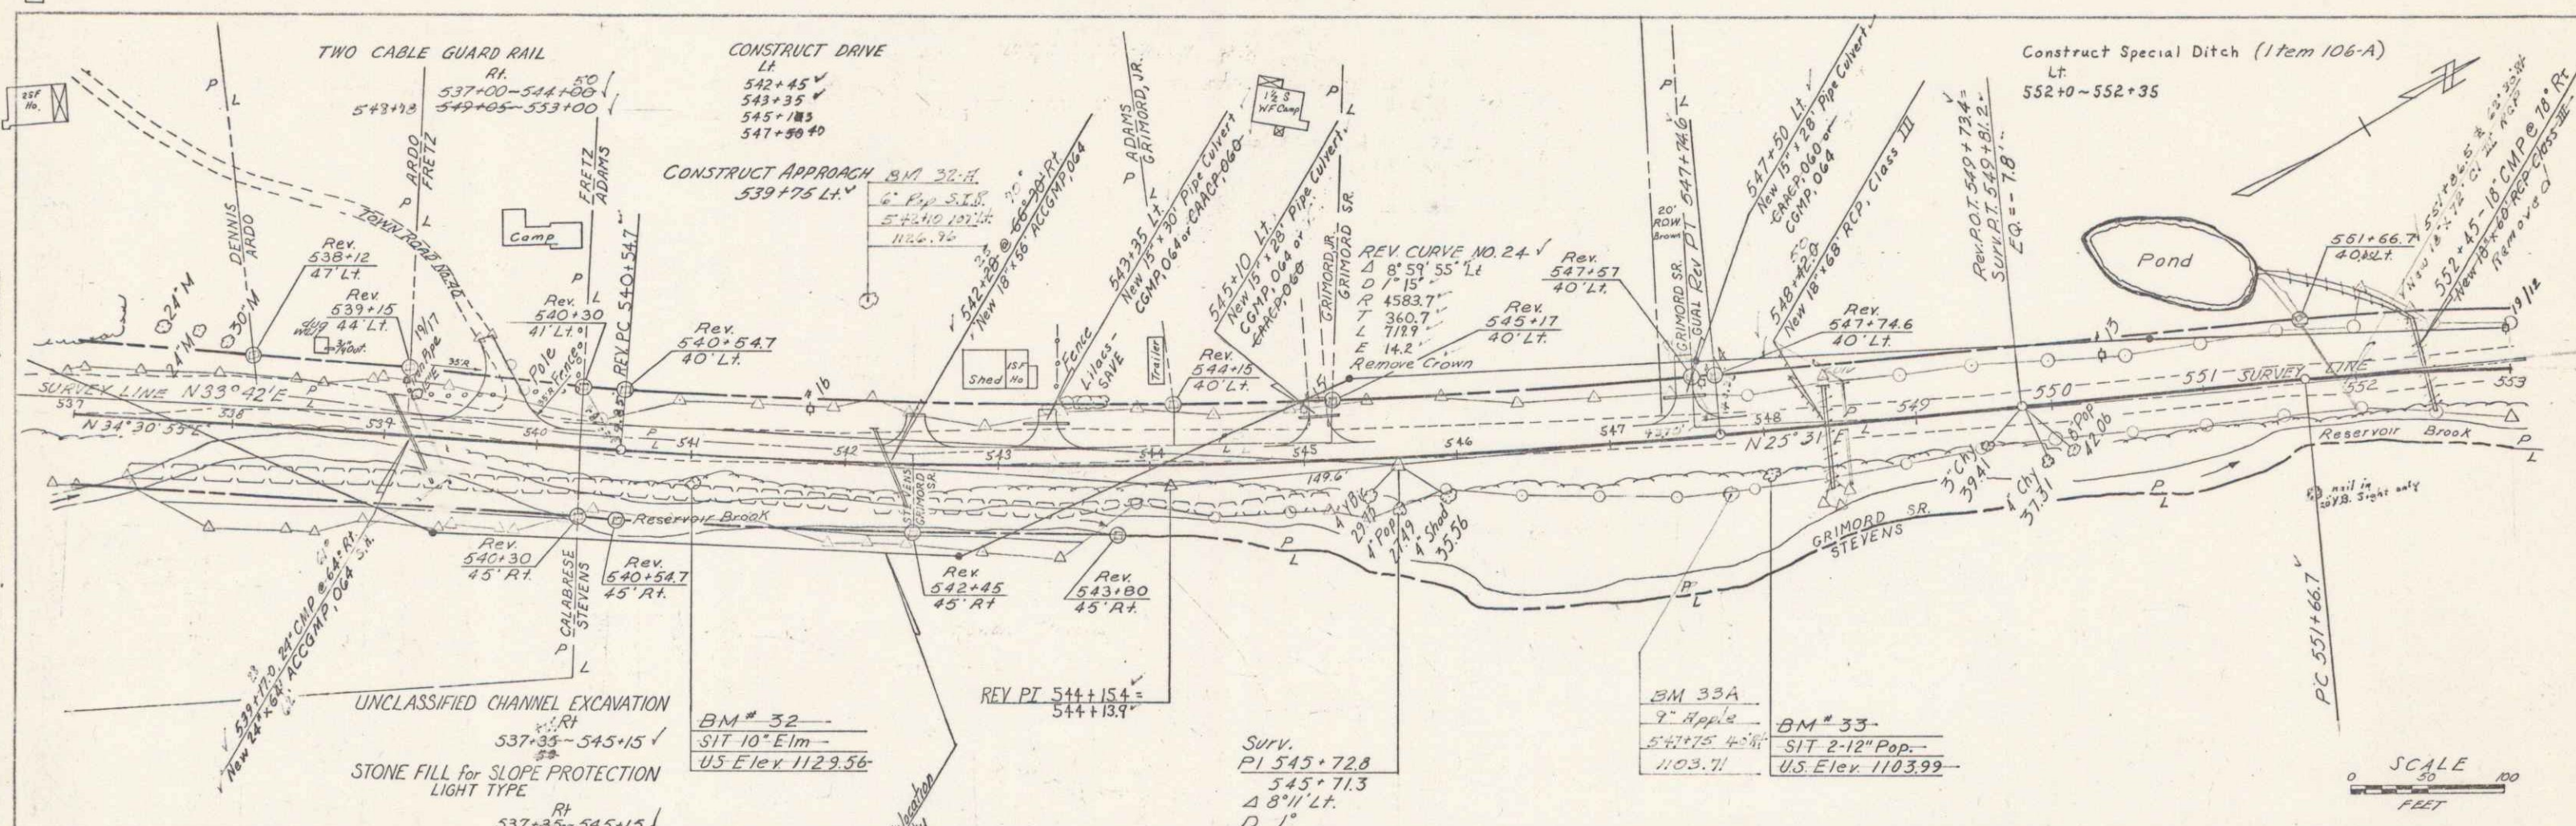

Sum. 552
 PLYMOUTH BRIDGE WALTERS
 Project N-01410
 Sheet 31 of 125 sheets