


BM\* 35  
10' Spruce  
U.S. Elev. 1068.03

SCALE  
0 50 100  
FEET

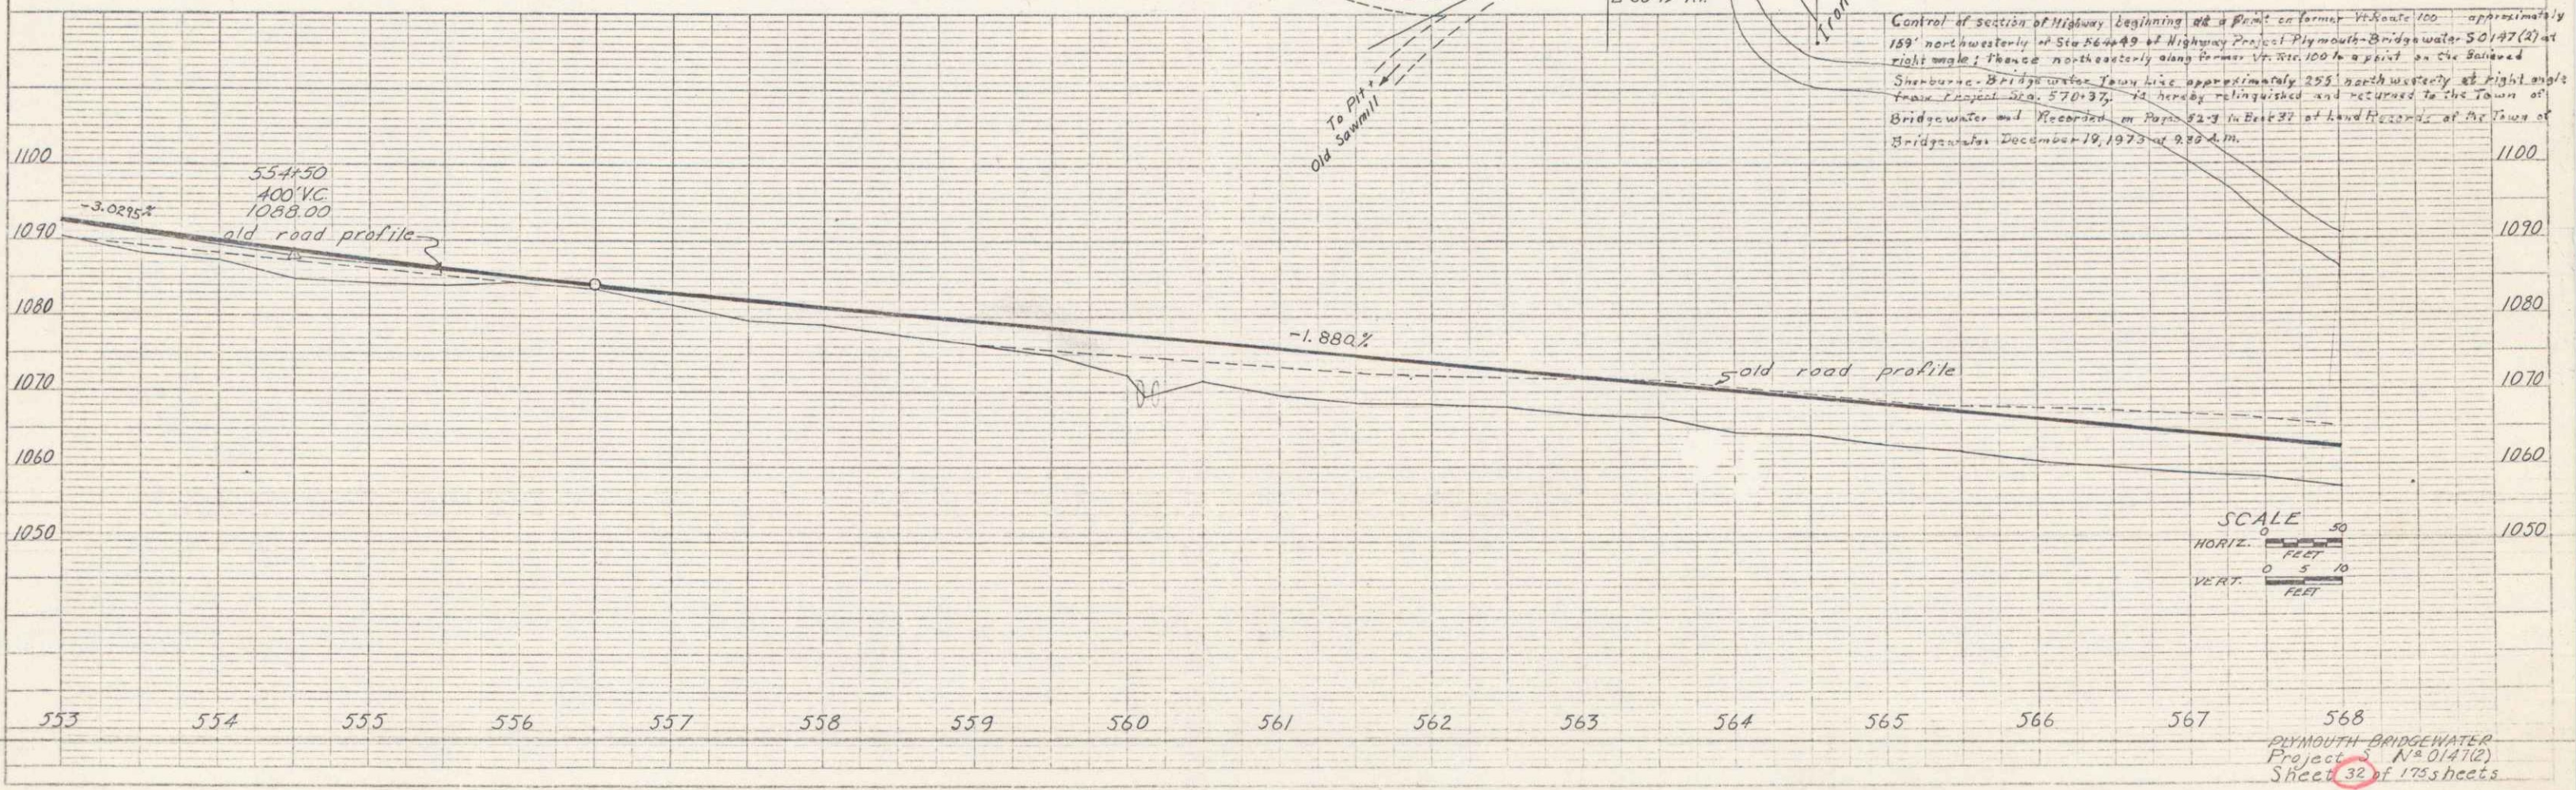

SCALE  
HORIZ. 0 50 FEET  
VERT. 0 5 10 FEET

553 554 555 556 557 558 559 560 561 562 563 564 565 566 567 568  
PLYMOUTH-BRIDGWATER  
Project No. 0147(2)  
Sheet 32 of 175 sheets