


THREE CABLE GUARD RAIL WITH STEEL POSTS
 101+00-101+70
 103+00-103+50
 43-108+48
 Slope Fill for Slope Protection
 L.A.
 123160-1110

BRIDGE DATA
 Type - Conc. Slab
 Clear Span - 10'
 Clear Height - 3.5'
 Roadway - 20'6"
 Conc. Rail
 P.I. 99+75.7
 99+54.3

REMOVAL AND DISPOSAL OF PRESENT GUARD RAIL
 100+05-101+00 V
 101+22-101+40 V
 101+22-101+40 V

CONSTRUCT APPROACH
 103+20 Lt
 103+20 Lt

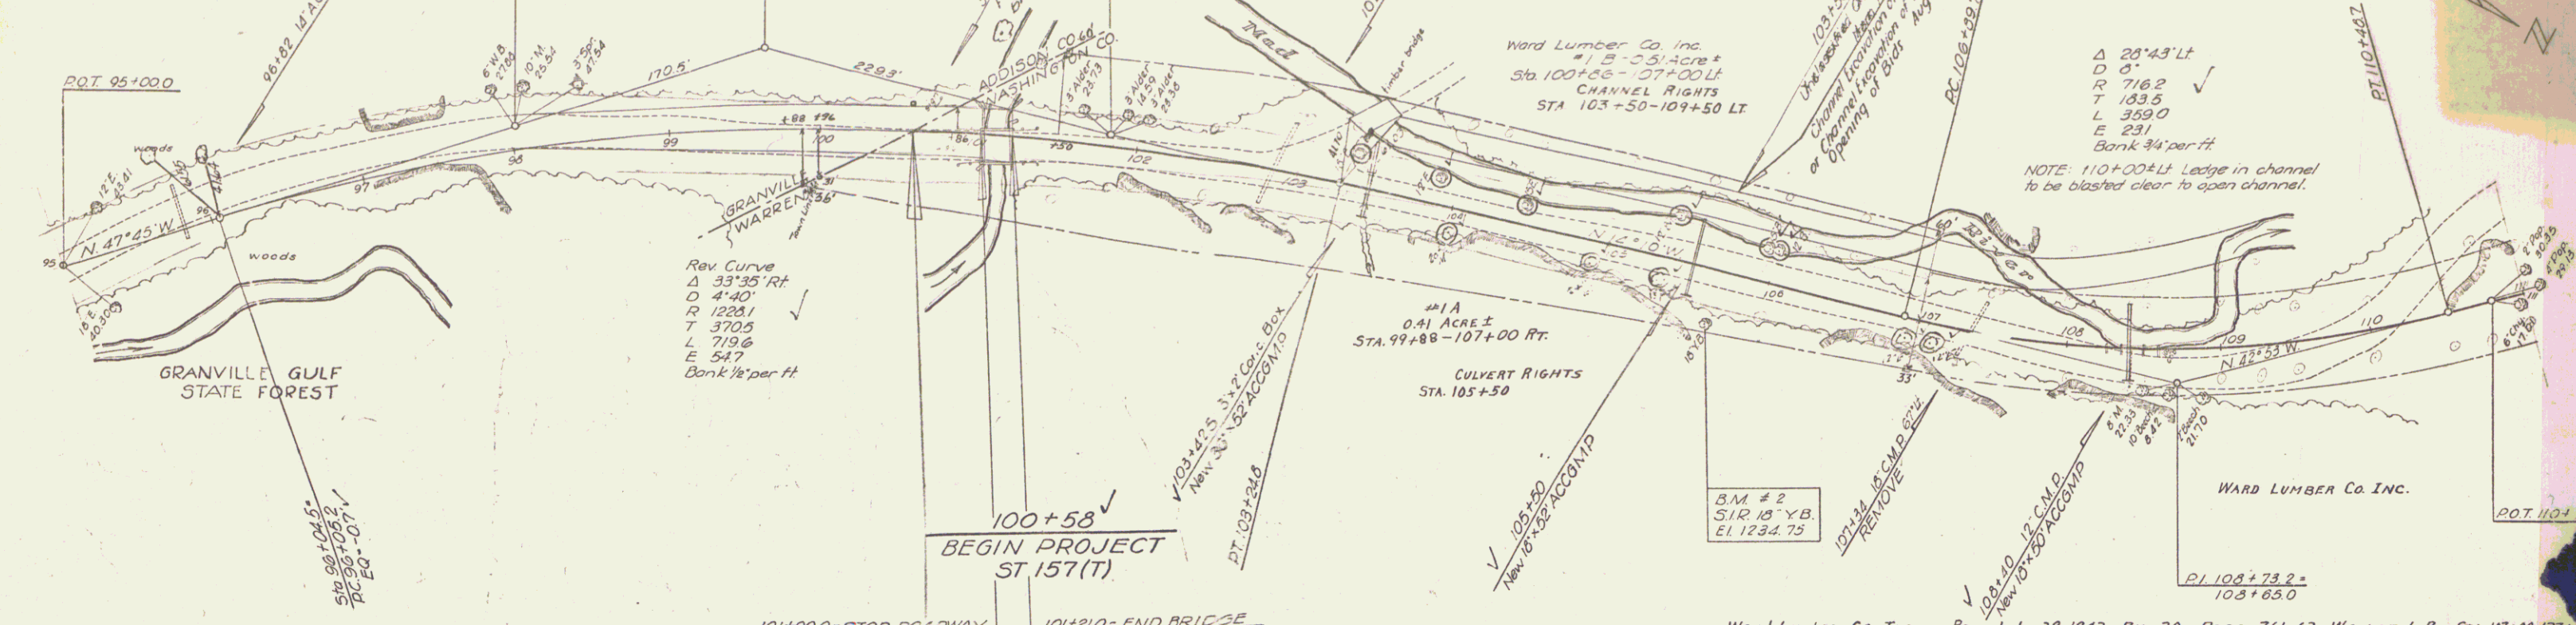

WARD LUMBER Co, Inc. Rec. July 29, 1942, Bk. 20 Page 361-62 Warren L.R. Sta. 101+00-123+00

PARCEL INSTRUMENT DATE GRANTEE GRANTEE RECORDED TOWN OF BOOK PAGE DATE REMARKS
 1A, B, C, D, E, F, G, H, I, J, K, L, M, N, O, P, Q, R, S, T, U, V, W, X, Y, Z
 1005 7-23-42 Ward Lumber Co, Inc. ST. 157T Warren 20 361-362 7-29-42 (This covers an easement for highway purposes sh. land between 107+00-123+00)



ESTIMATED QUANTITIES FOR BRIDGE ONLY

QUANTITY	UNIT	ITEM	ITEM NO.
44	C.Y.	UNCLASSIFIED CHANNEL EXCAVATION (INCLUDES 4 C.Y. OVERRUN)	106-C
108	C.Y.	STRUCTURE EXCAVATION (INCLUDES 10 C.Y. OVERRUN)	107
8	TONS	BITUMINOUS CONCRETE PAVEMENT FOR BRIDGE FLOORS	363
98	C.Y.	CONCRETE CLASS B (INCLUDES 5 C.Y. OVERRUN)	401-B
8500	LBS	REINFORCING STEEL	402
100	LBS	STRUCTURAL STEEL	404-A
1	L.S.	TEMPORARY BRIDGE	441
1	L.S.	REMOVAL OF PRESENT SUPERSTRUCTURE	442
42	L.F.	THREE CABLE GUARD RAIL WITH STEEL POSTS	543
42	L.F.	GRANITE BRIDGE CURB, TYPE #1	556-C

- LIST OF SHEETS FOR BRIDGE ONLY
- 11 B & PROFILE (THIS SHEET)
 - 23 S STRUCTURE DETAILS
 - 24 A EMENT # 1 DETAILS
 - 25 A EMENT # 2 DETAILS
 - 26 REINFORCING STEEL SHEET
 - 103 CHANNEL SECTIONS
 - 38 DAY STANDARD SHEET RS 56-11
 - 32 STANDARD SHEET SD 50-58 (DETAILS A VIEW B & K)
 - 39 WAY STANDARD SHEET RS 56-12

