


PLAN	11-56
SECTION	11-56
DATE	11-56
BY	W. J. CHANDLER
REVISED	7-56

PROVINCE	ONTARIO
COUNTY	WARREN
TOWNSHIP	WARREN
RANGE	15
SECTION	15

PARCEL	INSTRUMENT	DATE	GRANTOR	GRANTEE	RECORDED	BOOK	PAGE	DATE	REMARKS
2	W.P.O.E.	9-7-56	Clyde E. Baslow	St. of Vt.	Warren	22	510-511	11-1-56	
3A, B	Cond.	7-2-56	Lottie Gates & Kathryn Martin	St. of Vt.	Warren	15	367-372	7-6-56	See also sheet 16
4	O.C.B.	7-6-56	Daniel W. Austin	St. of Vt.	Warren	15	387-388	11-1-56	
5	Cond.	7-2-56	Ulysses G. Austin Estate, Isabelle Austin Randall & Madelyn Austin Homel	St. of Vt.	Warren	15	367-372	7-6-56	See also sheets 16 & 17

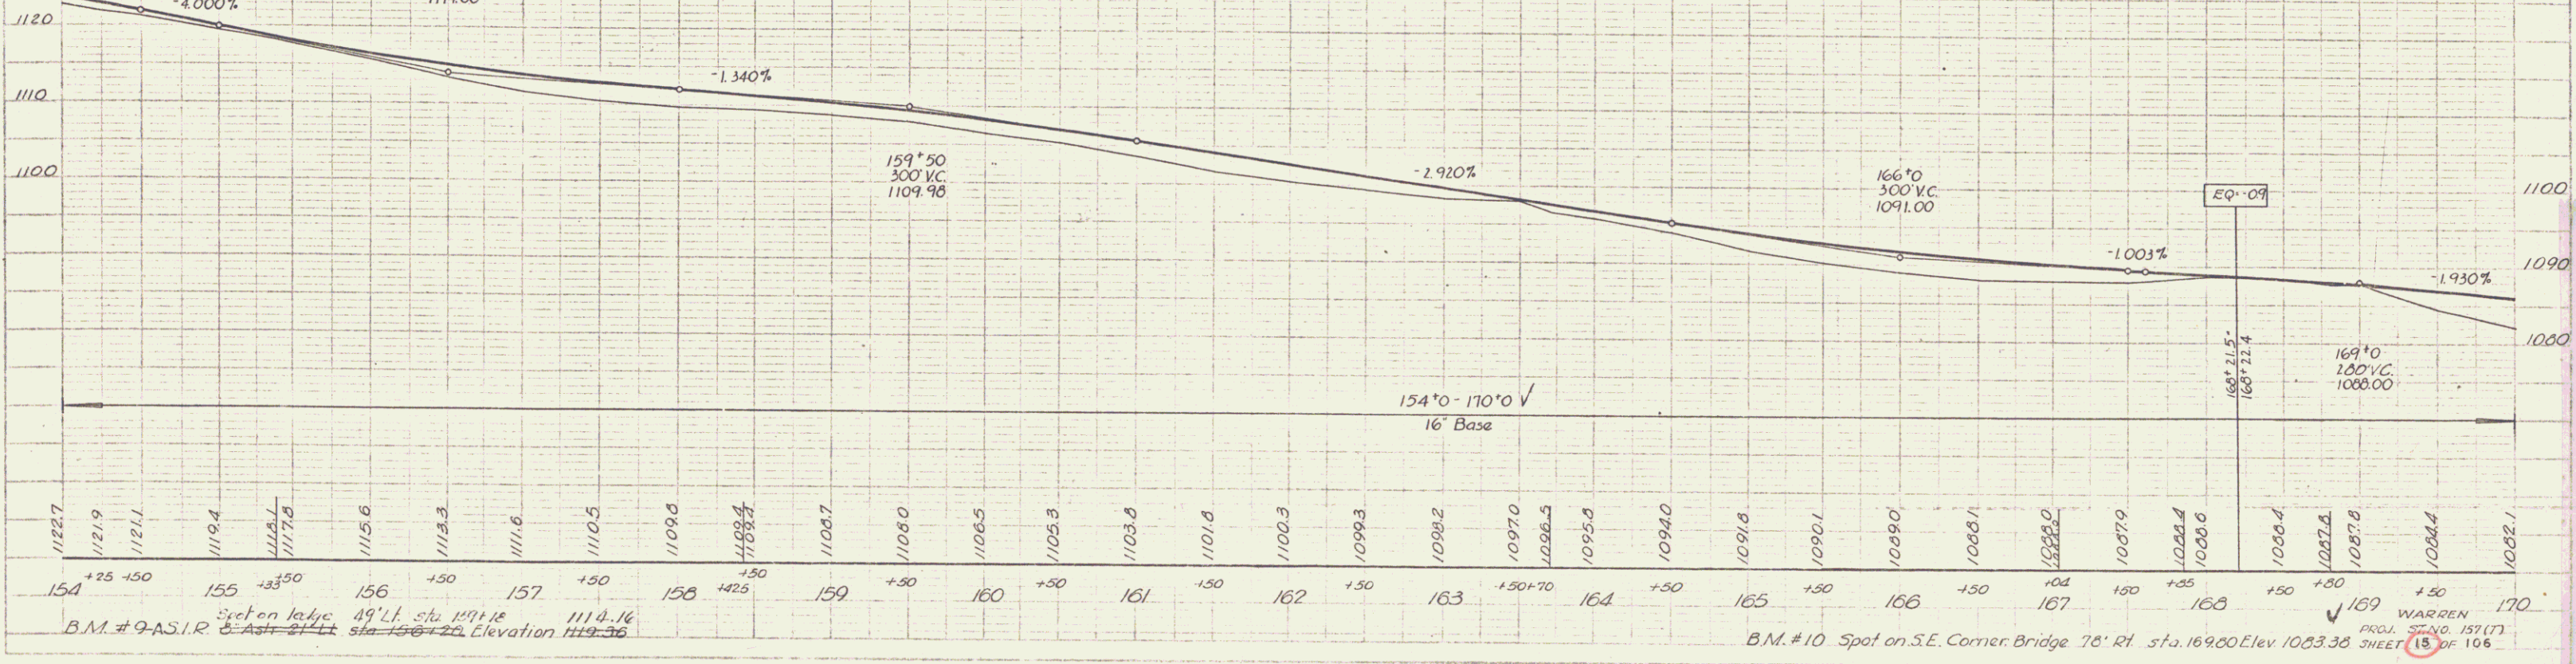

B.M. # 9 A.S.I.R. Spot on bridge 49' Lt. Sta. 159+18 Elevation 1114.16
 Section taken 49' Lt. Sta. 159+18 Elevation 1114.16

B.M. # 10 Spot on S.E. Corner Bridge 78' Rt. Sta. 169+00 Elev. 1083.38
 REG. STA. 157 (7) SHEET 15 OF 106

16