


PLAN  
 DATE 11-56  
 DRAWN BY [unclear]  
 CHECKED BY [unclear]  
 SCALE 1" = 40'

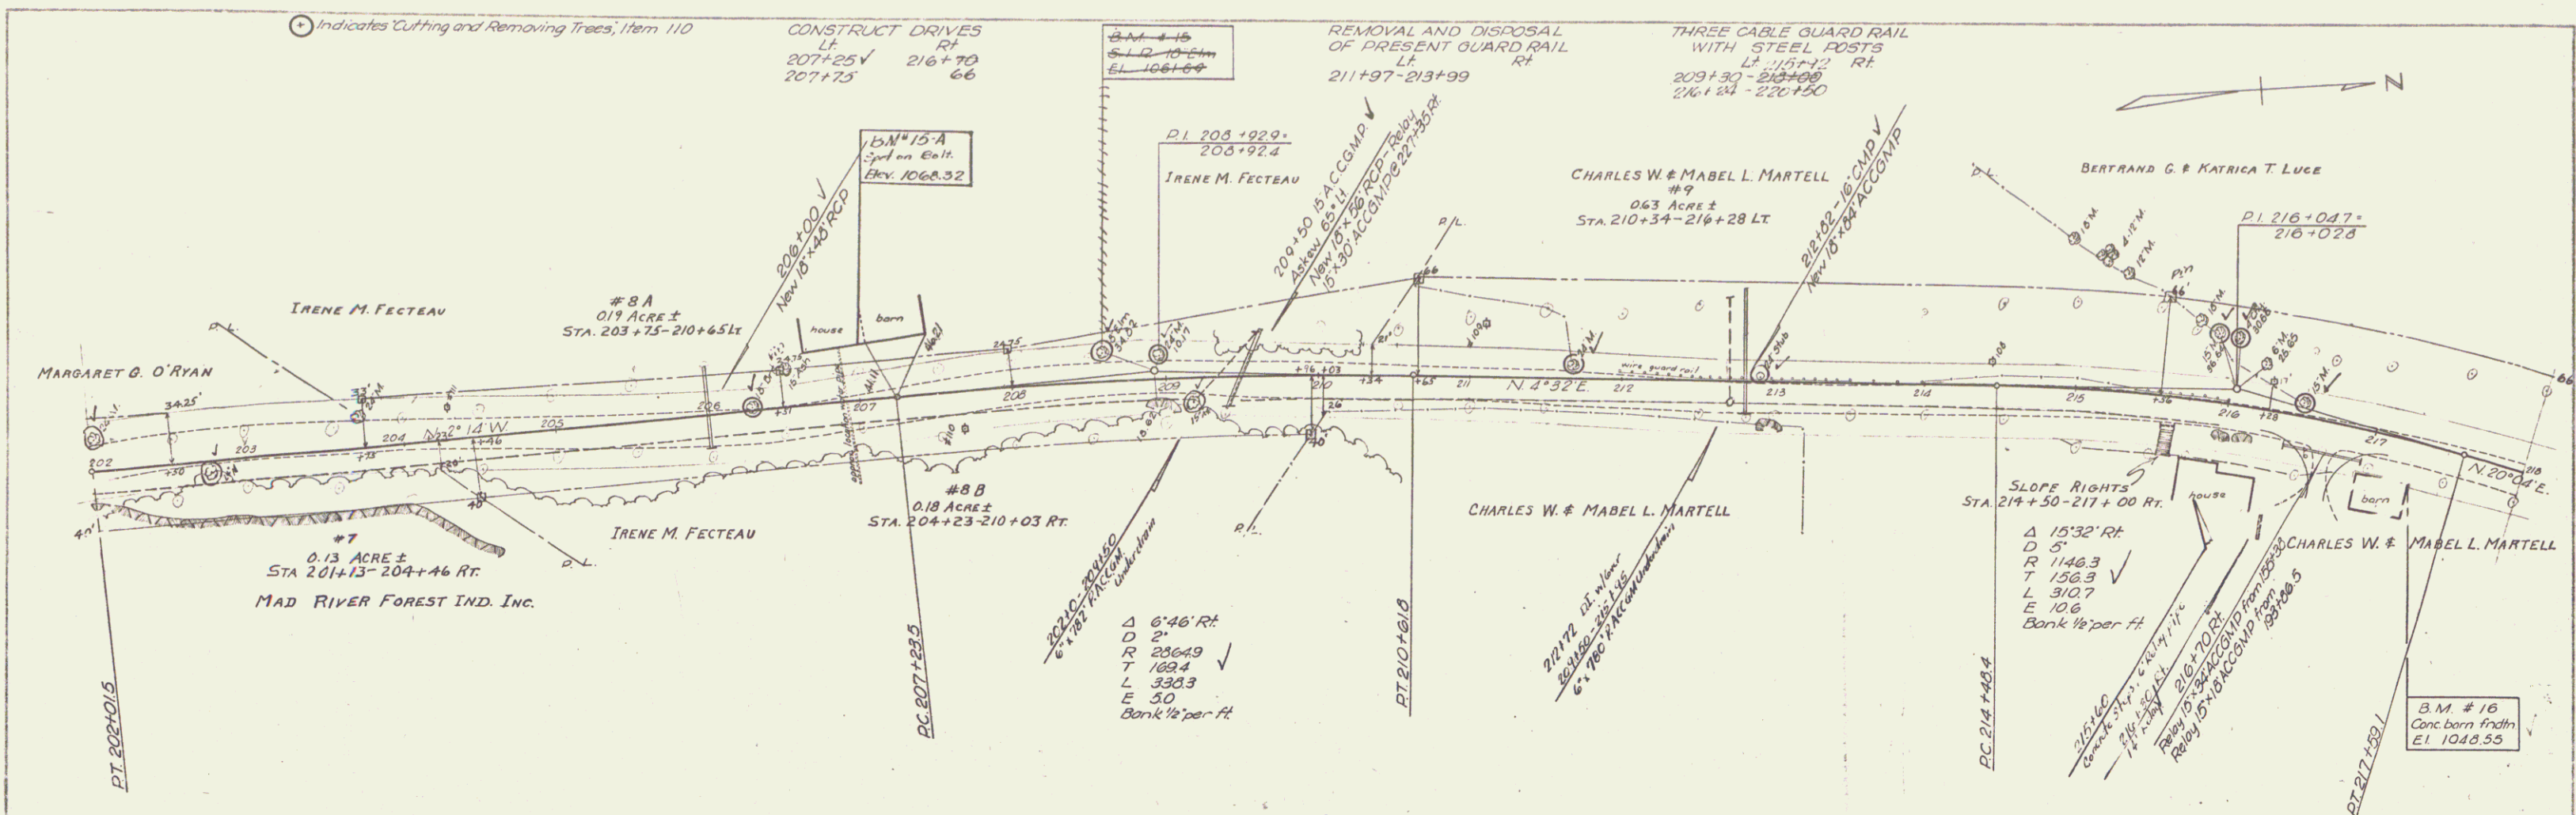

PROFILE  
 DATE 11-56  
 DRAWN BY [unclear]  
 CHECKED BY [unclear]  
 SCALE 1" = 40'

