

INDEX OF SHEETS

SHEET NO.	TITLE PAGE
1	TITLE PAGE
2	TYPICAL CROSS SECTION OF IMPROVEMENT (DOUBLE TACK COAT OF REFINED TAR)
3	ROADWAY STANDARD SHEET RS 56-1 (BANKING) WITH PEASTONE SEAL, ITEM 312-A
4	QUANTITY SHEET (ITEMS)
5	QUANTITY SHEET (DRAINAGE)
6-10	EARTHWORK SHEETS
11-22	PLAN & PROFILE SHEETS
23	SUPERSTRUCTURE DETAILS BRIDGE STA. 101+00-101+21
24	DETAILS ABUTMENT #1 BRIDGE STA. 101+00-101+21
25	DETAILS ABUTMENT #2 BRIDGE STA. 101+00-101+21
26	REINFORCING STEEL SCHEDULE BRIDGE STA. 101+00-101+21
27	DETAILS ABUTMENT #1 BRIDGE STA. 178+80-179+64
28	DETAILS ABUTMENT #2
29	SUPERSTRUCTURE DETAILS
30	SUPERSTRUCTURE LAYOUT
31	REINFORCING STEEL SCHEDULE
32	BRIDGE STD. SHEET SB-20-56, DET. A,B,C,D,F OR G,H,K
33	BRIDGE STD. SHEET SB-56-2
34	ROADWAY STANDARD SHEET RS 56-3
35	" " " " -4
36	" " " " -6
37	" " " " -9
38	" " " " -11
39	" " " " -12
40-102	CROSS SECTIONS
103-106	CHANNEL SECTIONS

STATE OF VERMONT DEPARTMENT OF HIGHWAYS

PROPOSED IMPROVEMENT

FEDERAL AID SECONDARY PROJECT

TOWN OF WARREN

COUNTY OF WASHINGTON

WARREN - GRANVILLE ROAD

VERMONT ROUTE 100


BEGINNING AT THE GRANVILLE - WARREN TOWN LINE ON VT. RTE. 100 AND EXTENDING NORTHERLY 3.22 MILES

LENGTH OF ROADWAY 16,842.2 FEET = 3.190 MILES

LENGTH OF BRIDGE 84.0 FEET = 0.016 MILES


LENGTH OF PROJECT 16,926.2 FEET = 3.2057 MILES

PER ROAD DISTRICT NO.	STATE PROJECT NO.	SHEET NO.	TOTAL SHEETS
VT	ST157T	1	106

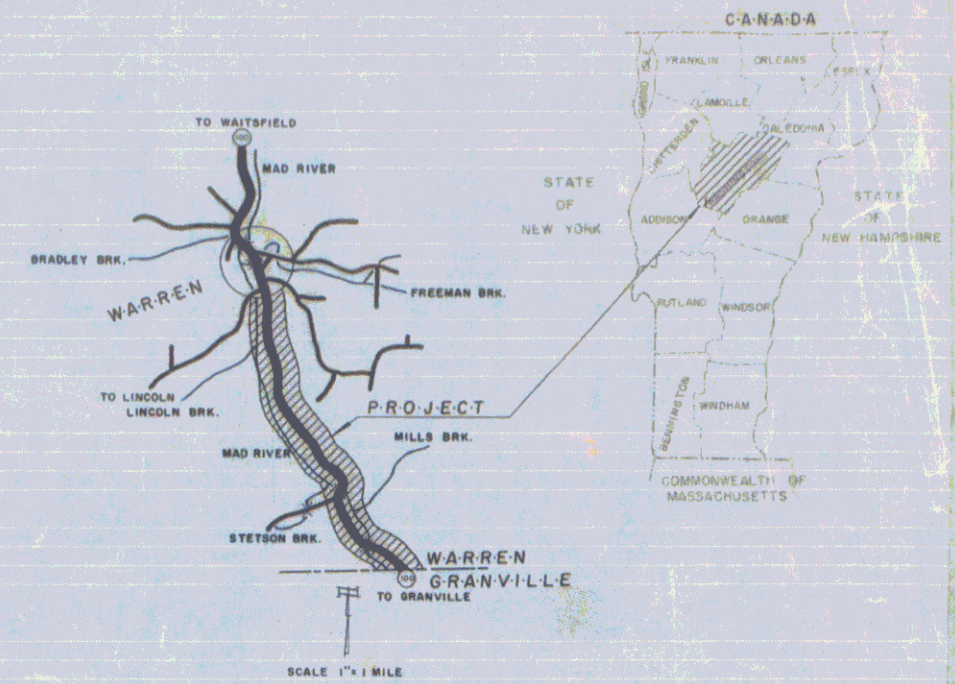

Project Name & Number	Notes	Drawn Area
Warren ST-157(T)	30,29854	
<i>Revised Plans</i>		
<i>Mileage</i>		
Sub base of gravel	As per M.P.P. in original plan	
Crushed gravel	As per M.P.P. in original plan	
Reinforced concrete	As per M.P.P. in original plan	
Structural steel	As per M.P.P. in original plan	
Concrete Class B	As per M.P.P. in original plan	
Asphalt concrete	As per M.P.P. in original plan	
Contractor	W. J. Smith	Construction started September 1956
Inspector	W. J. Smith	Construction completed September 1956

Date: 08/22/1956
 Project: ST157T
 Pin: 00R617

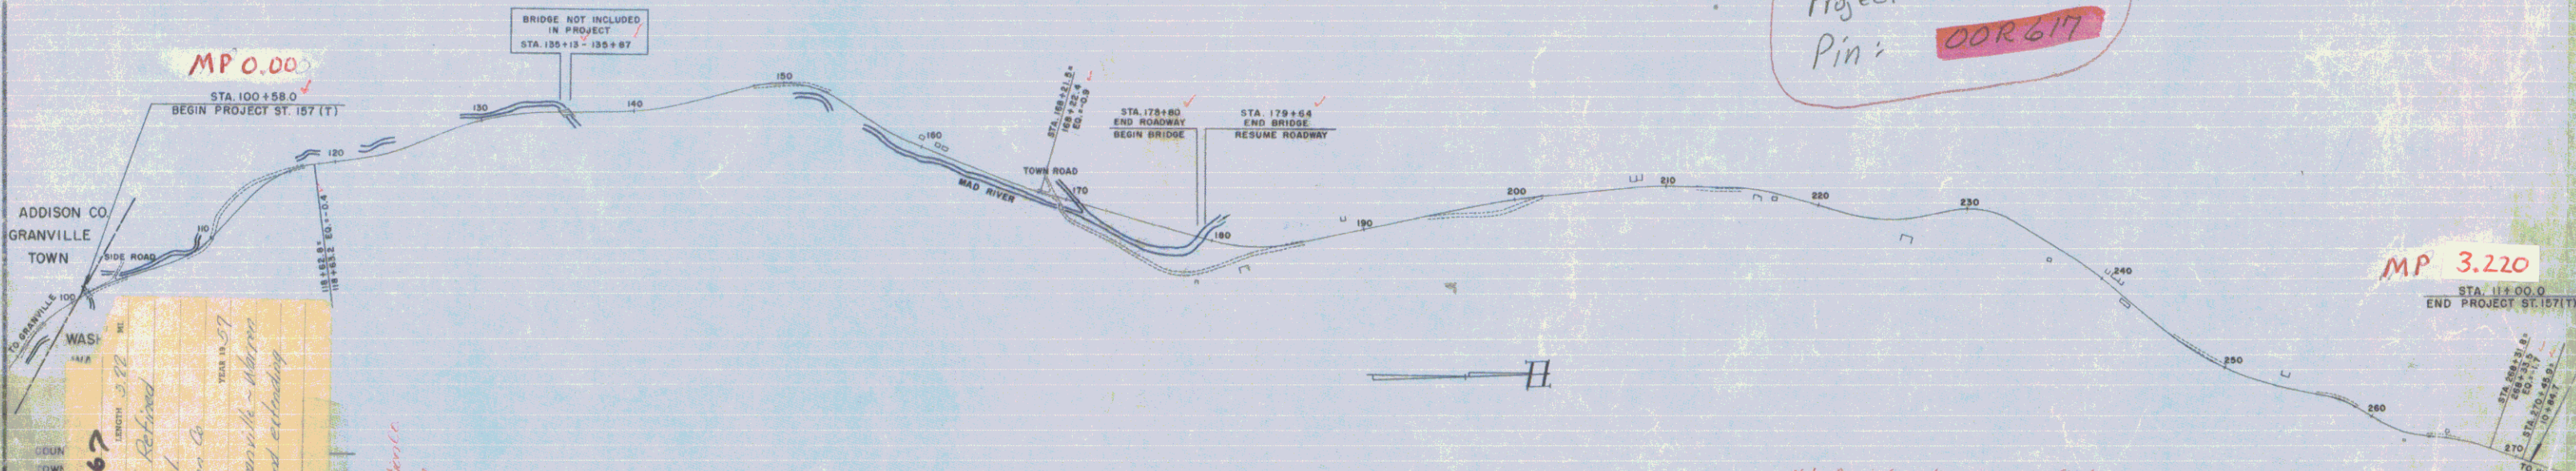

WARREN

ST-157(T)
 Double Tack Coat of Refined Tar
 Top of Peastone Seal
 Construction Co.
 Location: Beginning of the Warren - Granville - Warren Road
 Length: 12 miles

GROUND ELEVATION	DATUM	LINE
GRADE ELEVATION	DATUM	LINE
CURVE DATA		
DEFLECTION OF ANGLE	Δ	
DEGREE OF CURVE	D	
RADIUS OF CURVE	R	
TANGENT DISTANCE	T	
LENGTH OF CURVE	L	
EXTERNAL DISTANCE	E	
POINT OF INTERSECTION	P.I.	
POINT OF CURVE	P.C.	
POINT OF TANGENT	P.T.	
POINT ON TANGENT	P.O.T.	
POINT ON SUB-TANGENT	P.O.S.T.	



SCALES	
TITLE	1" = 500'
TYPICAL	1" = 2'
PLAN	1" = 50'
PROFILE HORIZONTAL	1" = 50'
PROFILE VERTICAL	1" = 10'
CROSS-SECTIONS	1" = 10'

Note: Any information concerning final quantities, amounts or other details relative to this project may be found in either the field books or the estimate file.

THESE PLANS ARE SUBJECT TO SUCH REVISIONS AS MAY BE REQUIRED BY THE BUREAU OF PUBLIC ROADS OR THE COMMISSIONER OF HIGHWAYS.
 CONSTRUCTION IS TO BE CARRIED ON IN ACCORDANCE WITH THE PLANS AND THE STANDARD ROAD AND BRIDGE SPECIFICATIONS BY THE BUREAU OF PUBLIC ROADS, INCLUDING ALL SUBSEQUENT APPROVED REVISIONS AND SUCH REVISED SPECIFICATIONS AND SPECIAL PROVISIONS AS ARE SUBMITTED WITH THE PLANS.

APPROVED DISTRICT ENGINEER DATE Aug 12, 1956	APPROVED BRIDGE ENGINEER DATE Aug 19, 1956	APPROVED DISTRICT ENGINEER DATE Aug 22, 1956	APPROVED HIGHWAY ENGINEER DATE Aug 10, 1956	APPROVED DATE Aug 25, 1956
DEPARTMENT OF COMMERCE BUREAU OF PUBLIC ROADS				
APPROVED				
DISTRICT ENGINEER				
PROJECT ST. NO. 157(T)				
SHEET 1 OF 106 SHEETS				

17-35
 12-35
 1/56
 Surveying
 1/56
 1/56

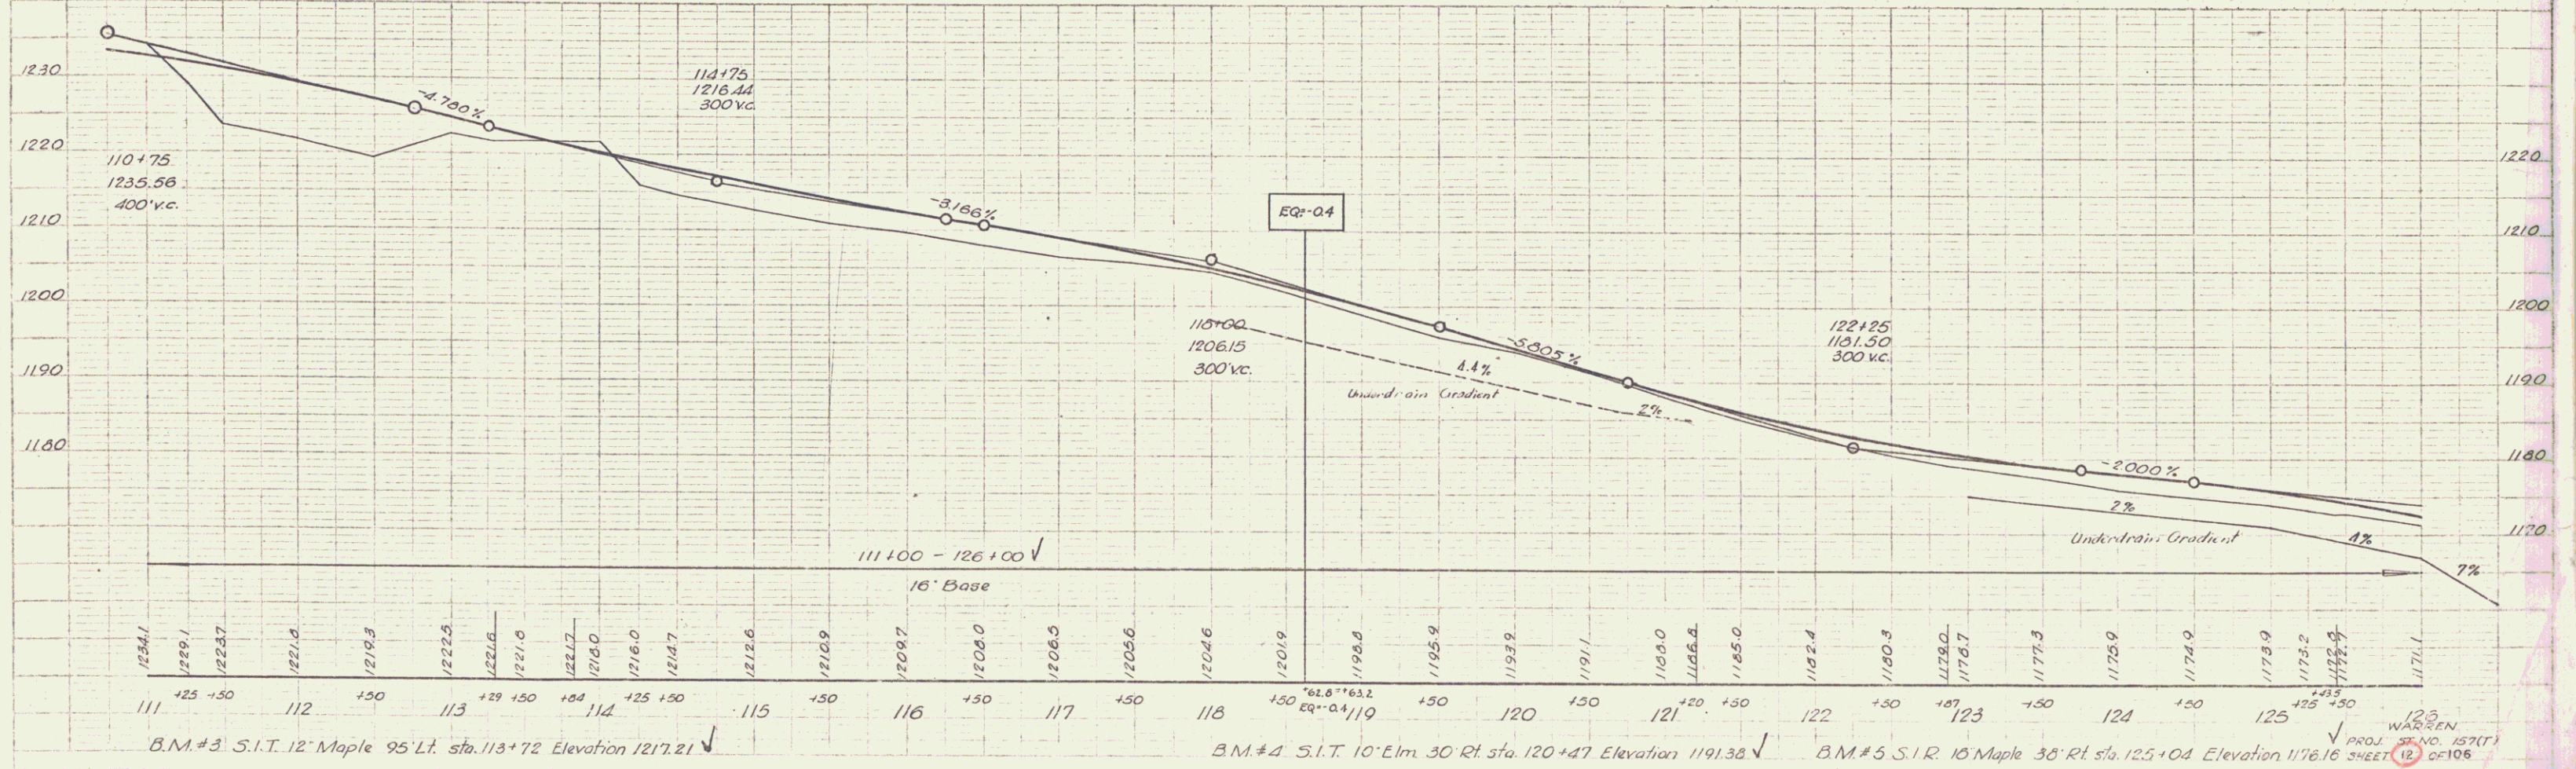
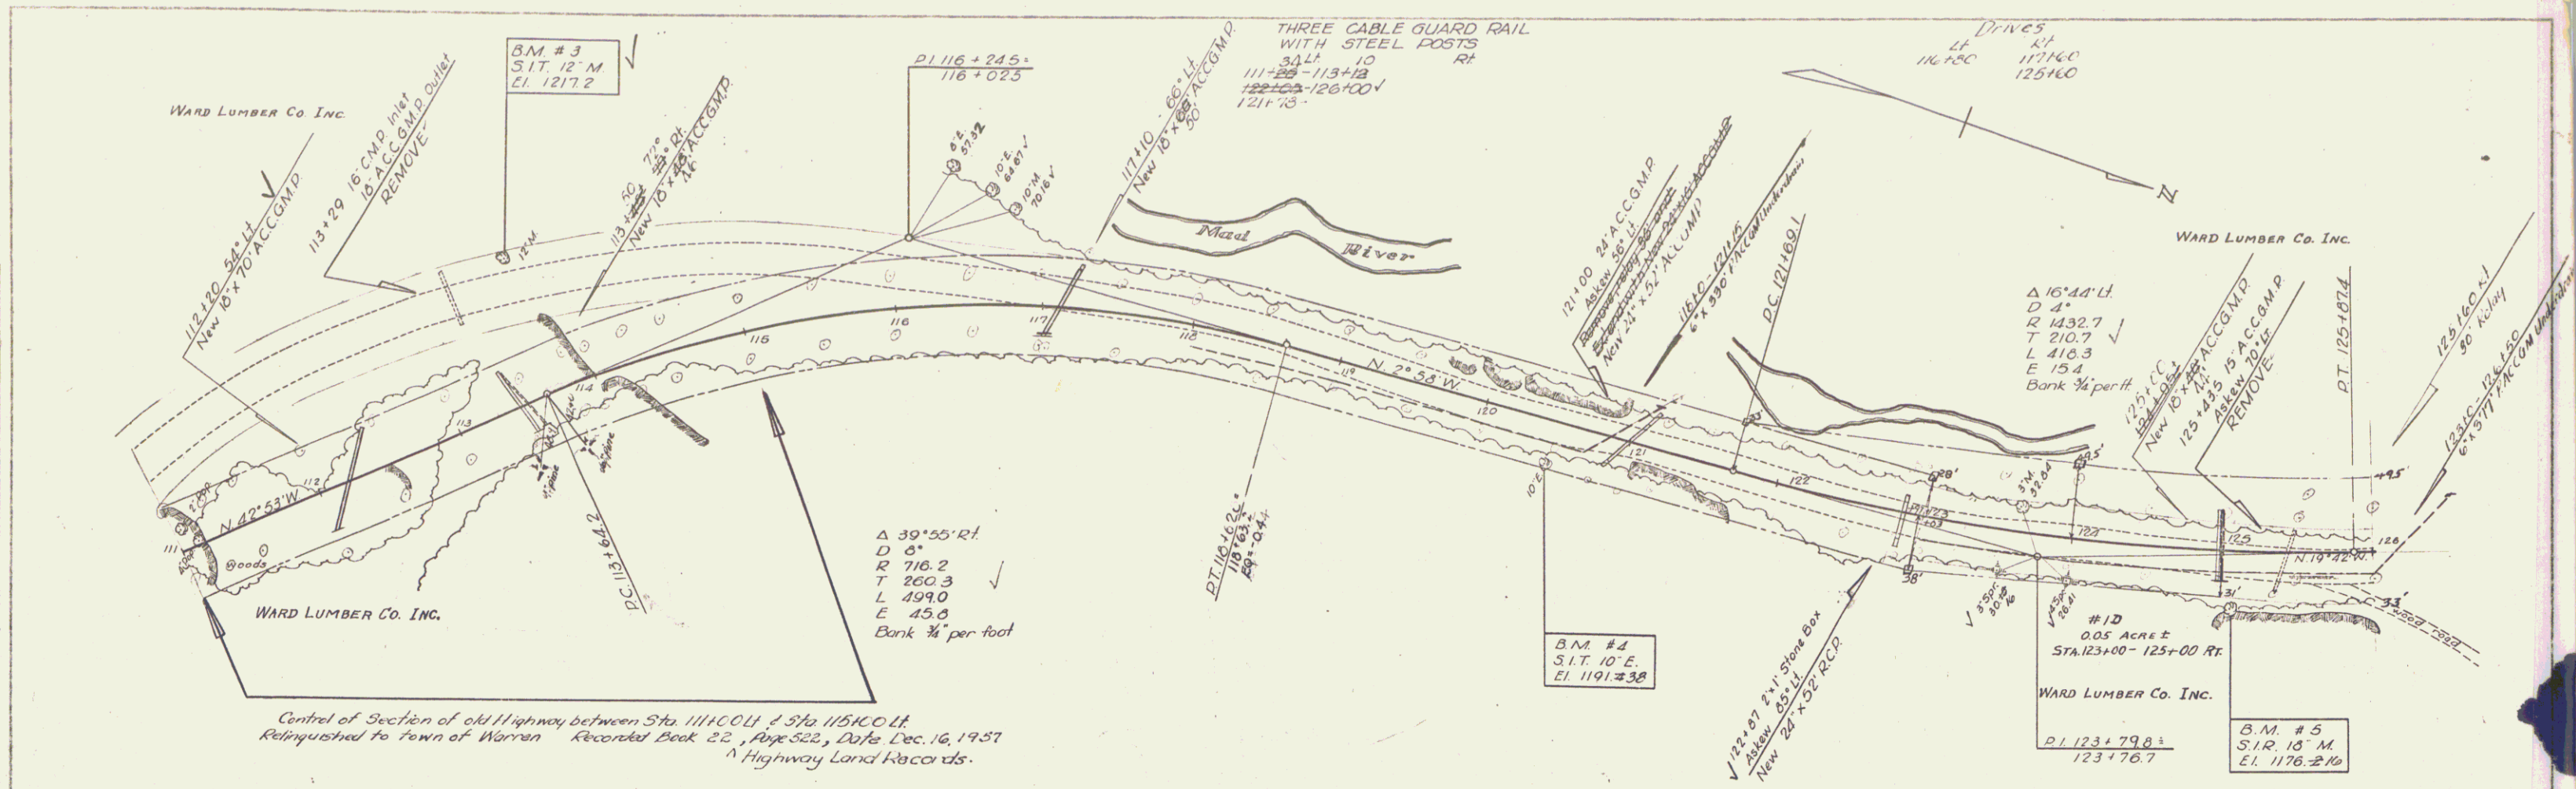


17-35
 12-35
 1/56
 Surveying
 1/56
 1/56

PLAN
 SHOWING
 OPERATING
 W.L.
 TRACED



WARD LUMBER CO. INC.
 PROJECT NO. 157 (T)
 SHEET 13 OF 136


REMOVAL AND DISPOSAL OF PRESENT GUARD RAIL		THREE CABLE GUARD RAIL WITH STEEL POSTS	
STATION	CH	STATION	RT
134+34	135+00	126+00	126+00
134+60	135+27	134+63	135+27
135+78	136+04	135+74	137+28
136+00	137+00	136+00	137+00
		136+86	137+14
		136+18	137+00

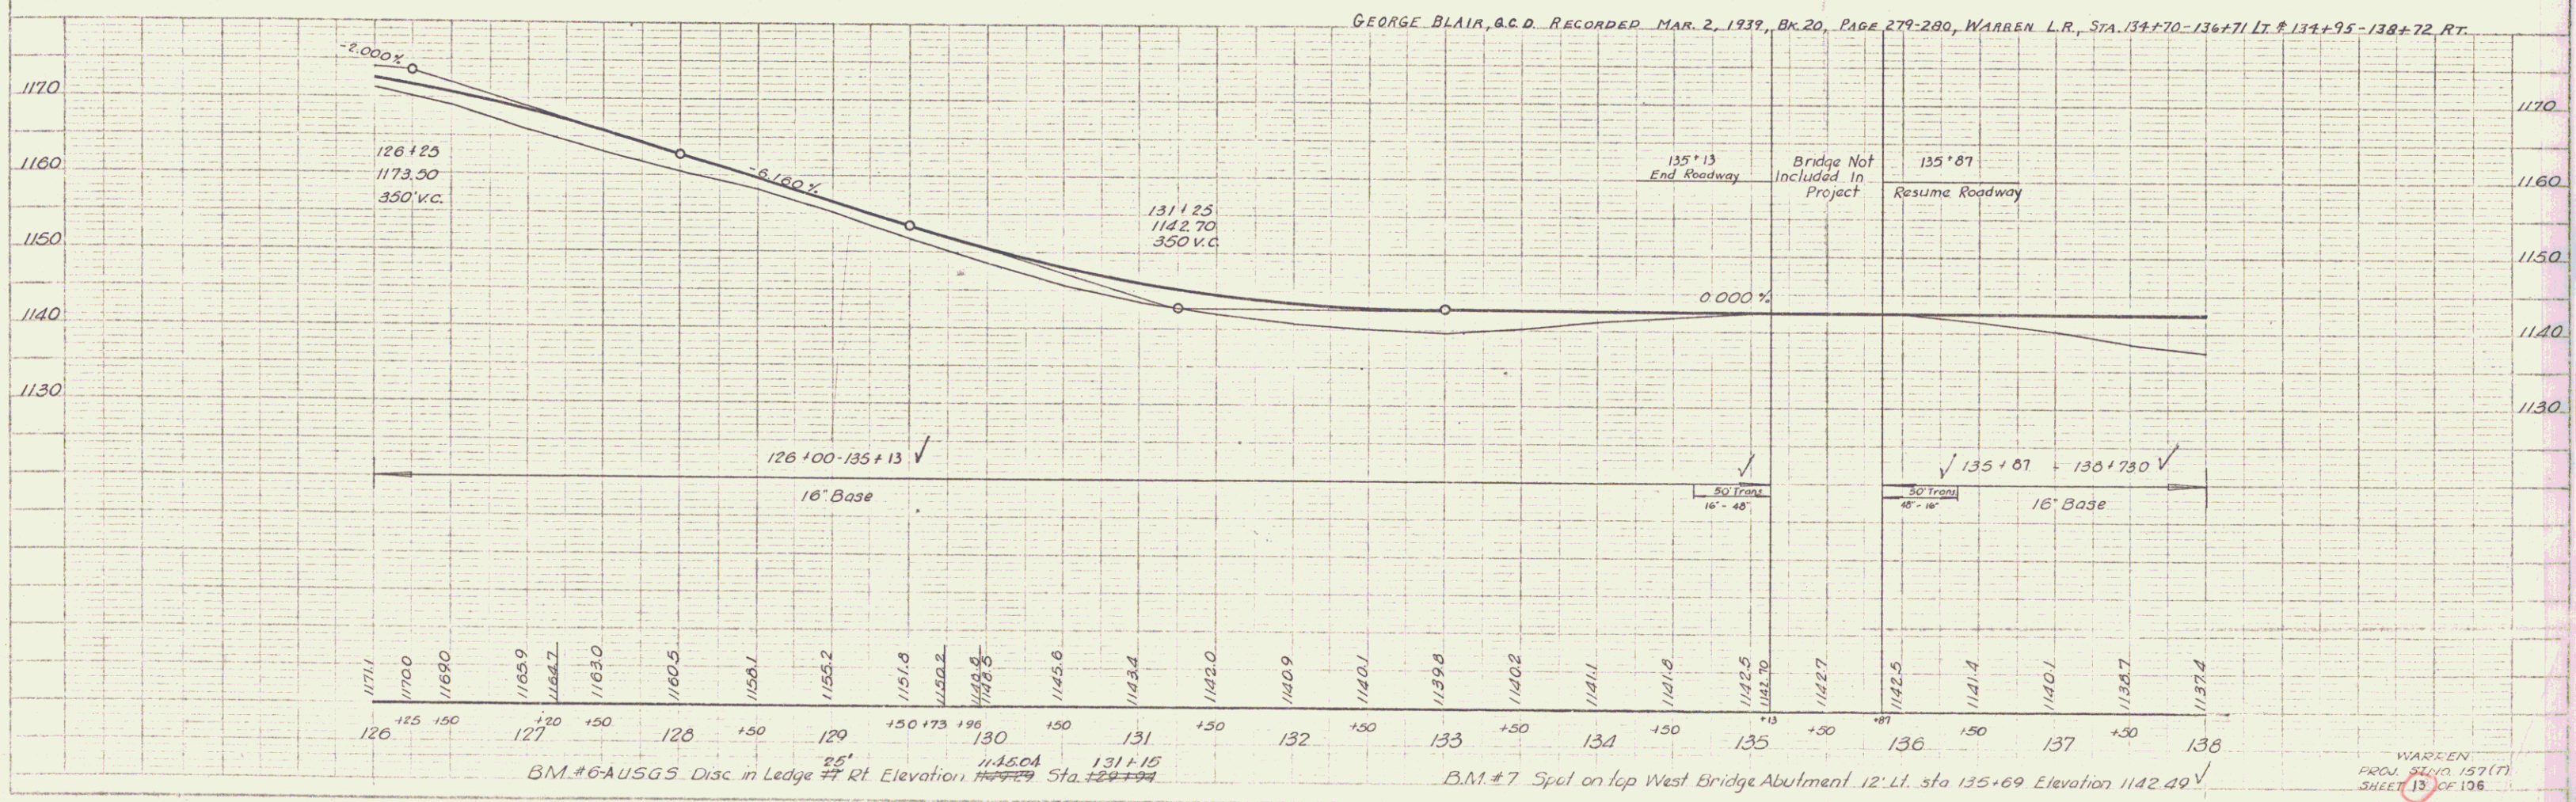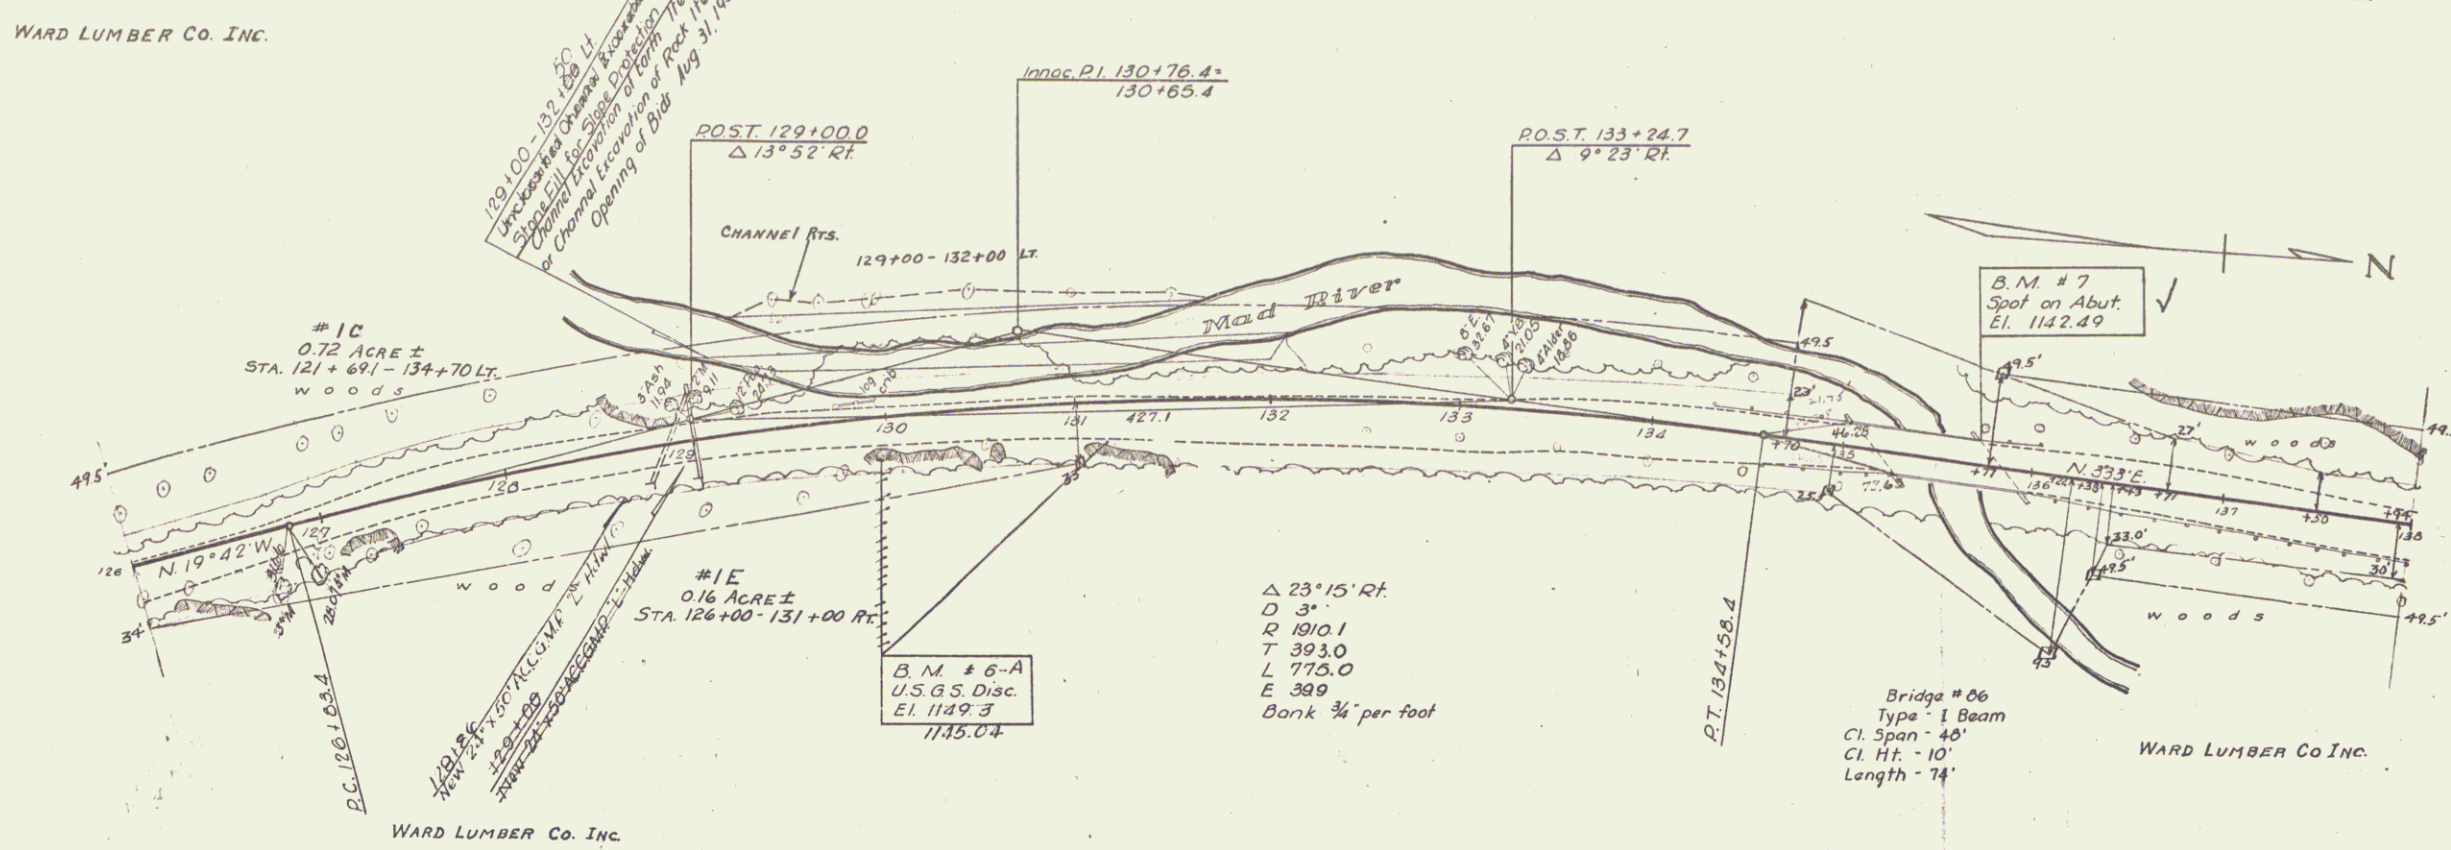

10-55
7-56
Sprockling
WARD LUMBER CO. INC.

10-55
7-56
Sprockling
WARD LUMBER CO. INC.

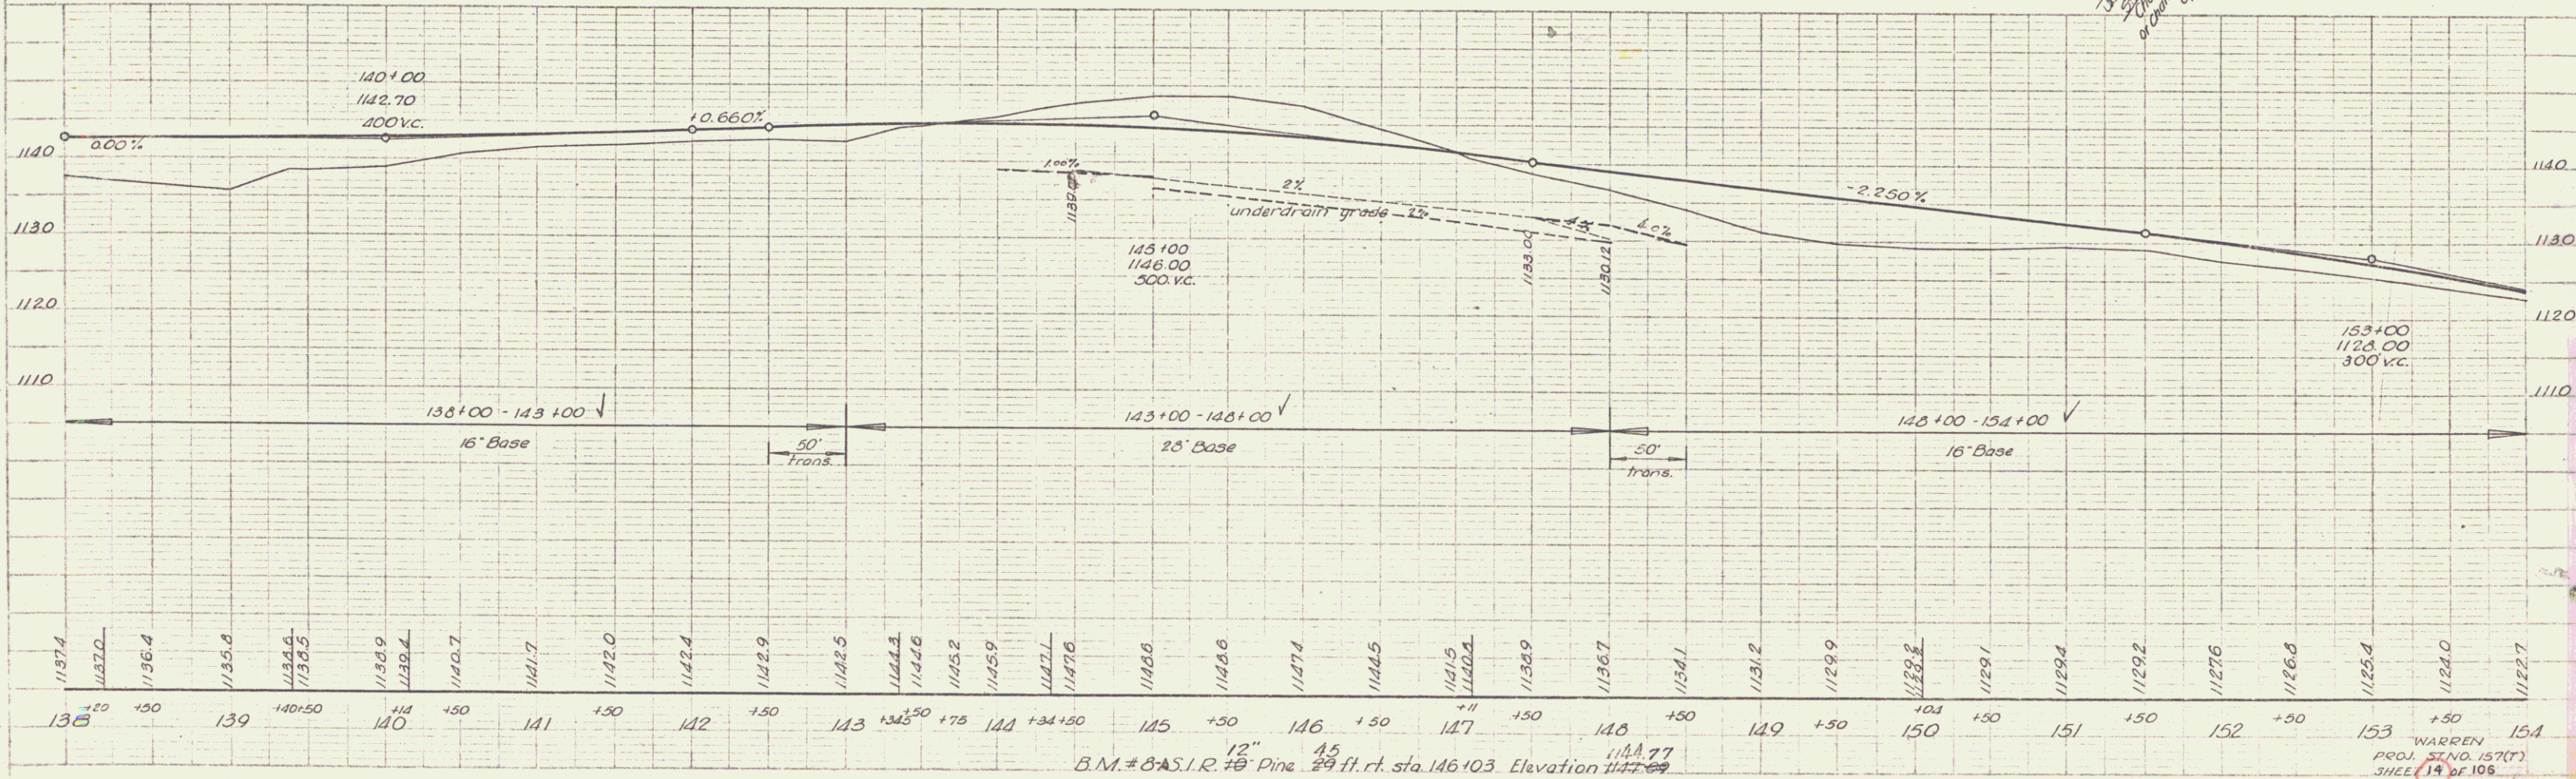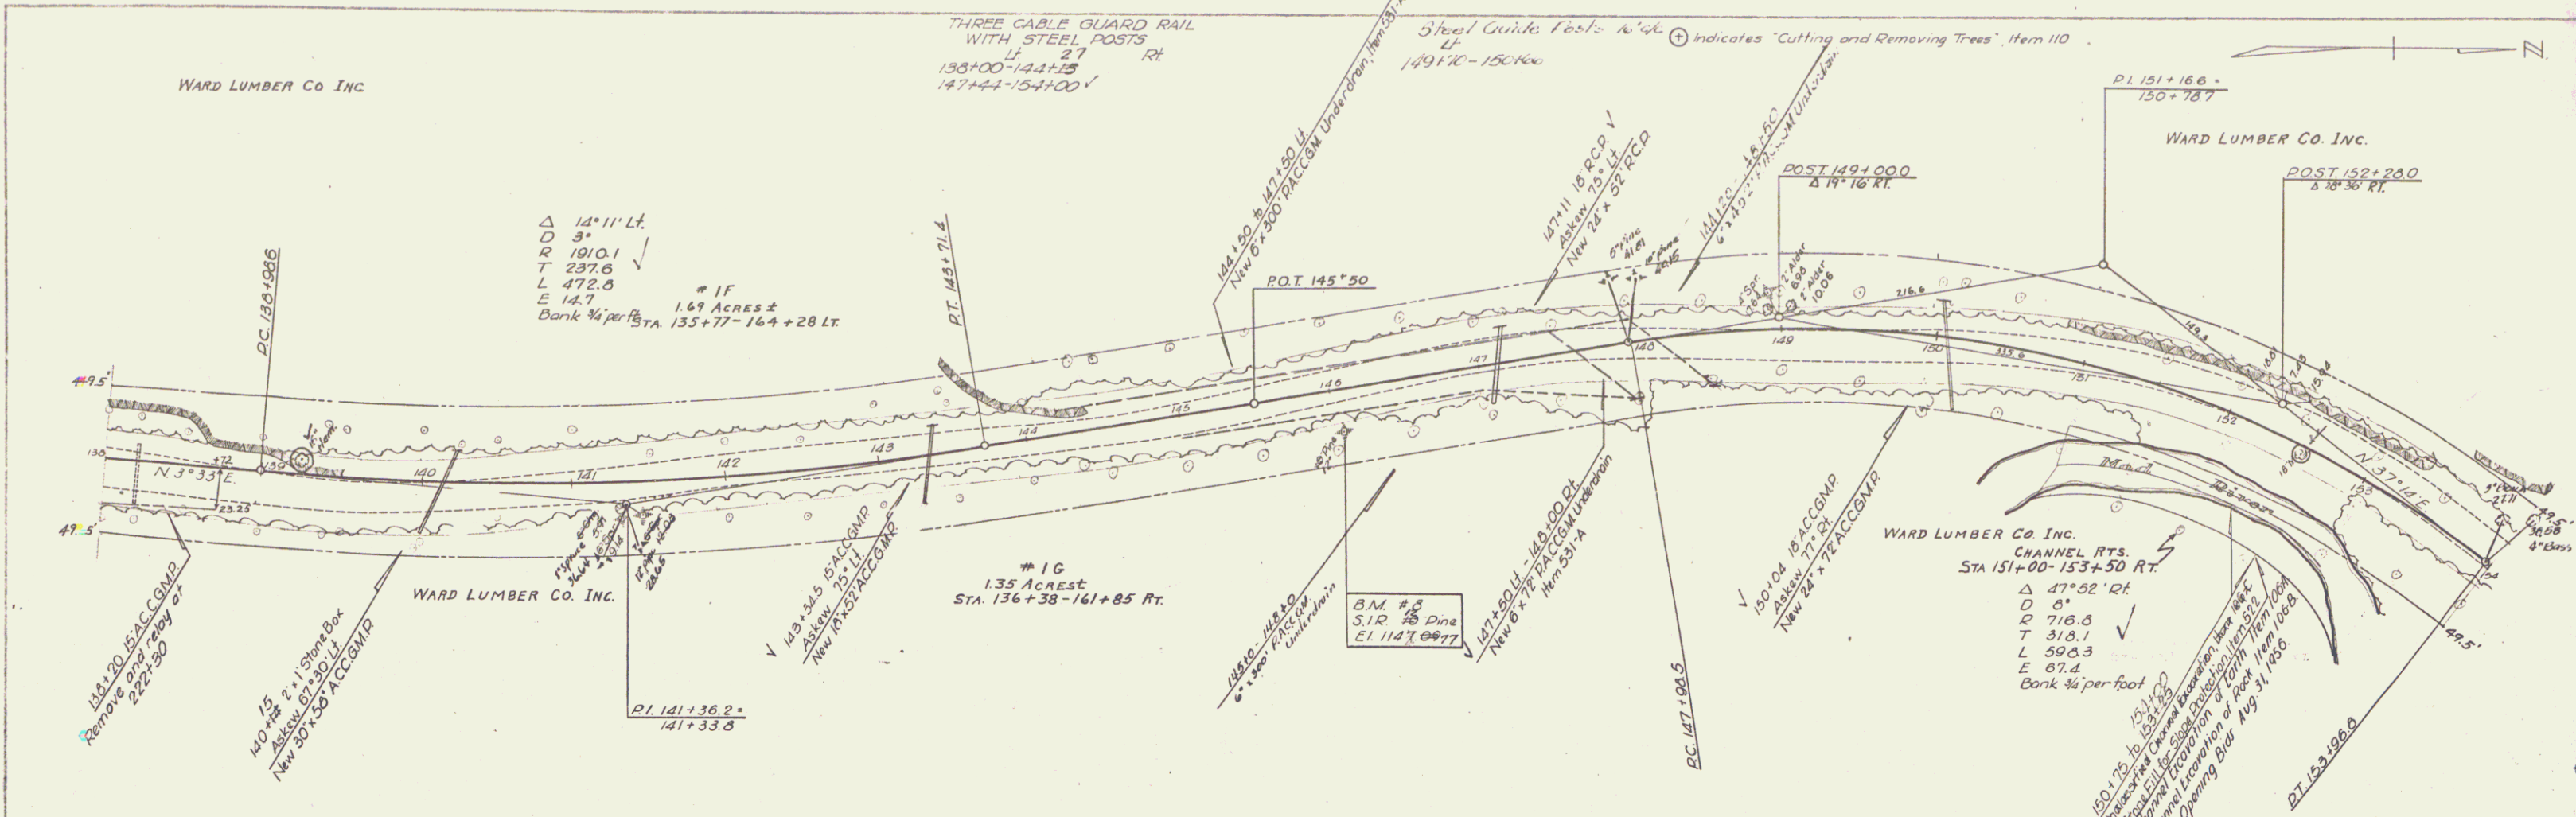


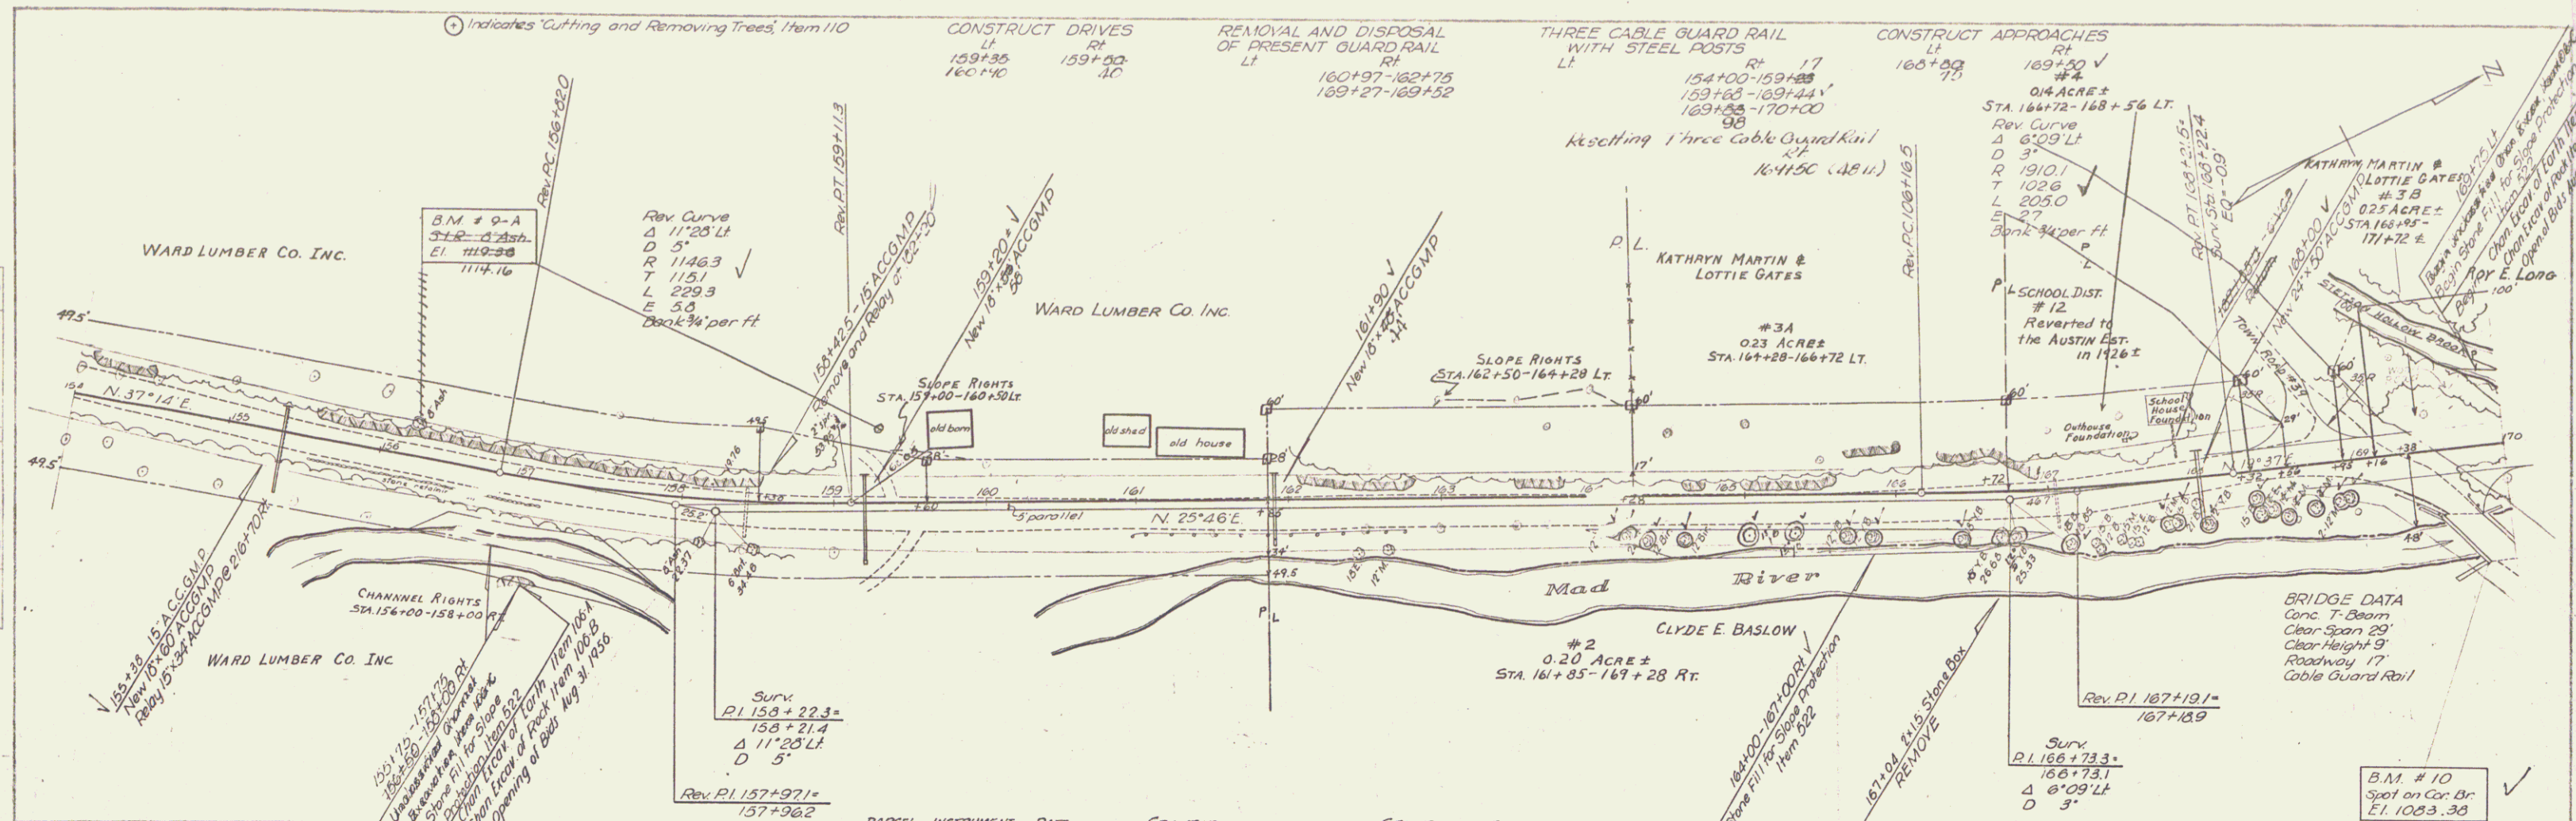

PLV
 DATE
 BY
 CHECKED
 1/15/56
 1/15/56
 7-56

PROVIN
 DATE
 BY
 CHECKED
 1/15/56
 1/15/56
 7-56


PARCEL	INSTRUMENT	DATE	GRANTOR	GRANTEE	RECORDED	BOOK	PAGE	DATE	REMARKS
2	W.D.C.E.	9-7-56	Clyde E. Baslow	St. of Vt.	Warren	22	510-511	11-1-56	
3A, B	Cond.	7-2-56	Lottie Gates & Kathryn Martin	St. of Vt.	Warren	15	367-372	7-6-56	See also sheet 16
4	O.C.B.	7-6-56	Daniel W. Austin	St. of Vt.	Warren	15	387-388	11-1-56	
5	Cond.	7-2-56	Ulysses G. Austin Estate, Isabelle Austin Randall & Madelyn Austin Hornel	St. of Vt.	Warren	15	367-372	7-6-56	See also sheets 16 & 17

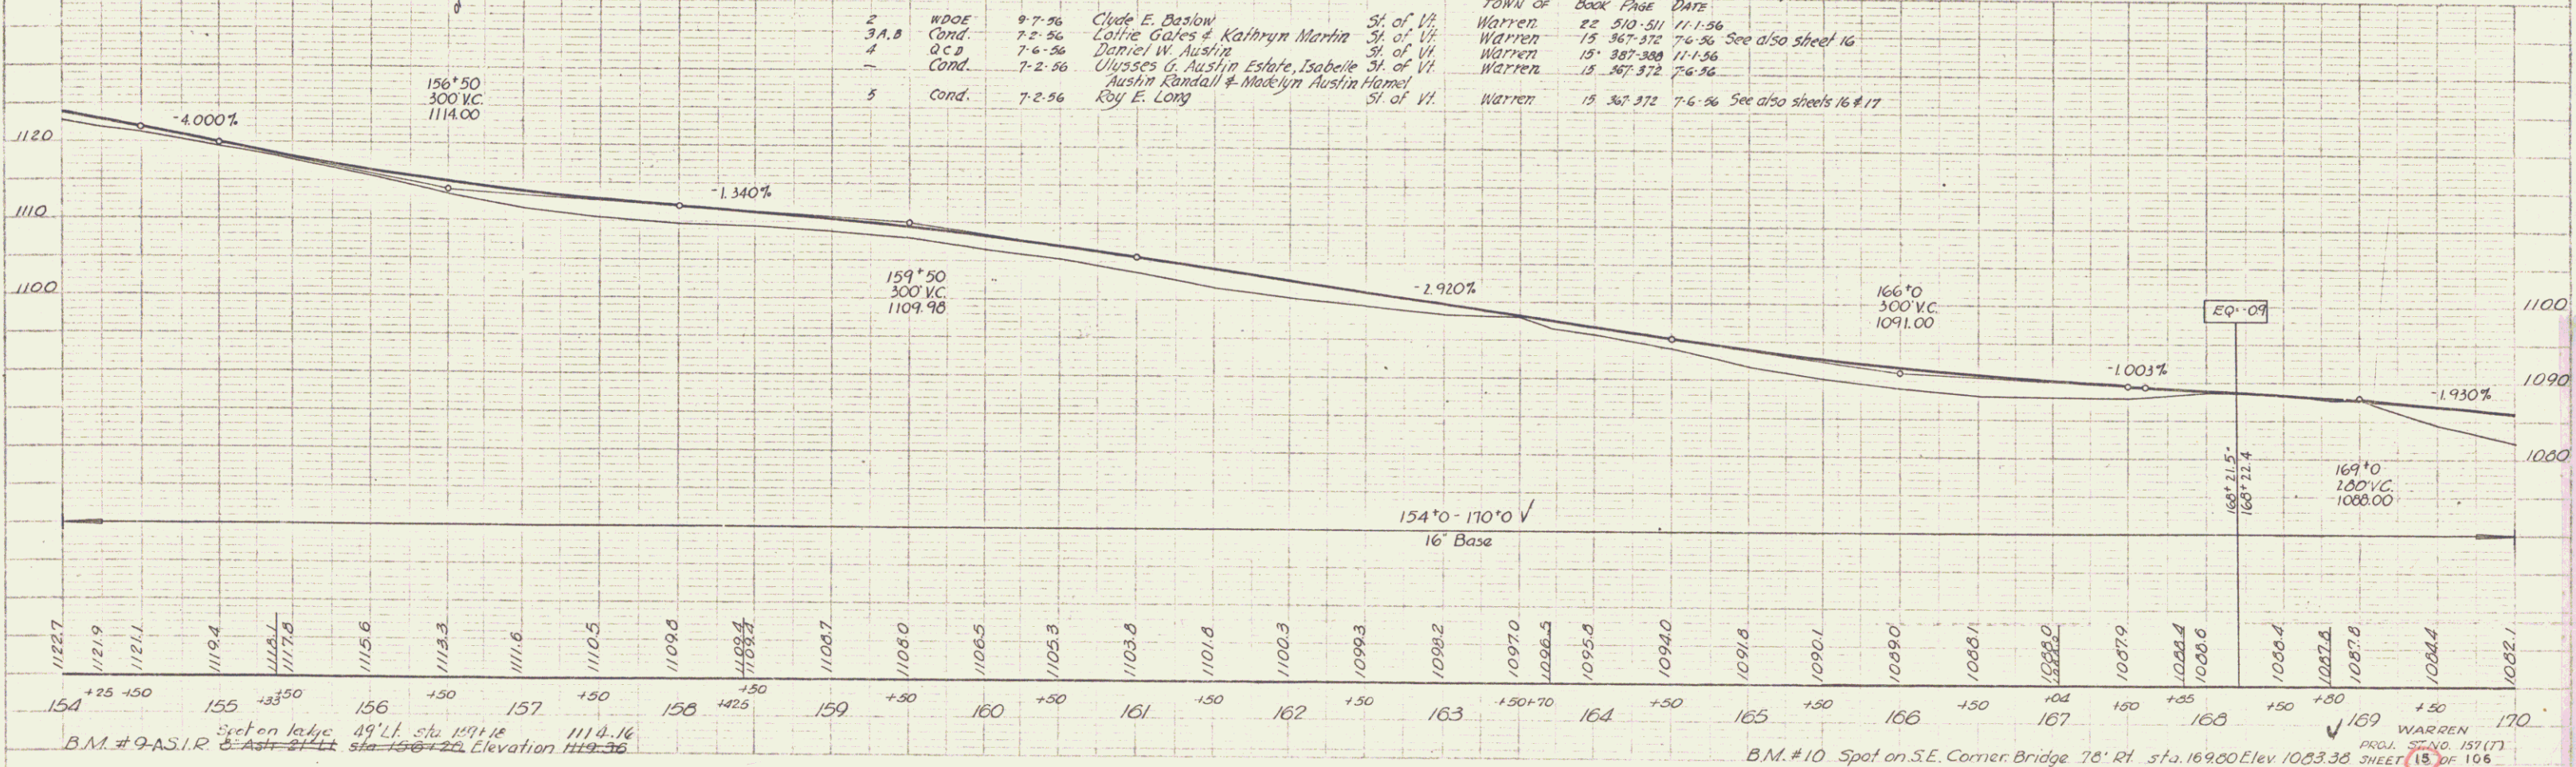

11227
 11219
 11211
 11194
 11175
 11156
 11133
 11116
 11105
 11090
 11074
 11067
 11060
 11065
 11053
 11038
 11018
 11003
 10993
 10982
 10970
 10965
 10958
 10940
 10918
 10901
 10890
 10881
 10860
 10850
 10844
 10835
 10824
 10815
 10804
 10784
 10775
 10764
 10755
 10744
 3
 2
 1


B.M. # 9 A.S.I.R. Spot on S.E. Corner of 49' x 114' 16" lot. Elev. 1114.16

B.M. # 10 Spot on S.E. Corner Bridge 78' x 17' s.t.a. 16900 Elev. 1083.38

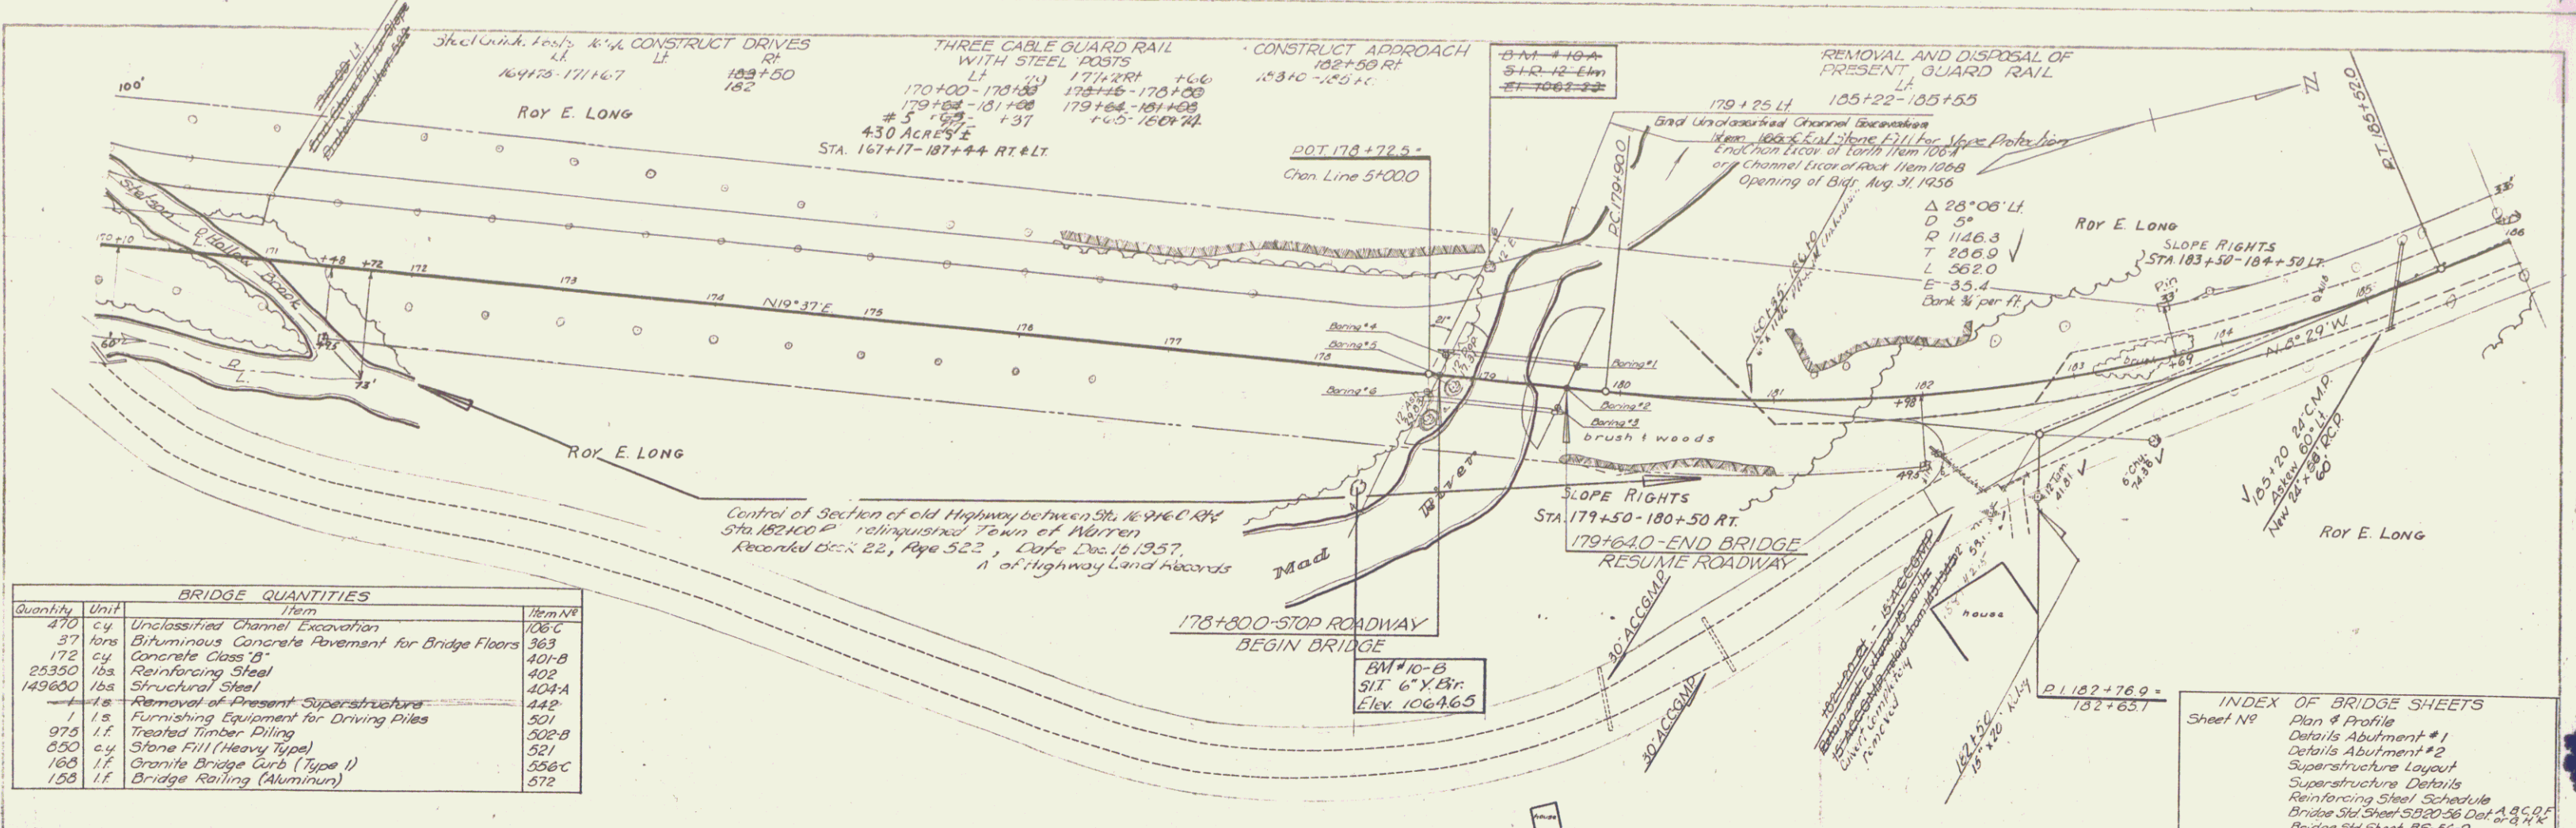


BRIDGE QUANTITIES		
Quantity	Unit	Item
470	c.y.	Unclassified Channel Excavation
37	tons	Bituminous Concrete Pavement for Bridge Floors
72	c.y.	Concrete Class B
23350	lbs.	Reinforcing Steel
149600	lbs.	Structural Steel
1	ls.	Removal of Present Superstructure
1	ls.	Furnishing Equipment for Driving Piles
975	l.f.	Treated Timber Piling
650	c.y.	Stone Fill (Heavy Type)
183	l.f.	Granite Bridge Curb (Type I)
150	l.f.	Bridge Railing (Aluminum)
		106C
		401-B
		402
		403A
		442
		501
		502-B
		521
		556C
		572

INDEX OF BRIDGE SHEETS	
Sheet No.	Plan & Profile
	Details Abutment #1
	Details Abutment #2
	Superstructure Layout
	Superstructure Details
	Reinforcing Steel Schedule
	Bridge Std. Sheet SB-20-56 Det. A, B, C, D, E
	Bridge Std. Sheet BS-56-2
	Channel Sections

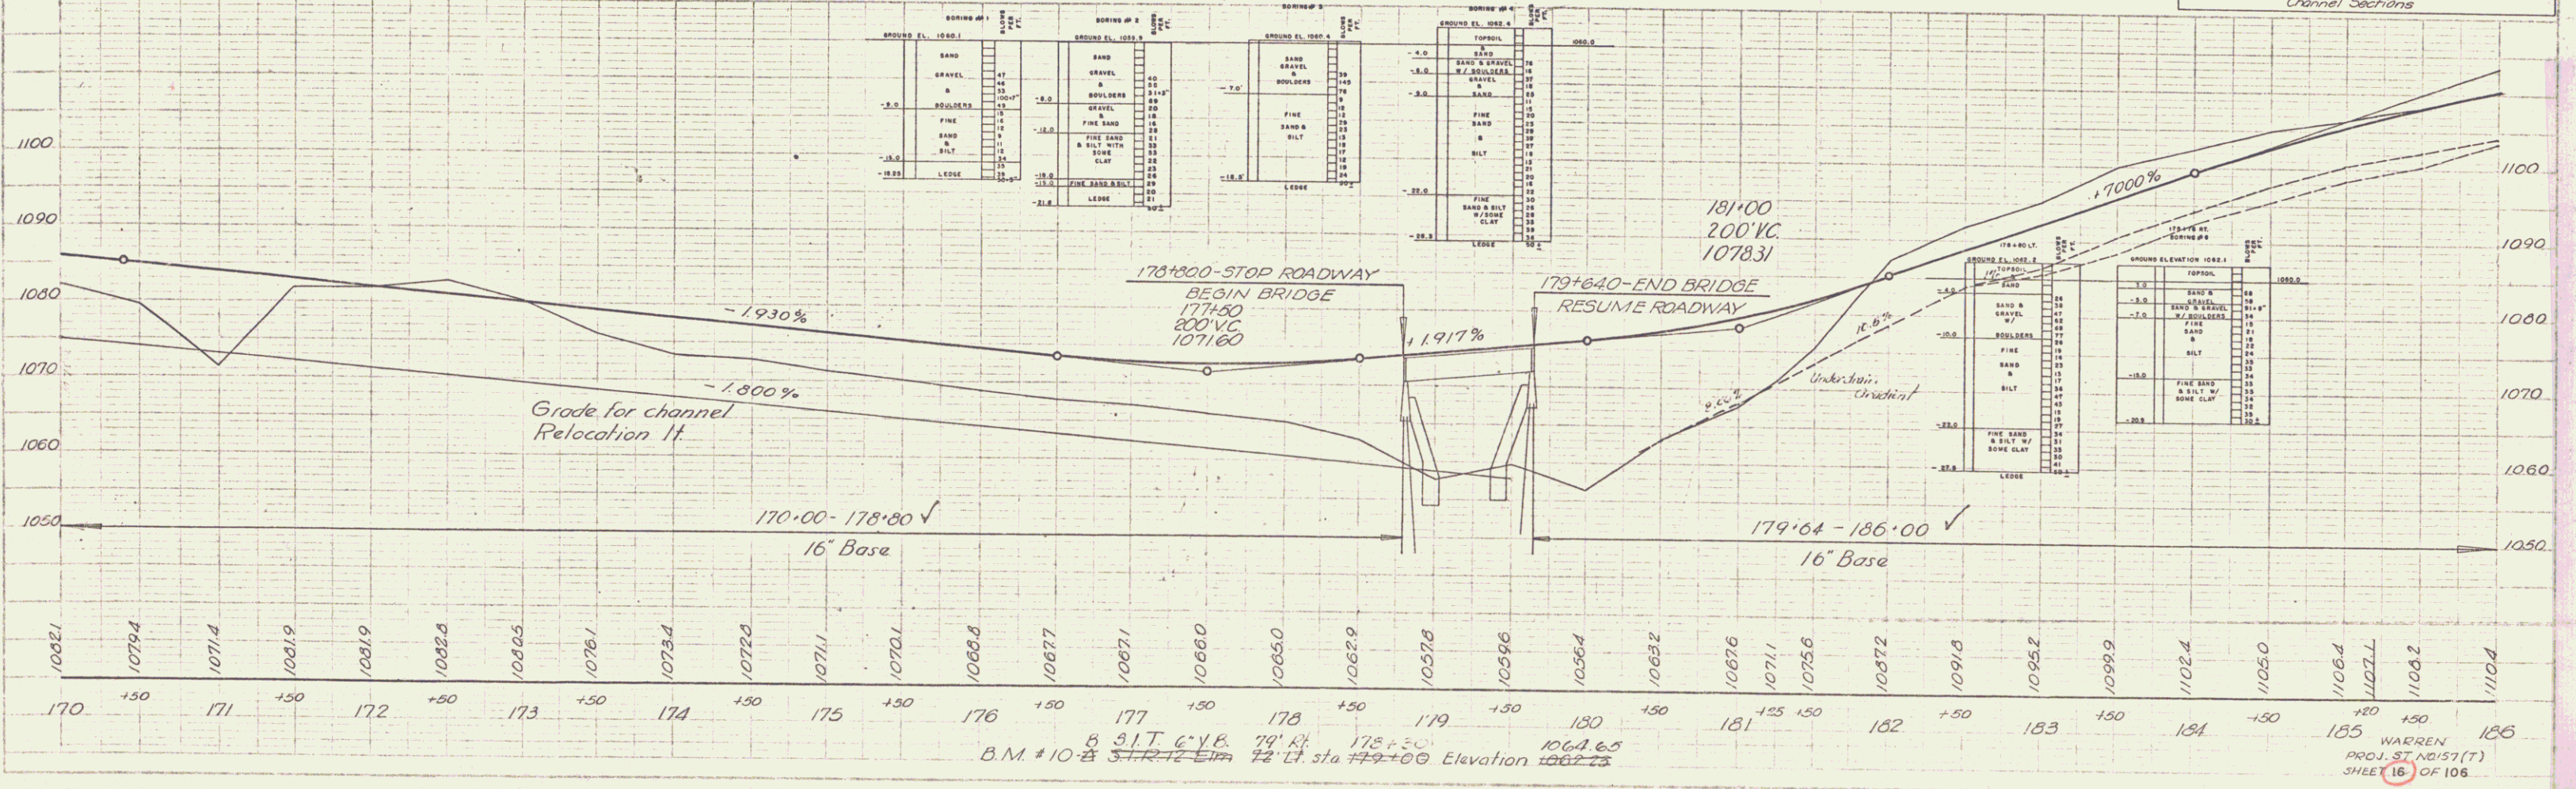


11-53
 1-56
 7-56
 11-53
 1-56
 7-56
 11-53
 1-56
 7-56

11-53
 1-56
 7-56
 11-53
 1-56
 7-56
 11-53
 1-56
 7-56

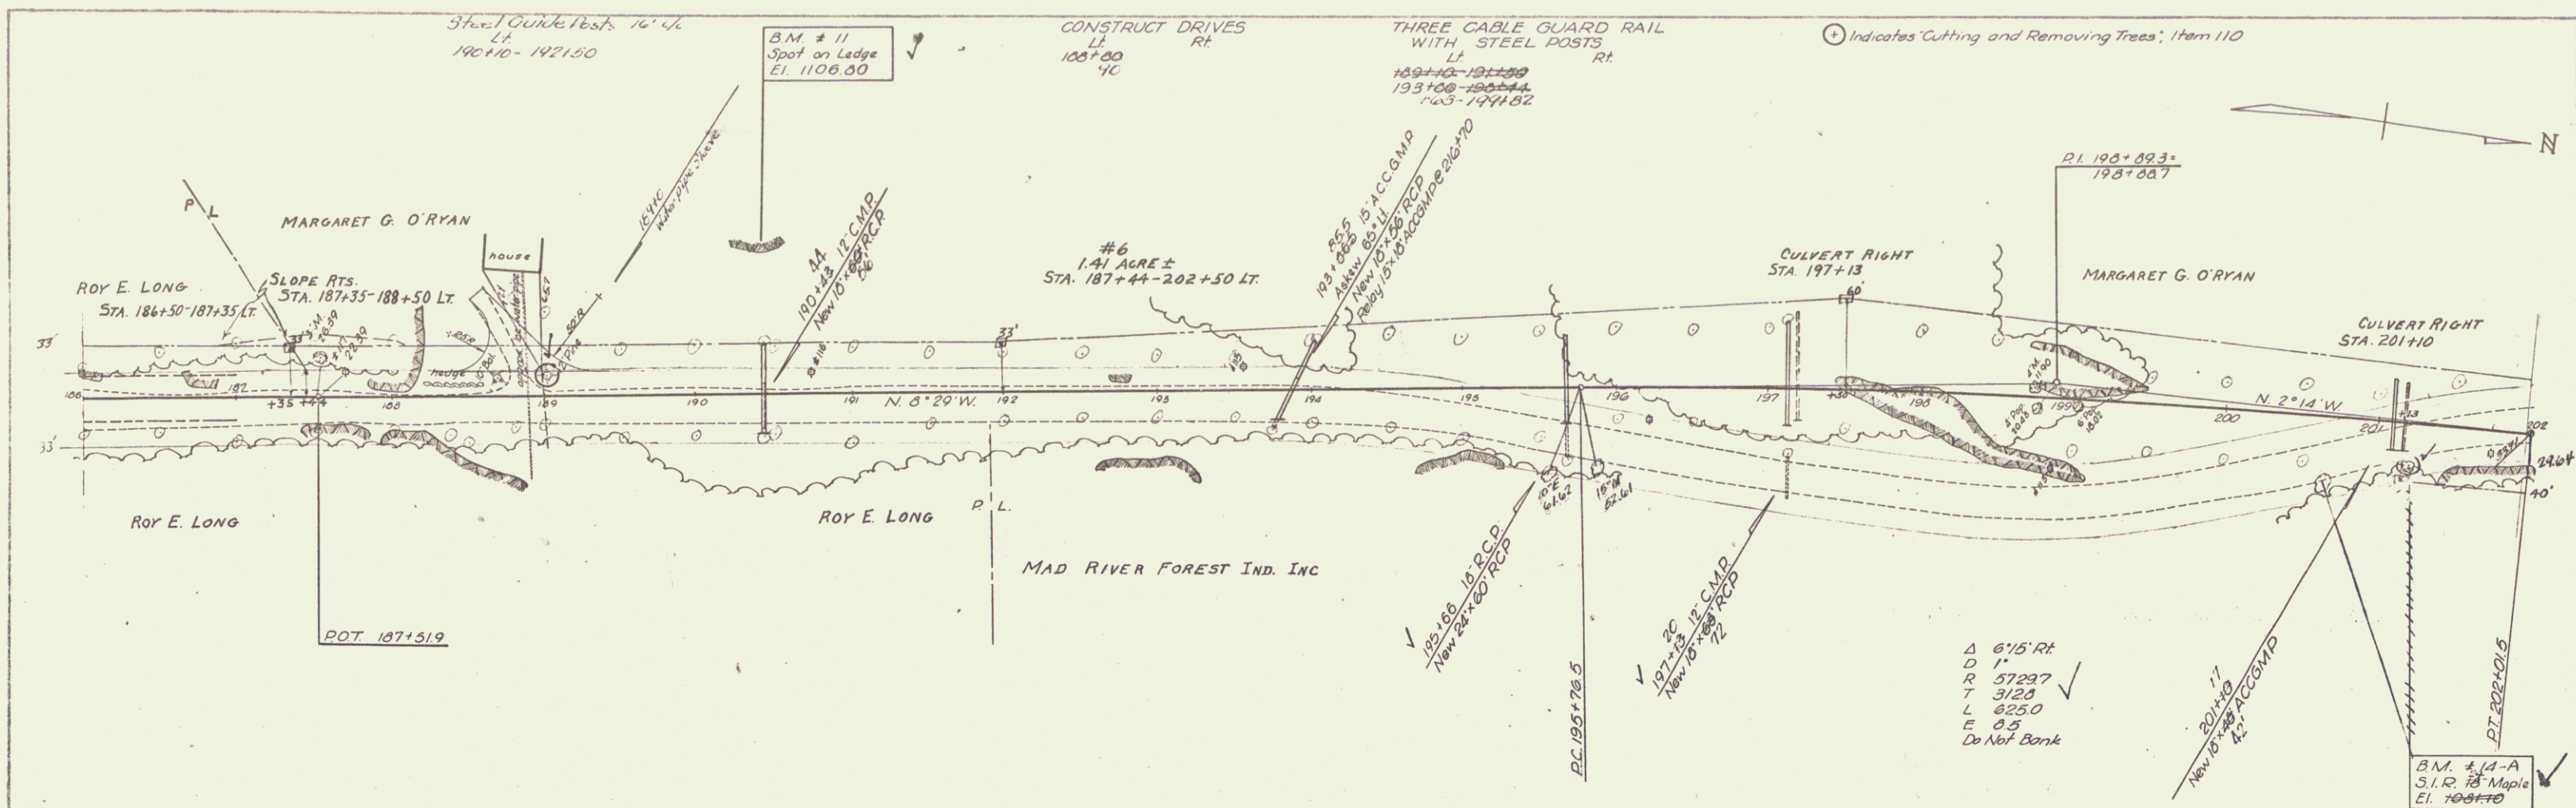


P.M. 1-56
 S. 1-56
 MADE BY
 TRACED

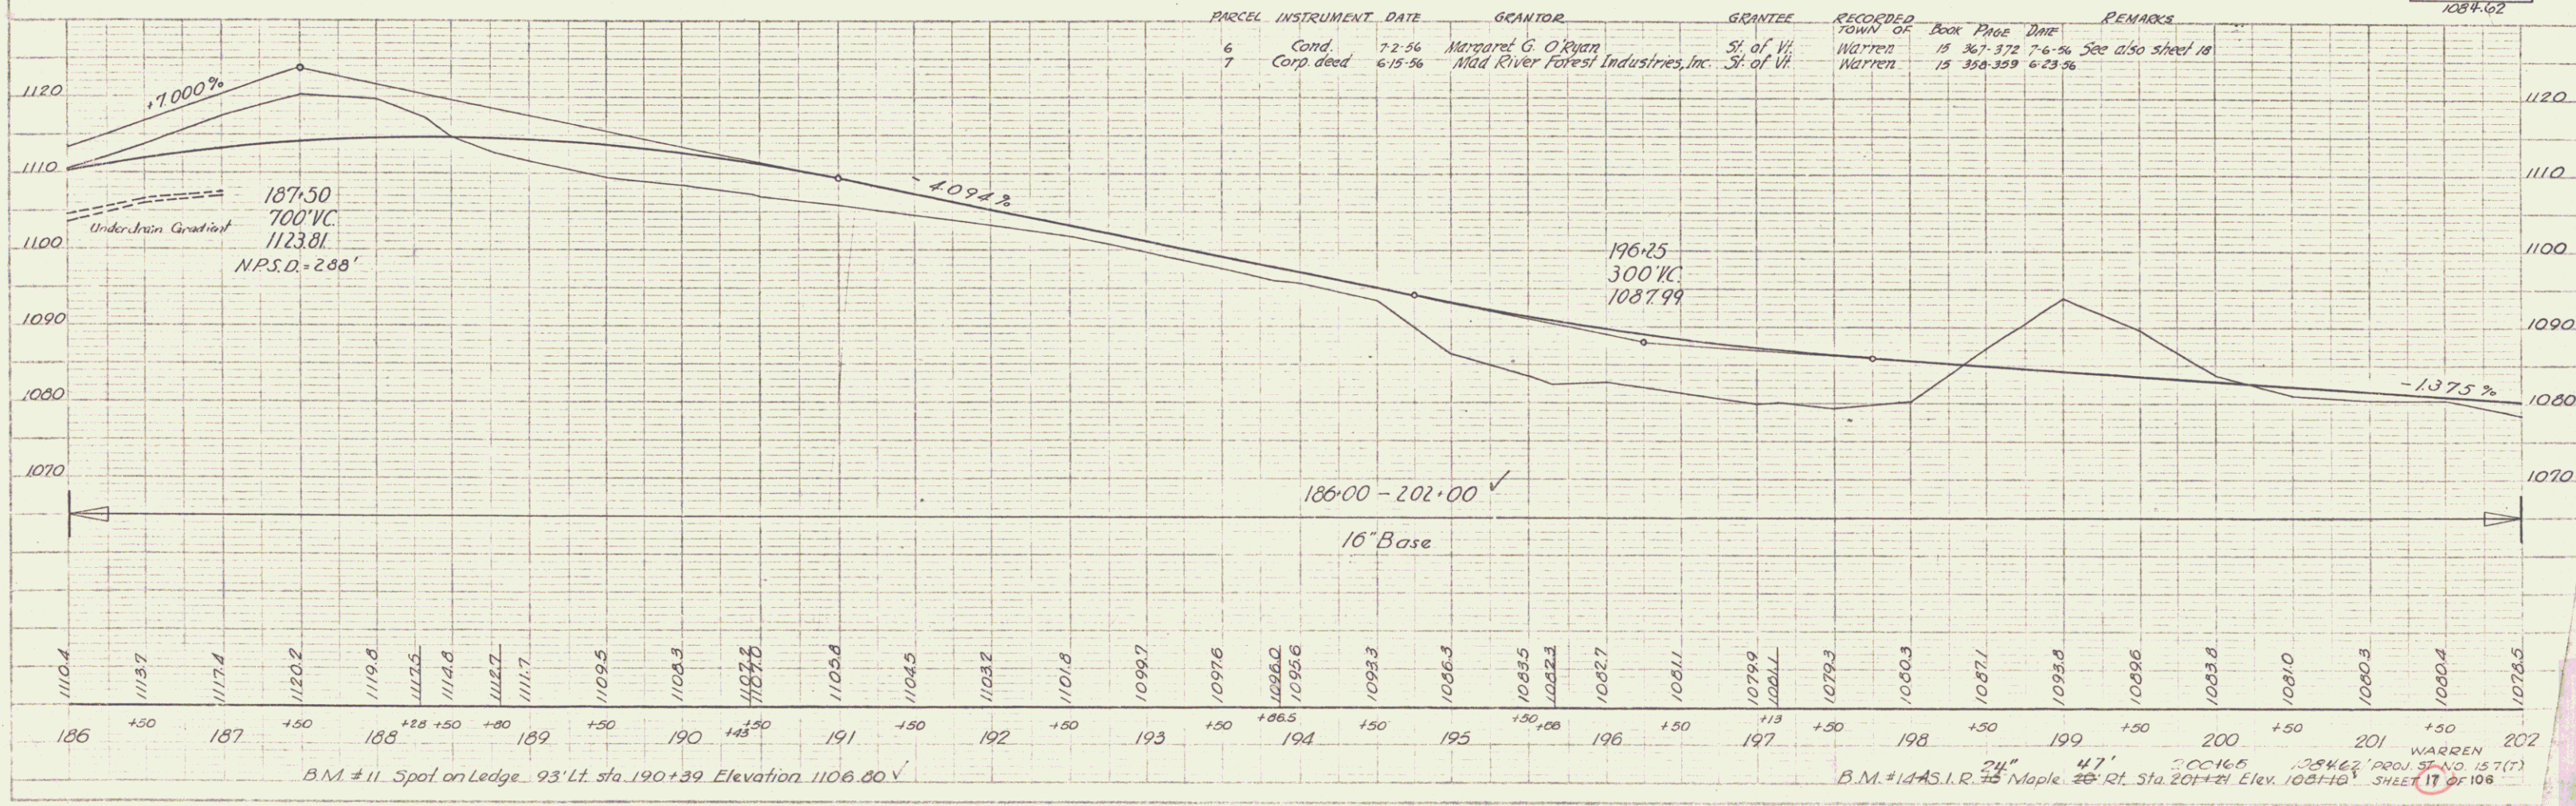


PARCEL	INSTRUMENT	DATE	GRANTOR	GRANTEE	TOWN OF	BOOK	PAGE	DATE	REMARKS
6	Cond.	7-2-56	Margaret G. O'Ryan	St. of Vt.	Warren	15	367-372	7-6-56	See also sheet 18
7	Corp deed	6-15-56	Mad River Forest Industries, Inc.	St. of Vt.	Warren	15	358-359	6-23-56	

UNDERSTAND GRADIENT
 187+50
 700' VC
 1123.81
 N.P.S.D. = 288'

B.M. #11 Spot on Ledge 93' Lt. Sta. 190+39 Elevation 1106.80 ✓
 B.M. #14 AS I.R. 35 Maple 20' Rt. Sta. 201+21 Elev. 1084.16
 WARREN
 SHEET 17 OF 108

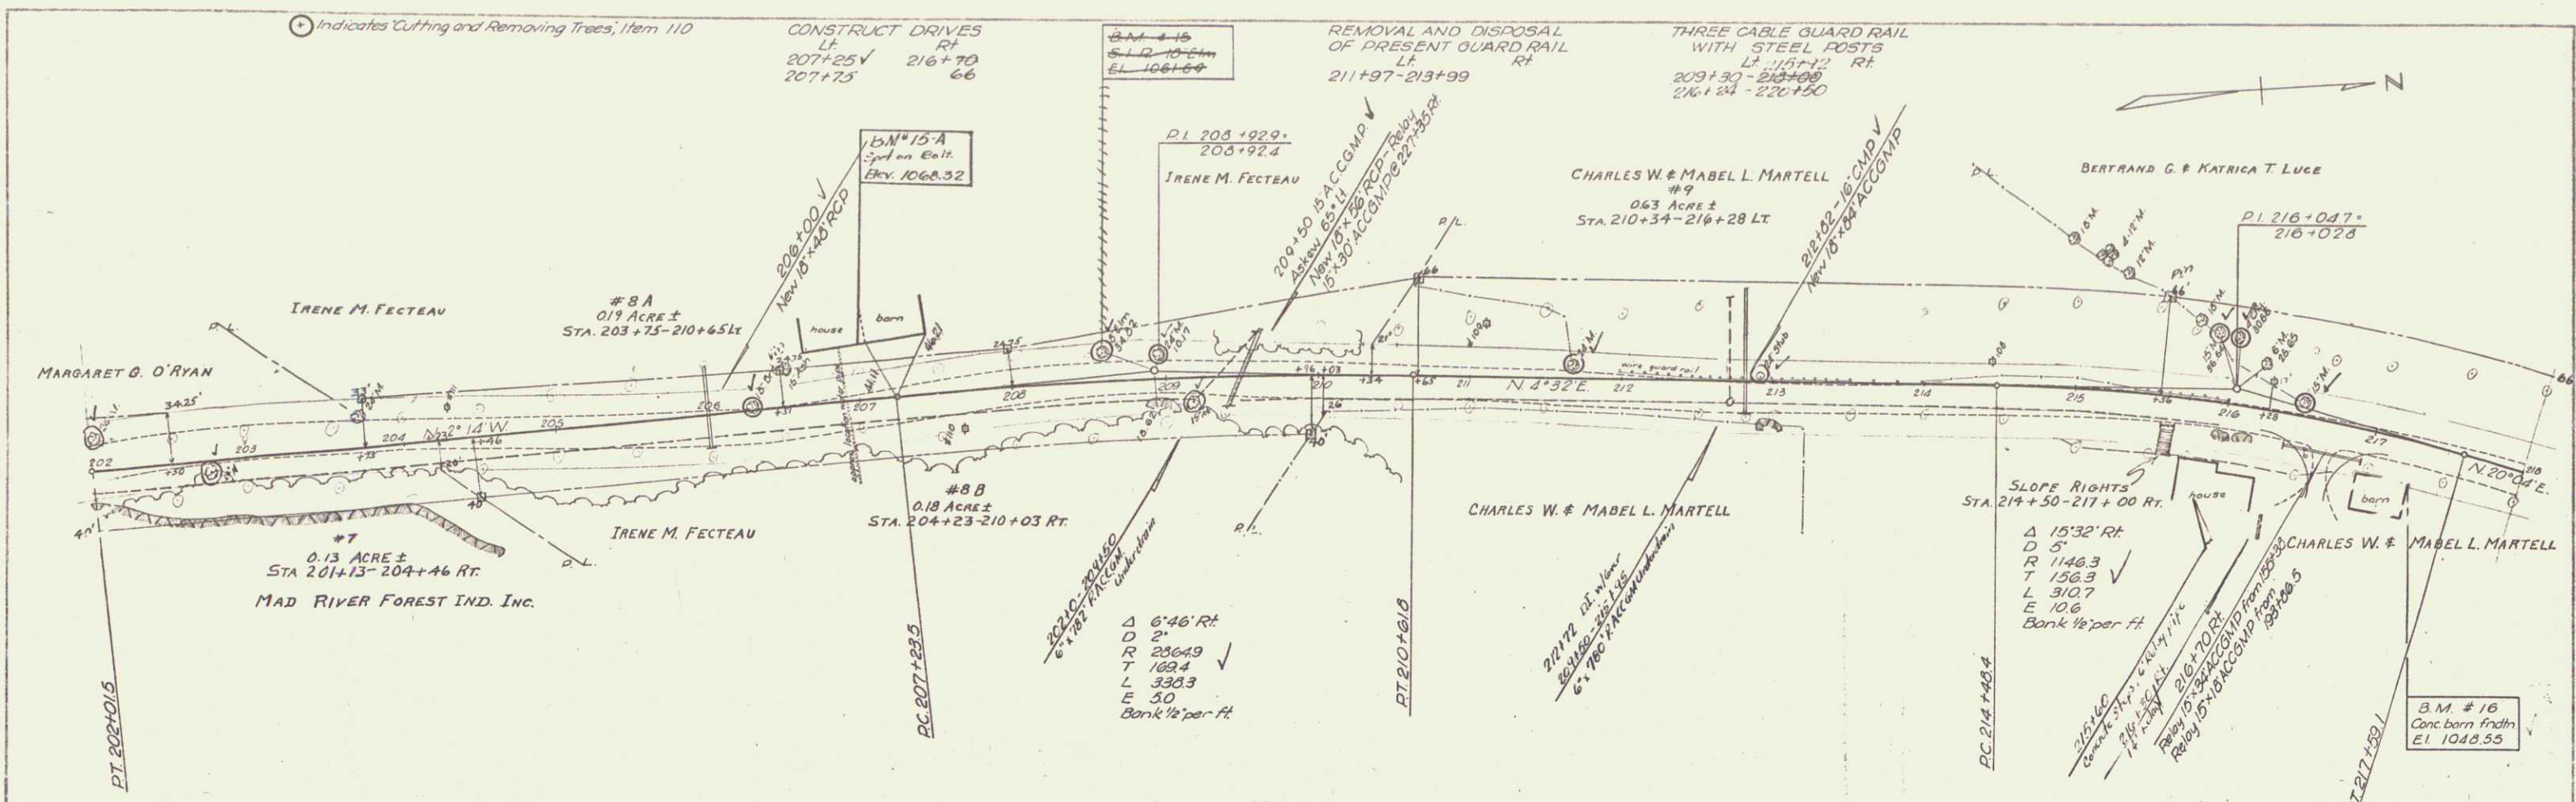

PARCEL	INSTRUMENT	DATE	GRANTOR	GRANTEE	RECORDED TOWN OF	BOOK PAGE	DATE	REMARKS
8A, B	WDOE	9-7-36	Irene M. Fecteau	St. of Vh.	Warren	15 305-306	11-1-36	
9	WDOE	9-15-36	Charles W & Mabel L. Martell	St. of Vh.	Warren	15 301	11-1-36	
10A, B	WDOE	9-7-36	Bertrand G & Matrica T. Luce	St. of Vh.	Warren	15 303-304	11-1-36	See d/50 sheet 19


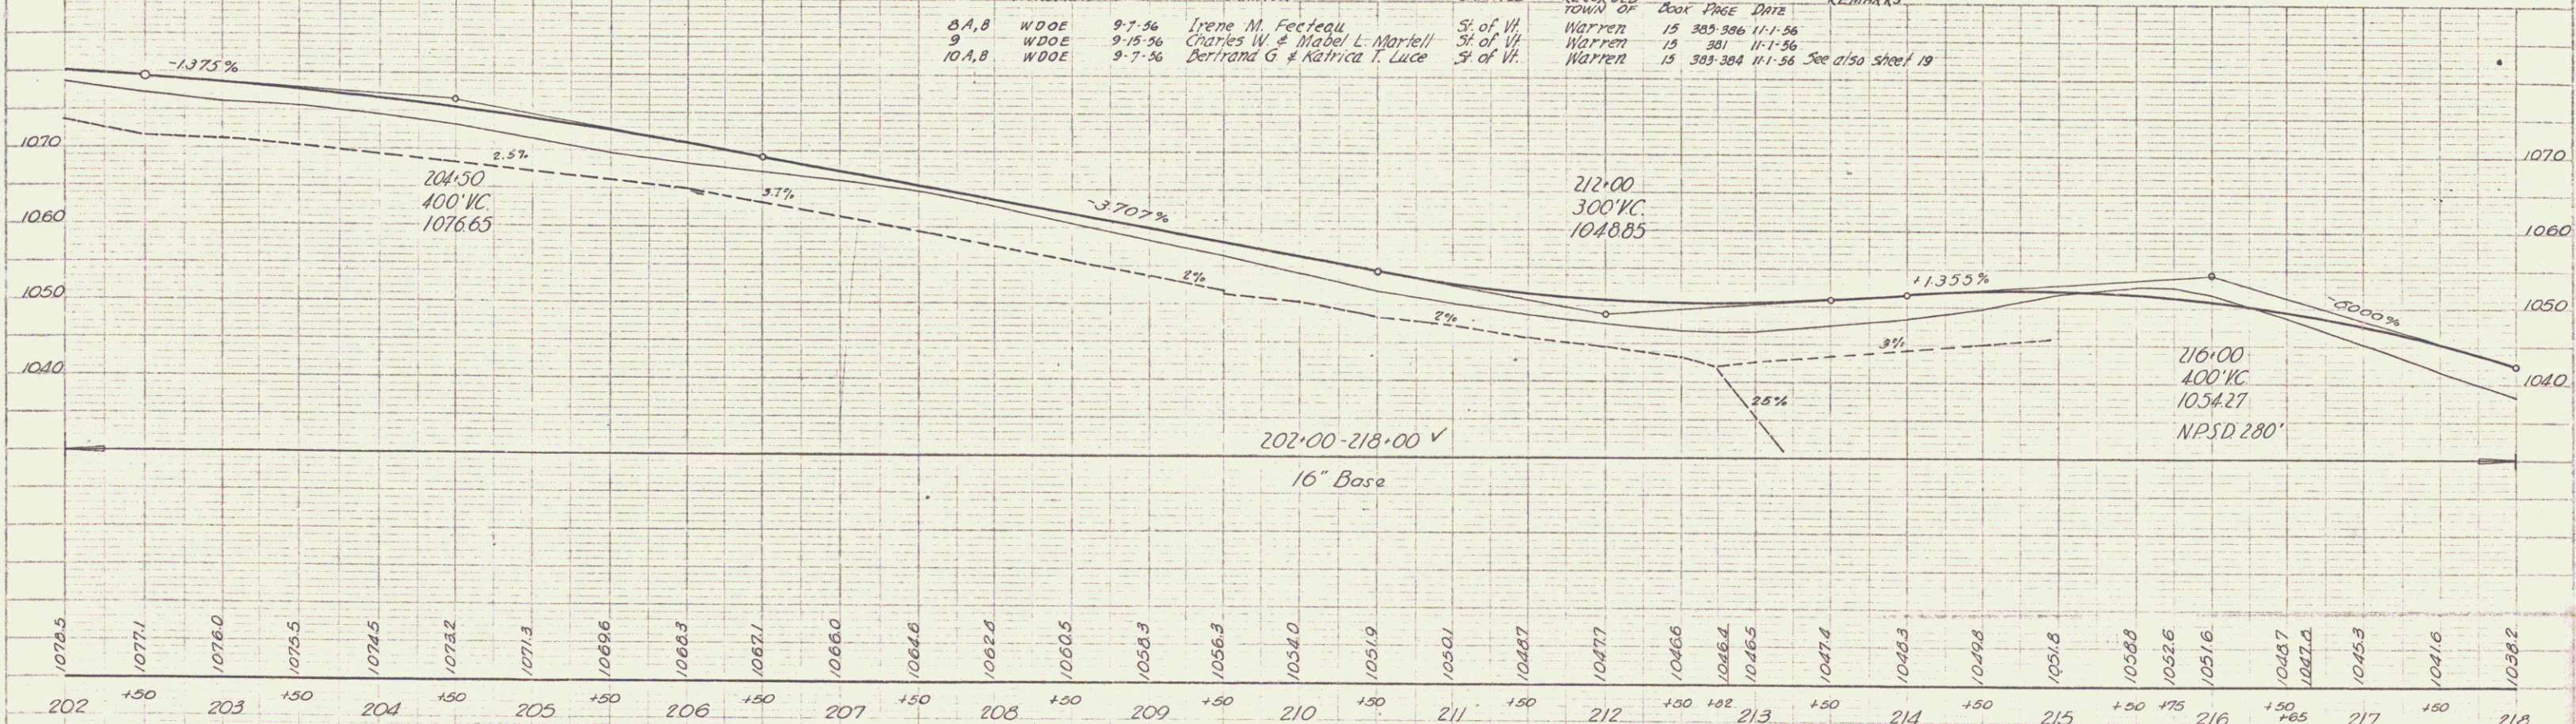


1076.5 1077.1 1078.0 1078.5 1074.5 1073.2 1071.3 1069.6 1068.3 1067.1 1066.0 1064.6 1062.8 1060.5 1058.3 1056.3 1054.0 1051.9 1050.1 1048.7 1047.7 1046.6 1046.4 1046.5 1047.4 1046.3 1049.8 1051.8 1050.8 1052.6 1051.6 1048.7 1047.2 1045.3 1041.6 1039.2

202 +50 203 +50 204 +50 205 +50 206 +50 207 +50 208 +50 209 +50 210 +50 211 +50 212 +50 213 +50 214 +50 215 +50 216 +50 217 +50 218

B.M. # 15 5' x 10' x 10' Elm 10' x 11' 3" 207+04 Ekv. 1066.69
 B.M. # 16 Conc. Barn Foundation 29' Rt. s/o 217+20 Elevation 1048.55

WARREN PROJ. 5120 157 (T) SHEET 10 OF 106

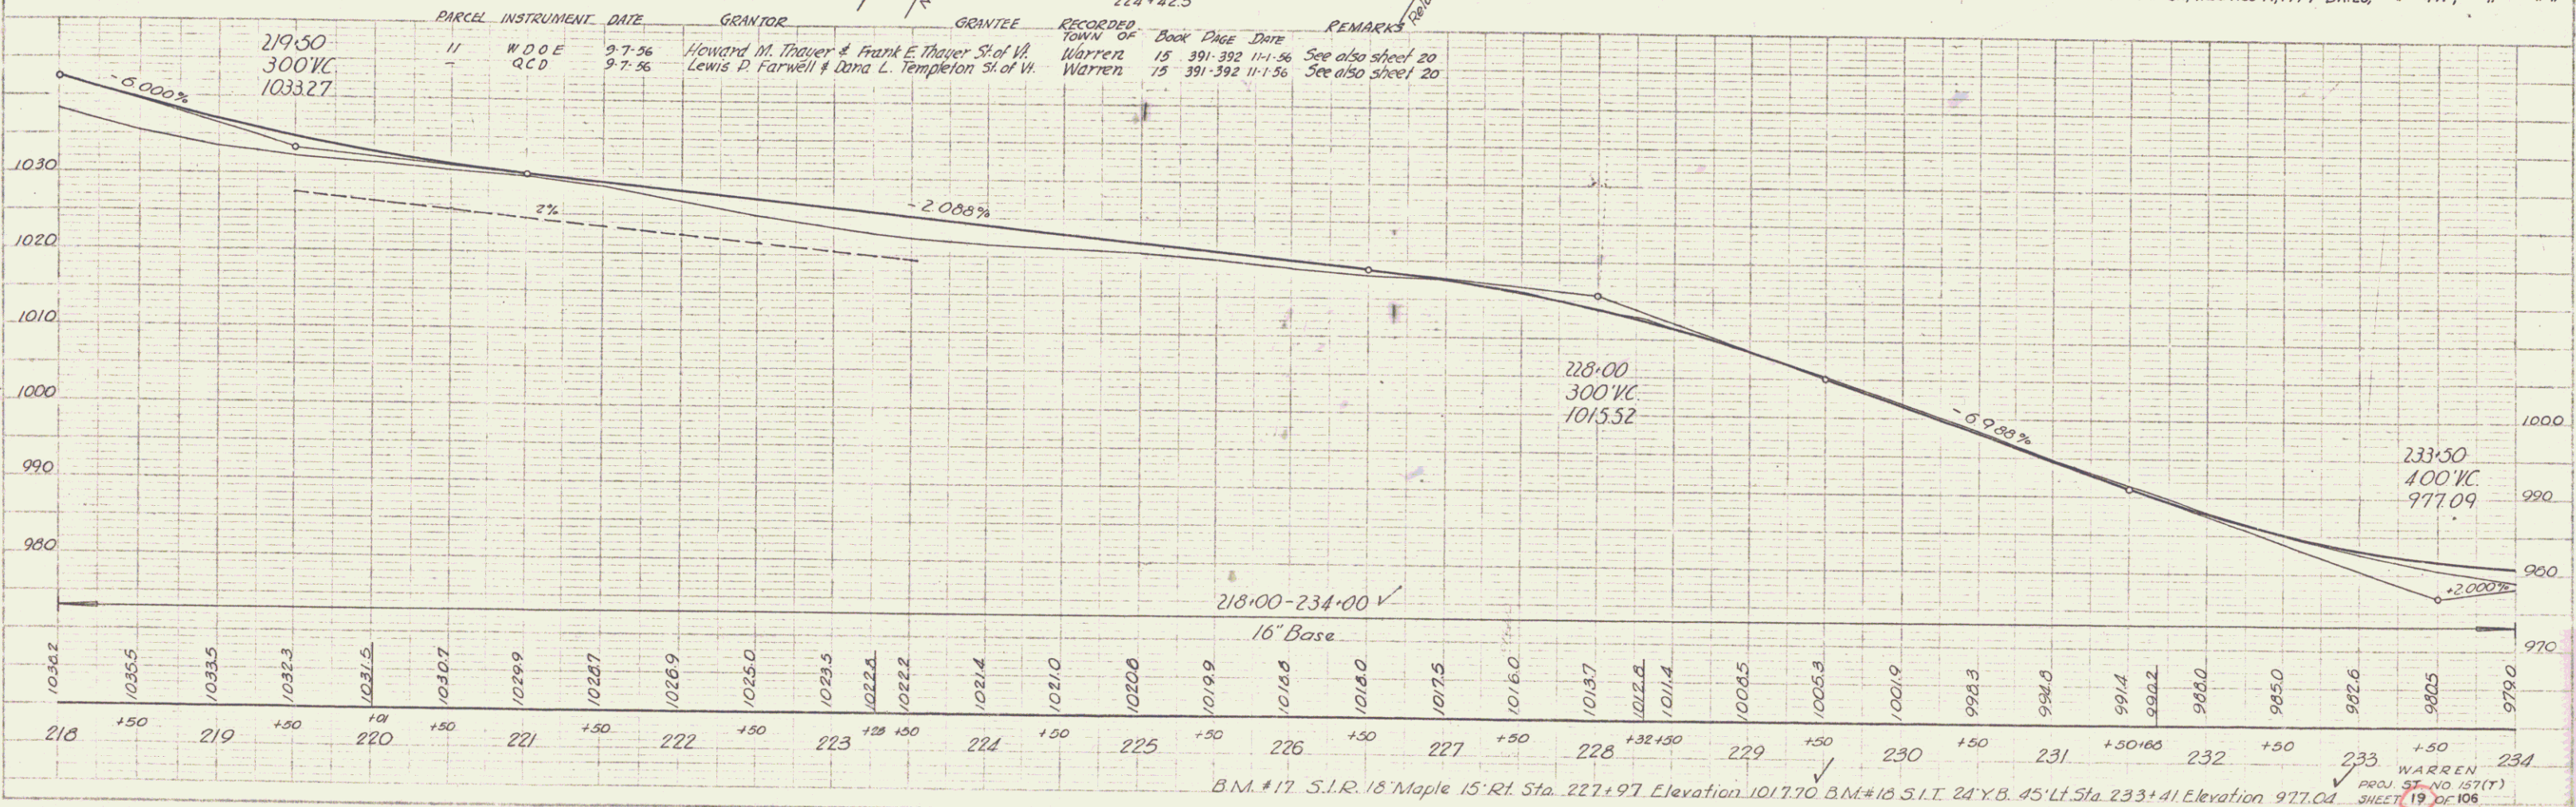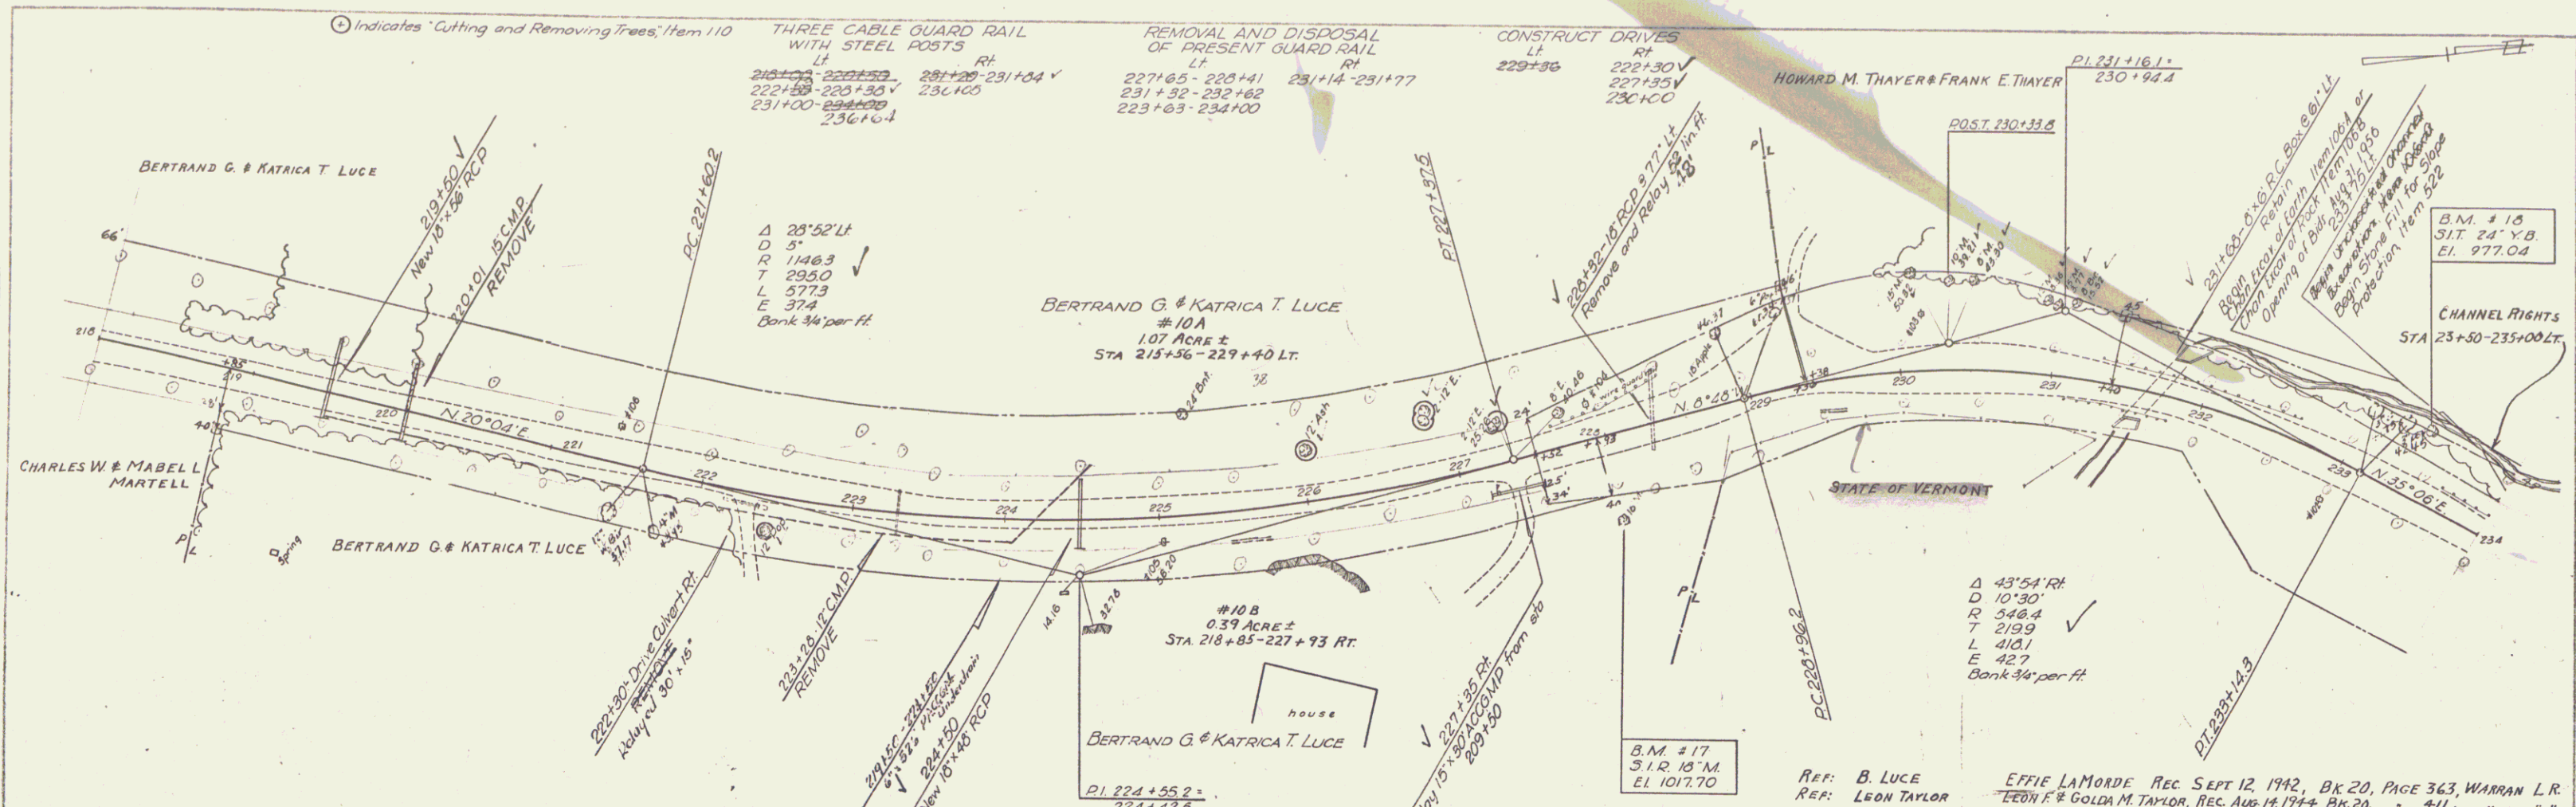

PLAN

DATE: 11-1-56

SCALE: 1"=40'

PROJECT: ROAD

TRACED

PROFILE

DATE: 11-1-56

SCALE: 1"=40'

PROJECT: ROAD

TRACED

PARCEL	INSTRUMENT	DATE	GRANTOR	GRANTEE	RECORDED	TOWN OF	BOOK	PAGE	DATE	REMARKS
11	W.D.O.E.	9-7-56	Howard M. Thayer & Frank E. Thayer	St of Vt	Warren	15	391-392	11-1-56	See also sheet 20	
11	Q.C.D.	9-7-56	Lewis D. Farwell & Dana L. Templeton	St of Vt	Warren	15	391-392	11-1-56	See also sheet 20	

B.M. # 17 S.I.R. 18 Maple 15' Rt. Sta. 227+97 Elevation 1017.70 B.M. # 16 S.I.T. 24 Y.B. 45' Lt. Sta. 233+41 Elevation 977.04


WARREN

PROJ. ST. NO. 157(17)


SHEET 19 OF 106

DATE	BY	REVISION
7-56	AVJ	REVISED
7-56	AVJ	REVISED
7-56	AVJ	REVISED


DATE	BY	REVISION
7-56	AVJ	REVISED
7-56	AVJ	REVISED
7-56	AVJ	REVISED

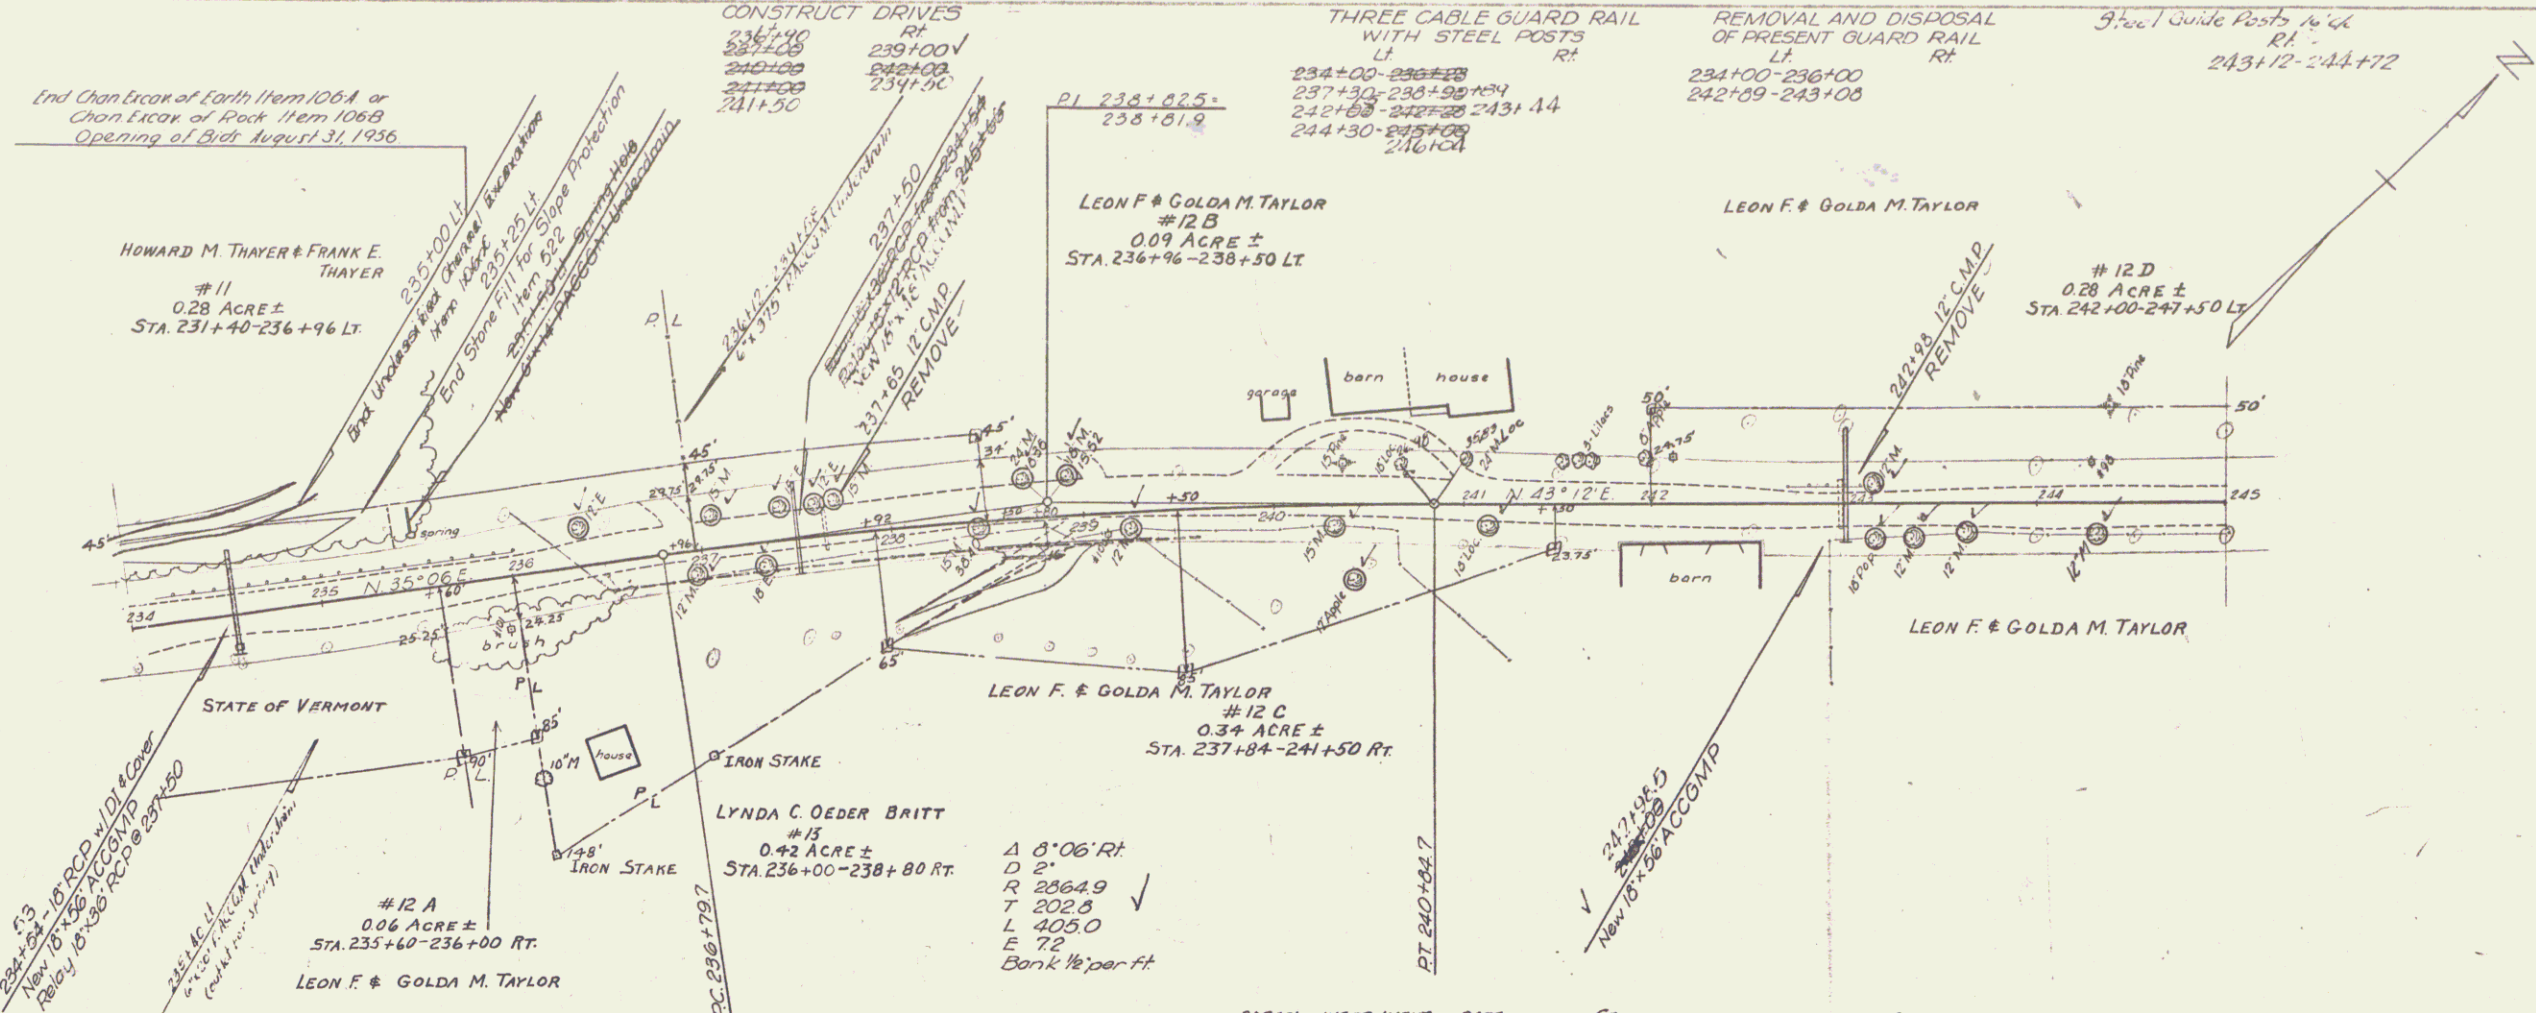

PARCEL	INSTRUMENT	DATE	GRANTOR	GRANTEE	RECORDED	TOWN OF	BOOK	PAGE	DATE	REMARKS
12A, B, C	W D O E	9-15-56	Leon F. & Golda M. Taylor	St. of Vt.	Warren	15	389-391	11-1-56		See also sheet 21
13	W D	6-8-56	Lynda C. Oeder Britt	St. of Vt.	Warren	15	373	9-9-56		

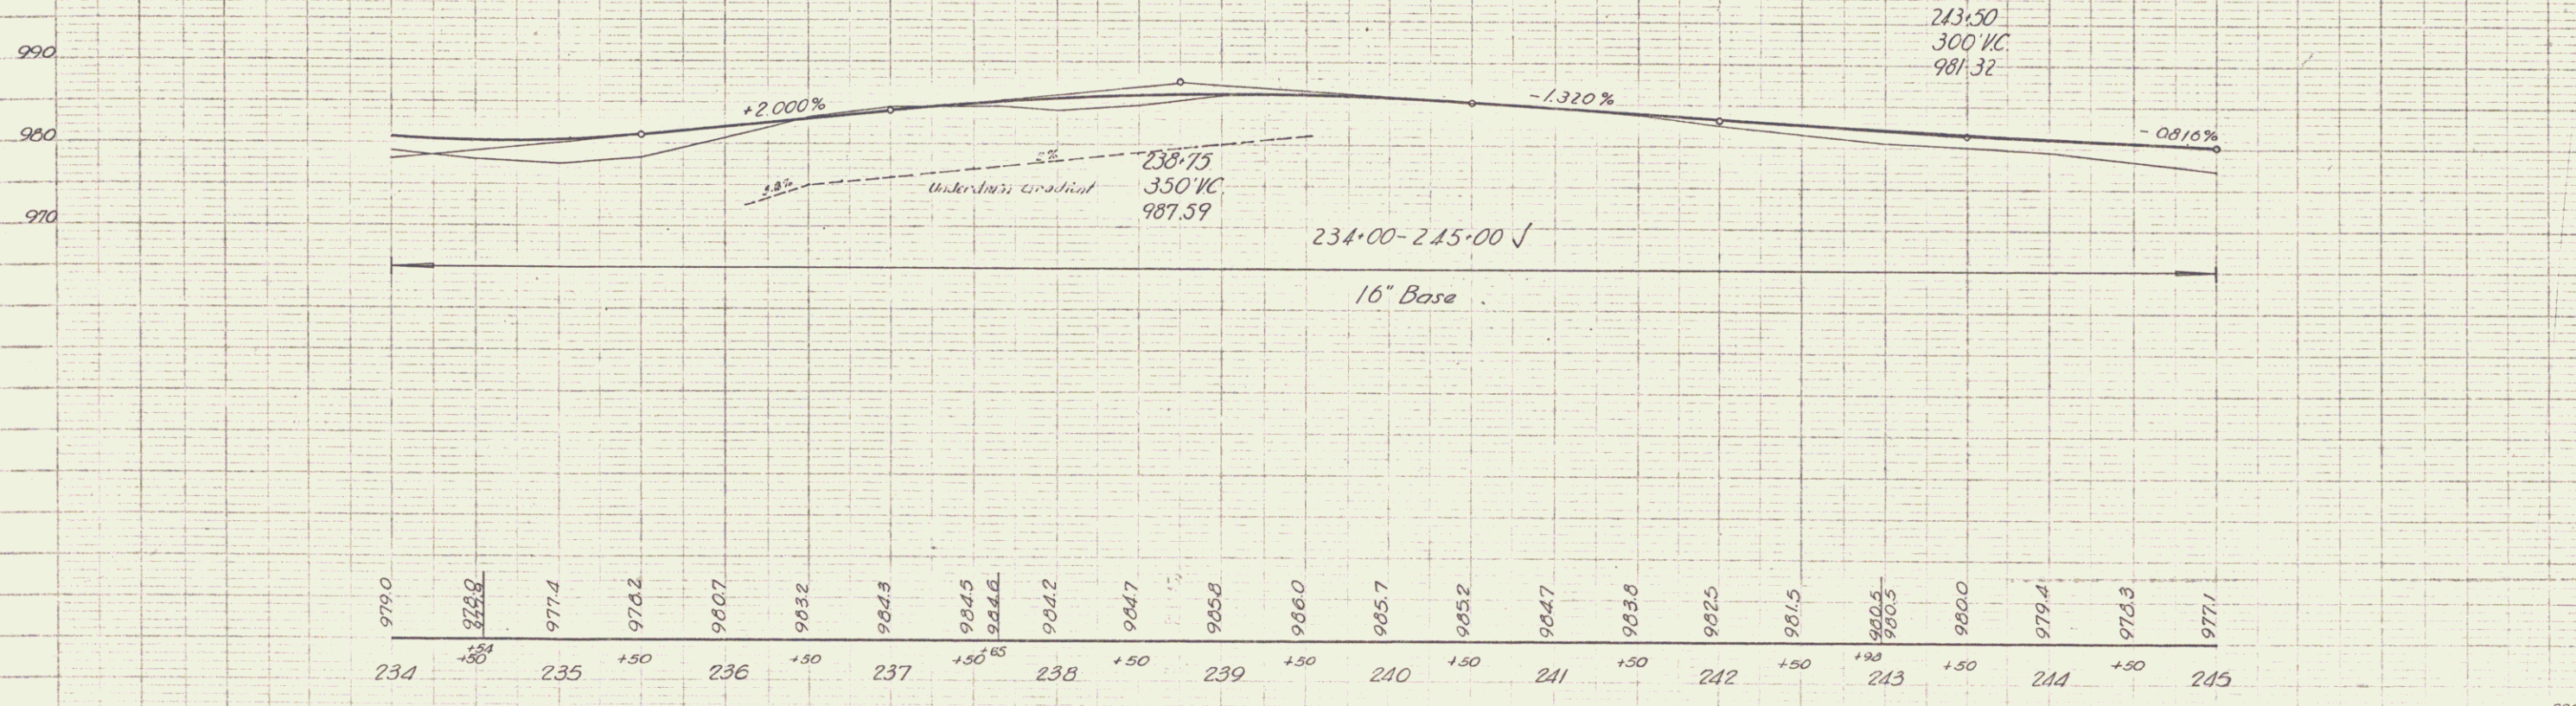


WARREN
 PROJ. NO. 157(T)
 SHEET 20 OF 106

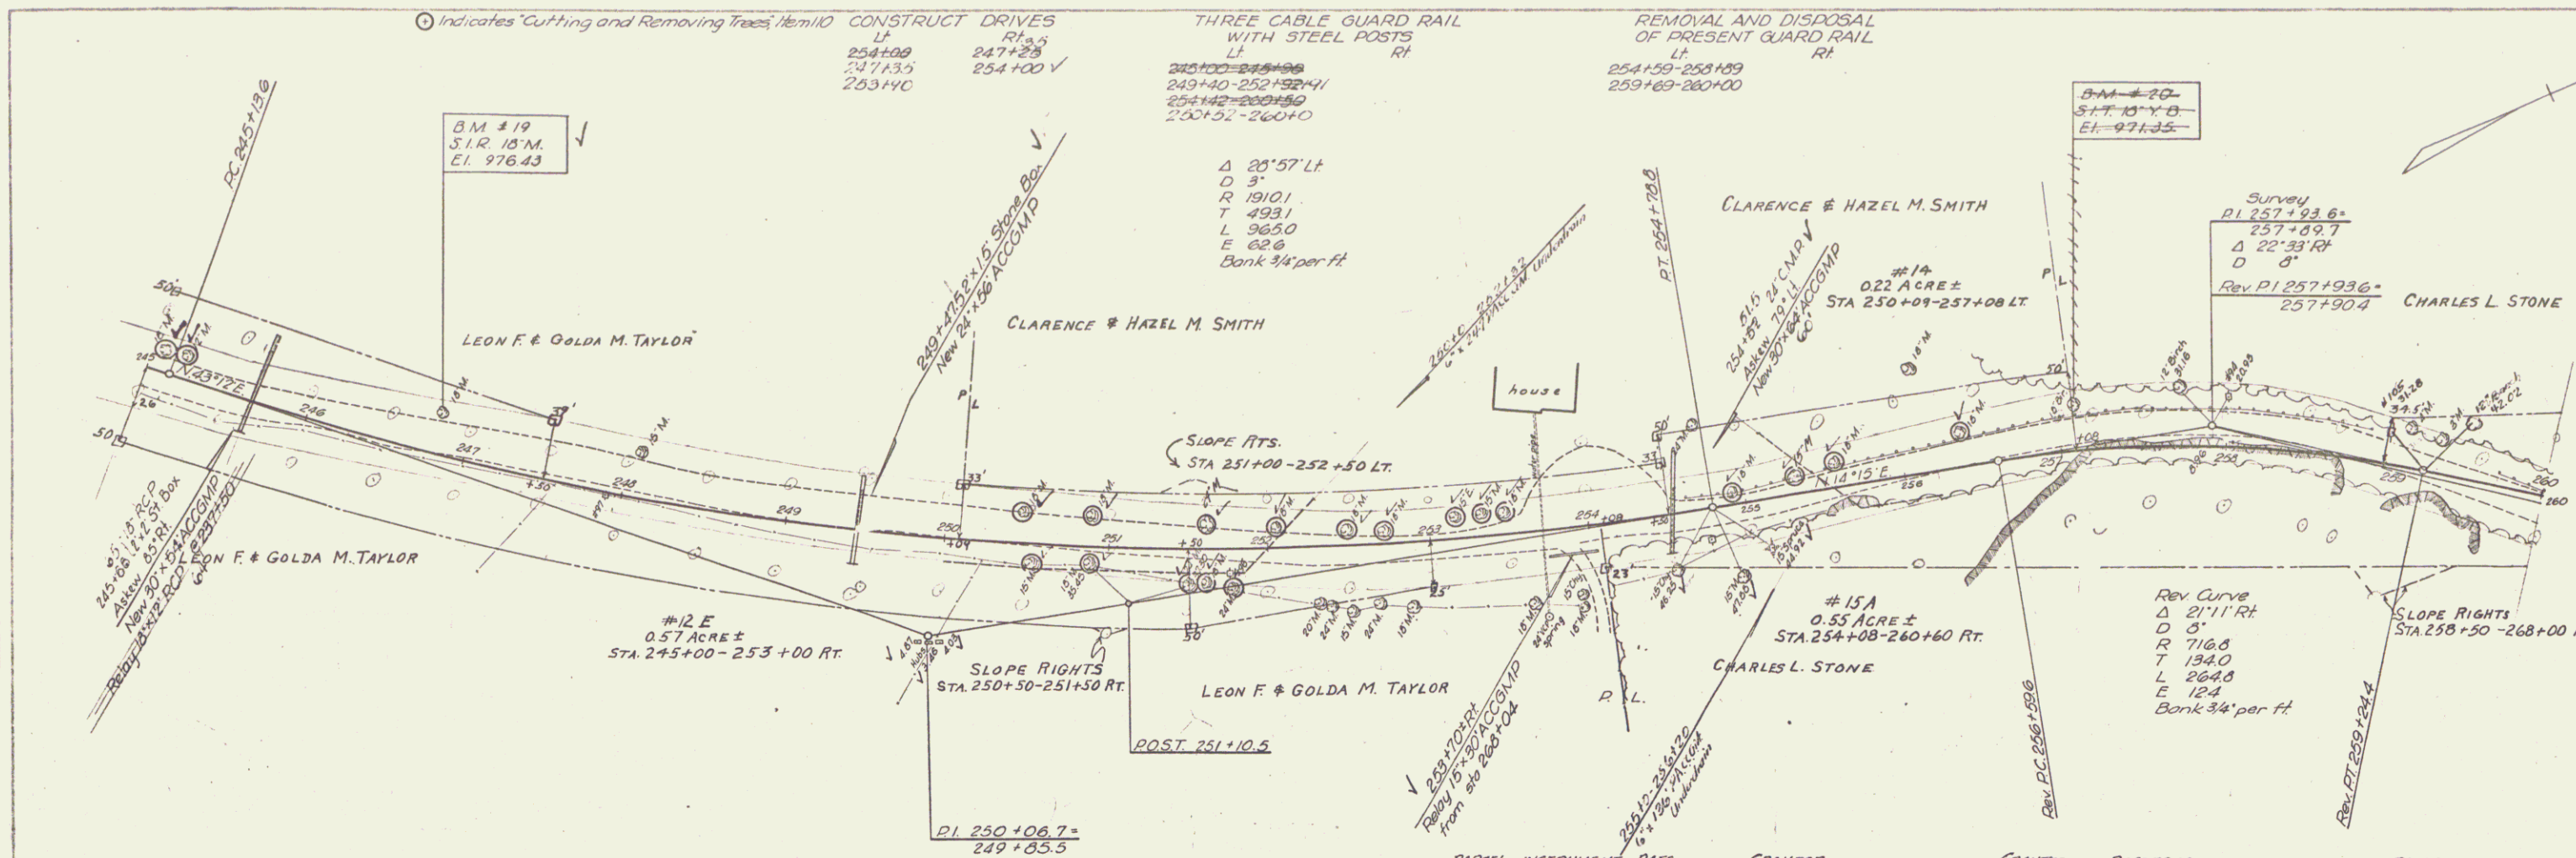

PLAN
 DATE: 7-56
 DRAWN BY: [illegible]
 CHECKED BY: [illegible]
 SCALE: AS SHOWN
 SHEET NO. 21 OF 108

PARCEL	INSTRUMENT	DATE	GRANTOR	GRANTEE	RECORDED	TOWN OF	BOOK	PAGE	DATA	REMARKS
A	Cond	7-2-56	Clarence & Hazel M. Smith	St. of Vt.	Warren	15	367-372	7-6-56		
B, C, D	WDOE	9-12-56	Charles L. Stone	St. of Vt.	Warren	22	507-508	11-1-56		See also sheet 22

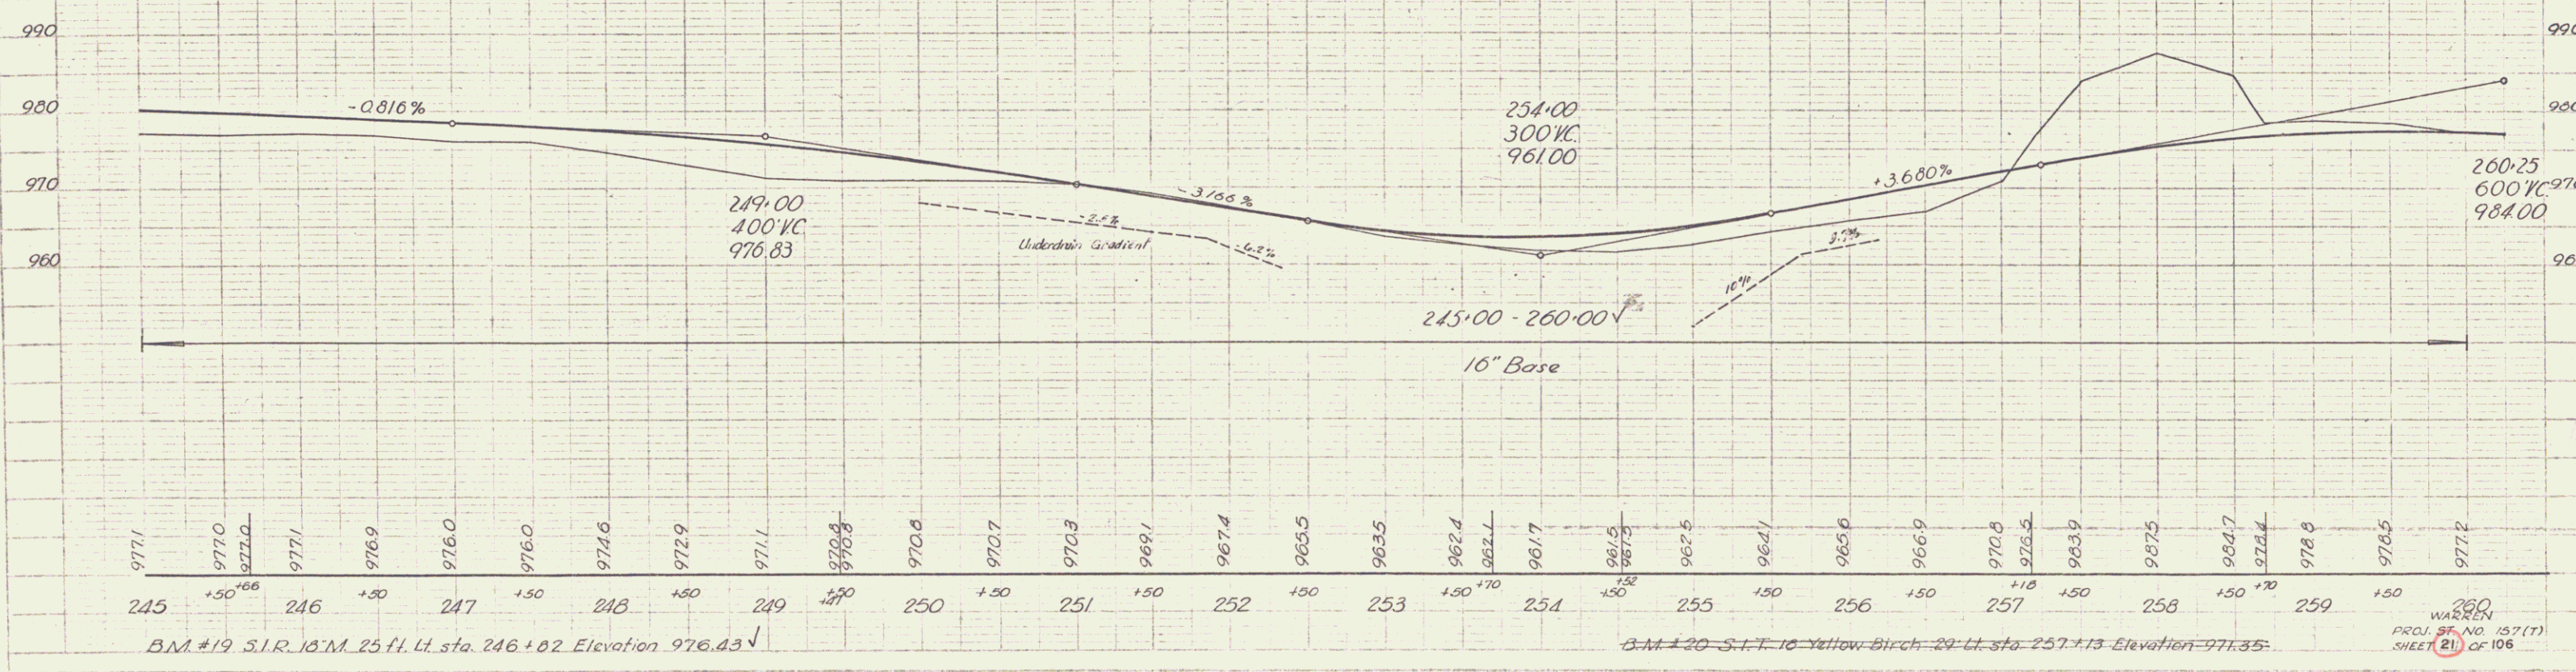

BM #19 S.I.R. 16'M. 25 ft. Lt. sta. 246+02 Elevation 976.43
 BM #20 S.I.T. 10 Yellow Birch 29' Lt. sta. 257+13 Elevation 971.35

WARREN
 PROJ. NO. 157(1)
 SHEET 21 OF 108

PLAN
REVISIONS
DATE
BY
CHECKED
DATE
BY
SCALE
PROJECT NO.
SHEET NO.

