



PLAN  
 DATE: 7-56  
 DRAWN BY: [illegible]  
 CHECKED BY: [illegible]  
 SCALE: 1" = 40'

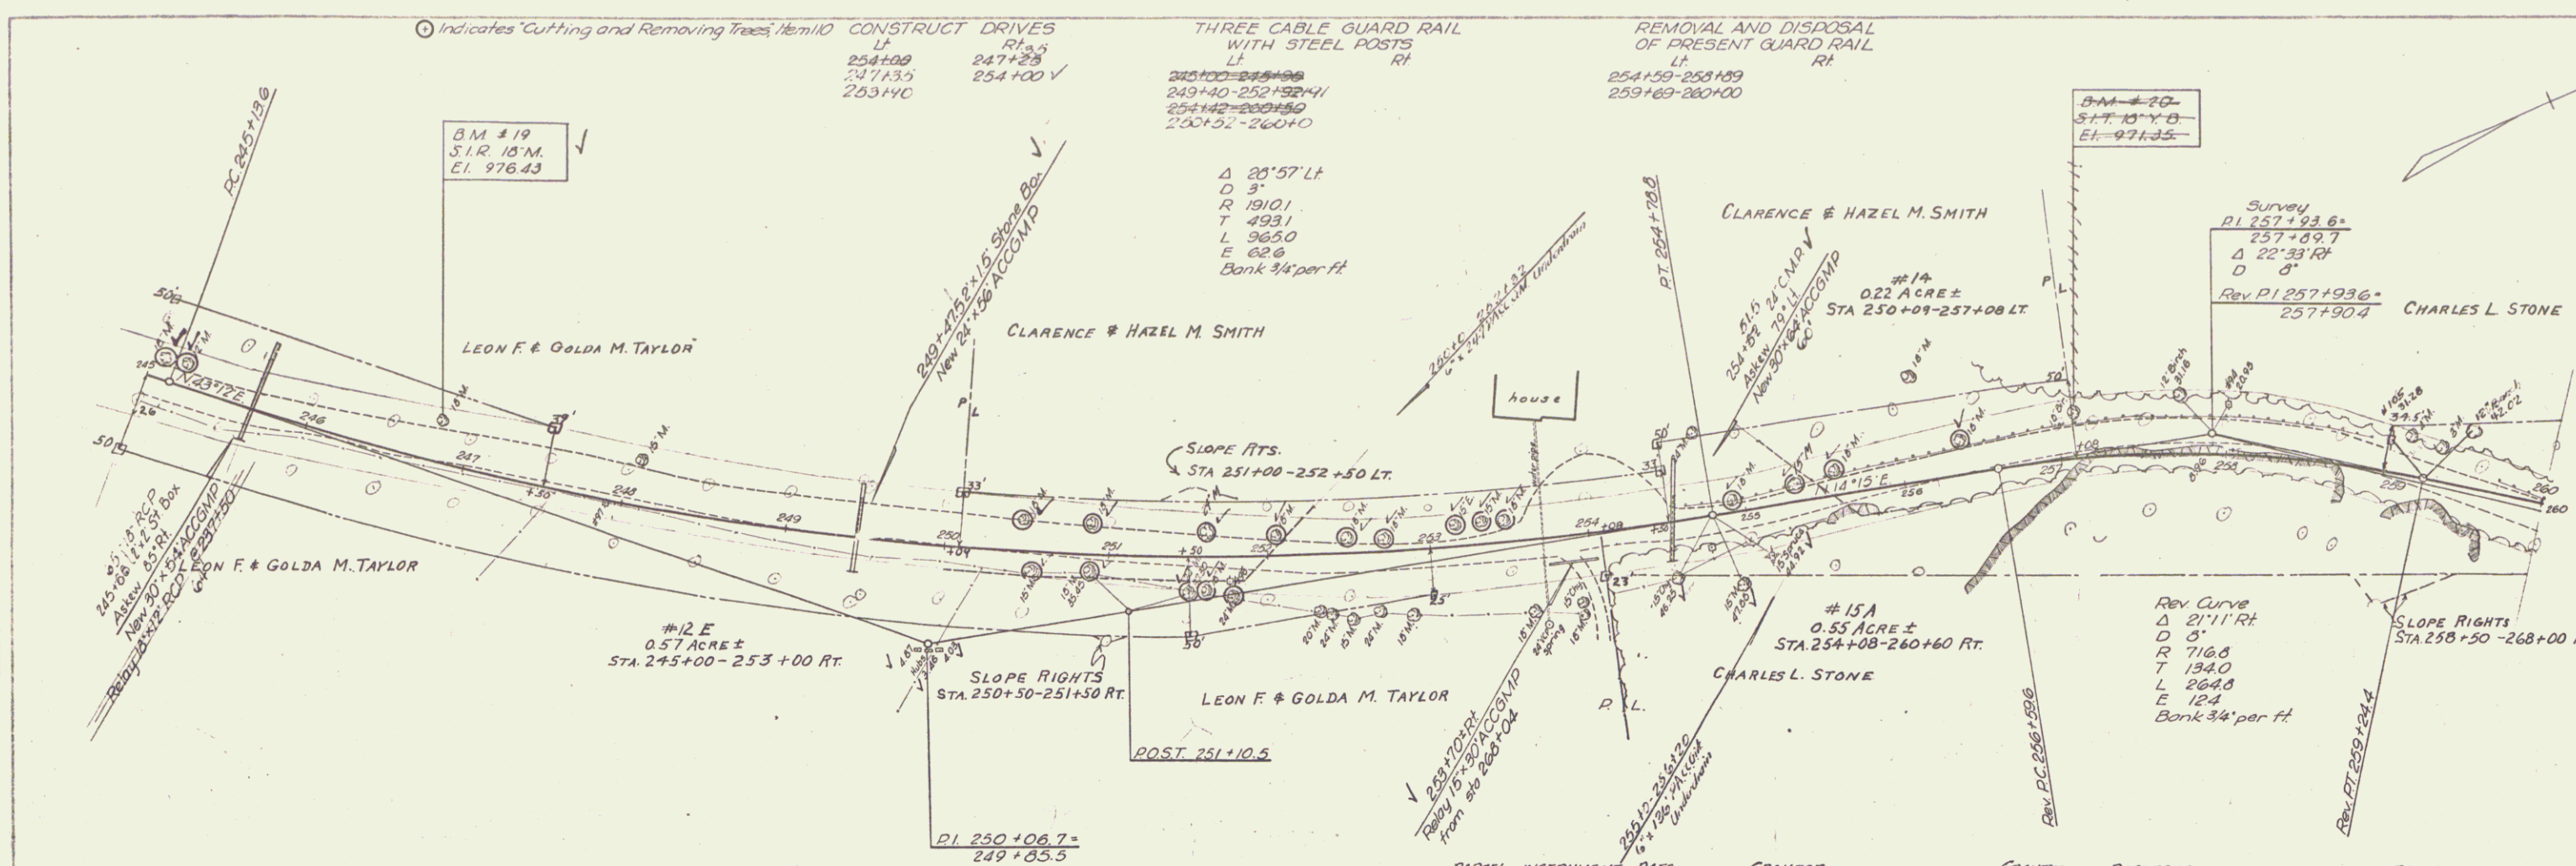

PARCEL	INSTRUMENT	DATE	GRANTOR	GRANTEE	RECORDED	TOWN OF	BOOK	PAGE	DATA	REMARKS
A	Cond	7-2-56	Clarence & Hazel M. Smith	St. of Vt.	Warren	15	367-372	7-6-56		
B, C, D	WDOE	9-12-56	Charles L. Stone	St. of Vt.	Warren	22	507-508	11-1-56		See also sheet 22

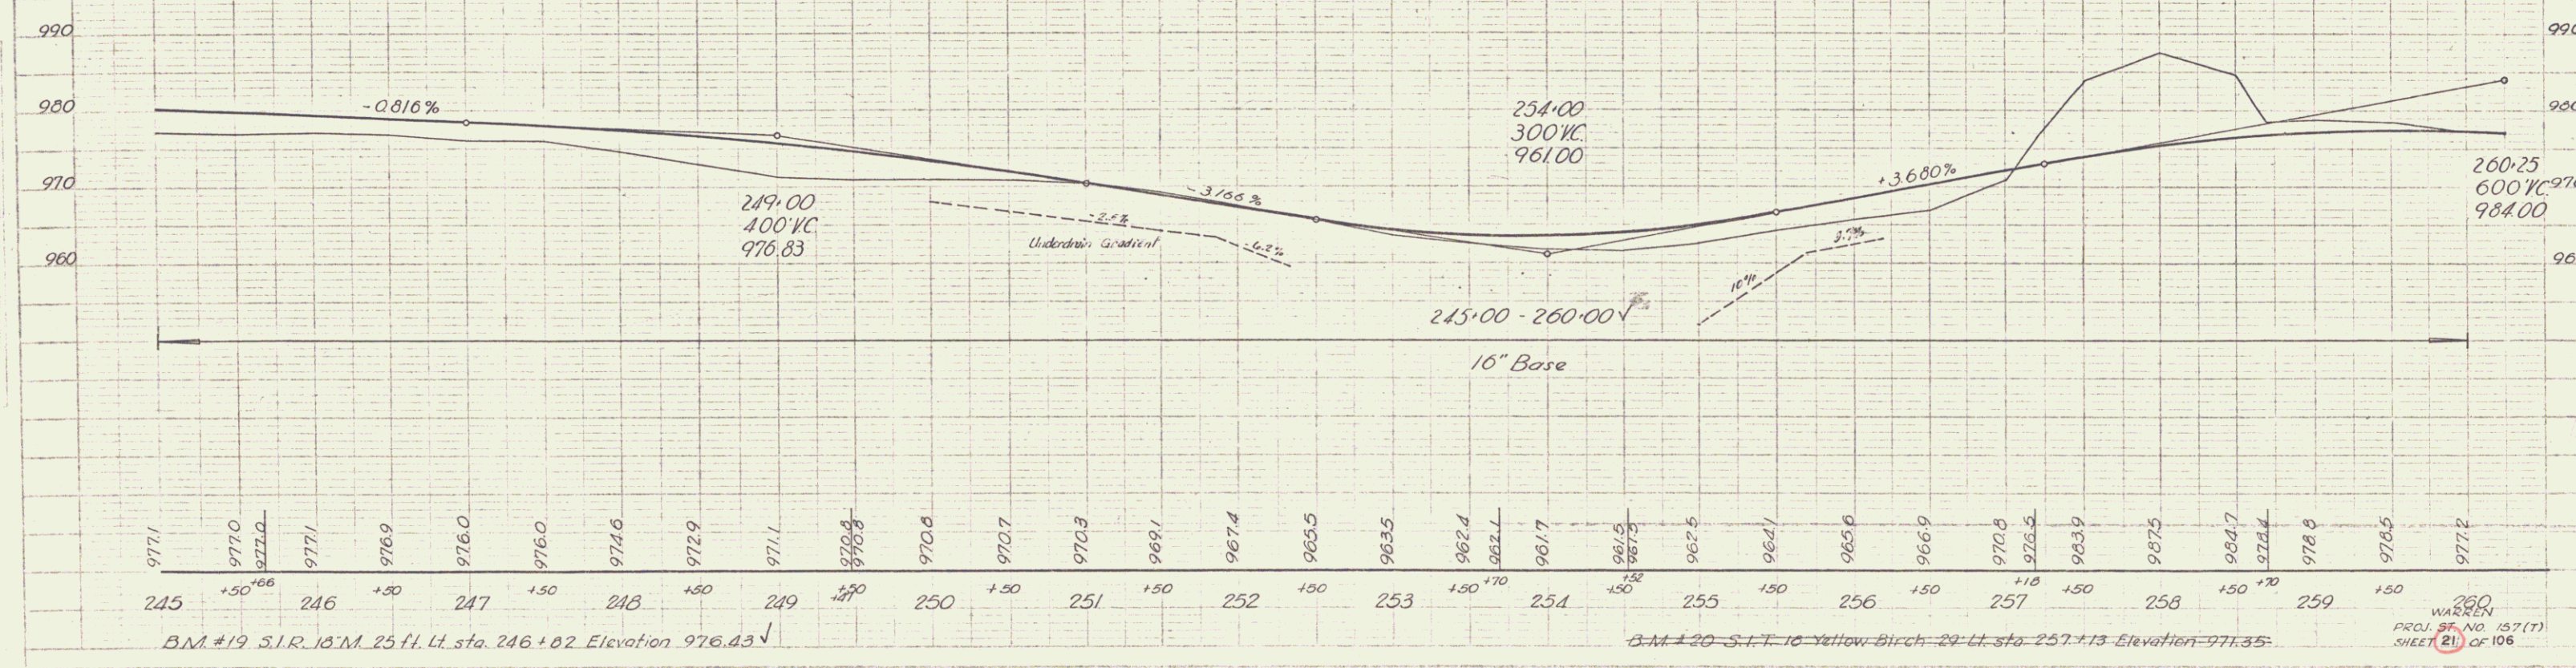

BM #19 S.I.R. 16'M. 25 ft. Lt. sta. 246+02 Elevation 976.43

BM #20 S.I.T. 10 Yellow Birch 29' Lt. Sta. 257+13 Elevation 971.35

WARREN  
 PROJ. NO. 157(1)  
 SHEET 21 OF 108