



REV. CURVE
Δ 9° 49' LT.
D 3'
R 190.1
T 164.0
L 327.2
E 7.0

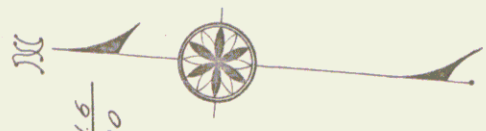


1339
2 13
P.W.A. Vt. DOCKET 1092

1339
2 13
P.W.A. Vt. DOCKET 1092

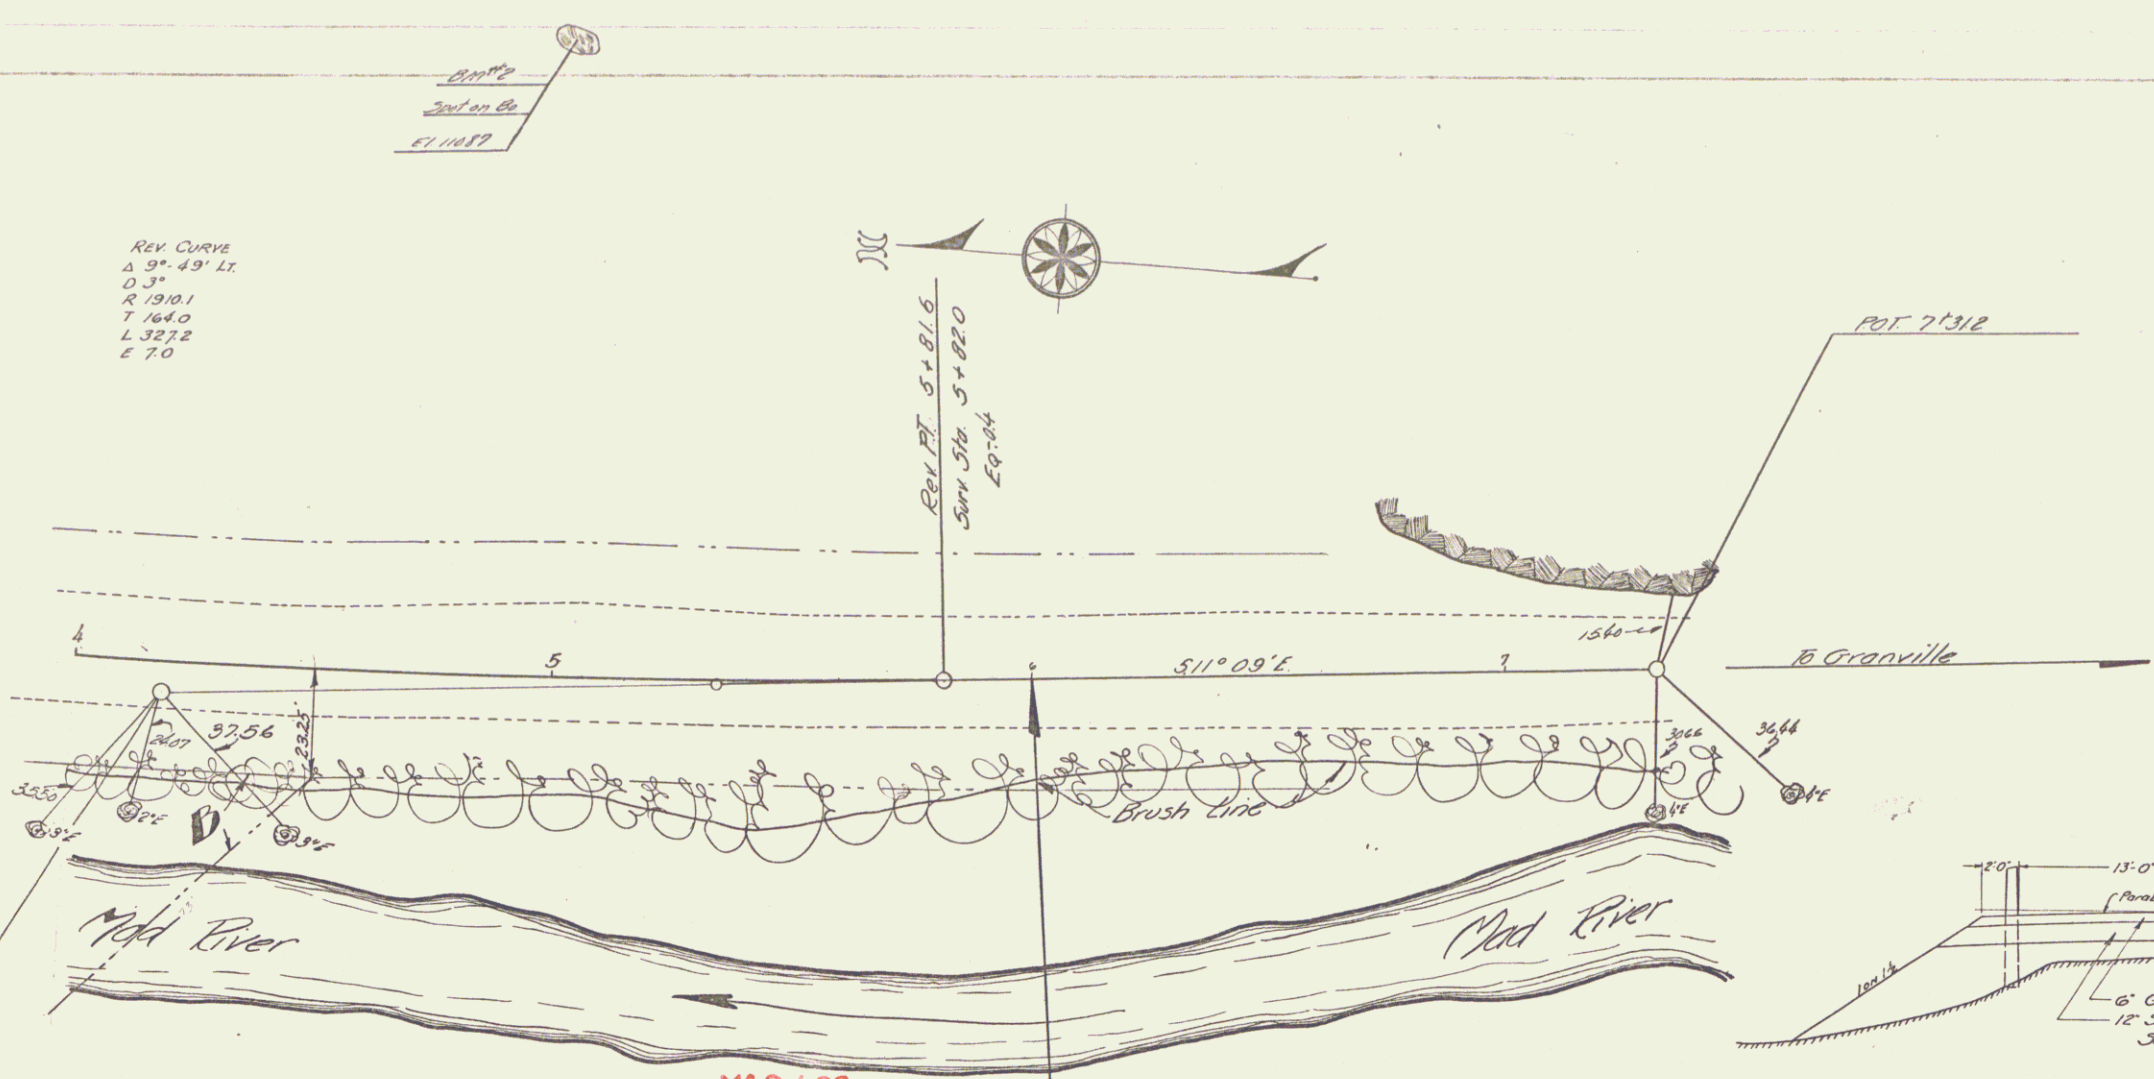

MP 0.609
STA 6+100
END OF PROJECT
P.W.A. Vt. DOCKET 1092

Parcel	Instrument	Date	Grantor	Grantee	Recorded	Remarks
B	Q.C.D.	3-2-39	George Blair	Stet. W.	Warren Book 20 Page 220-20	3-9-39

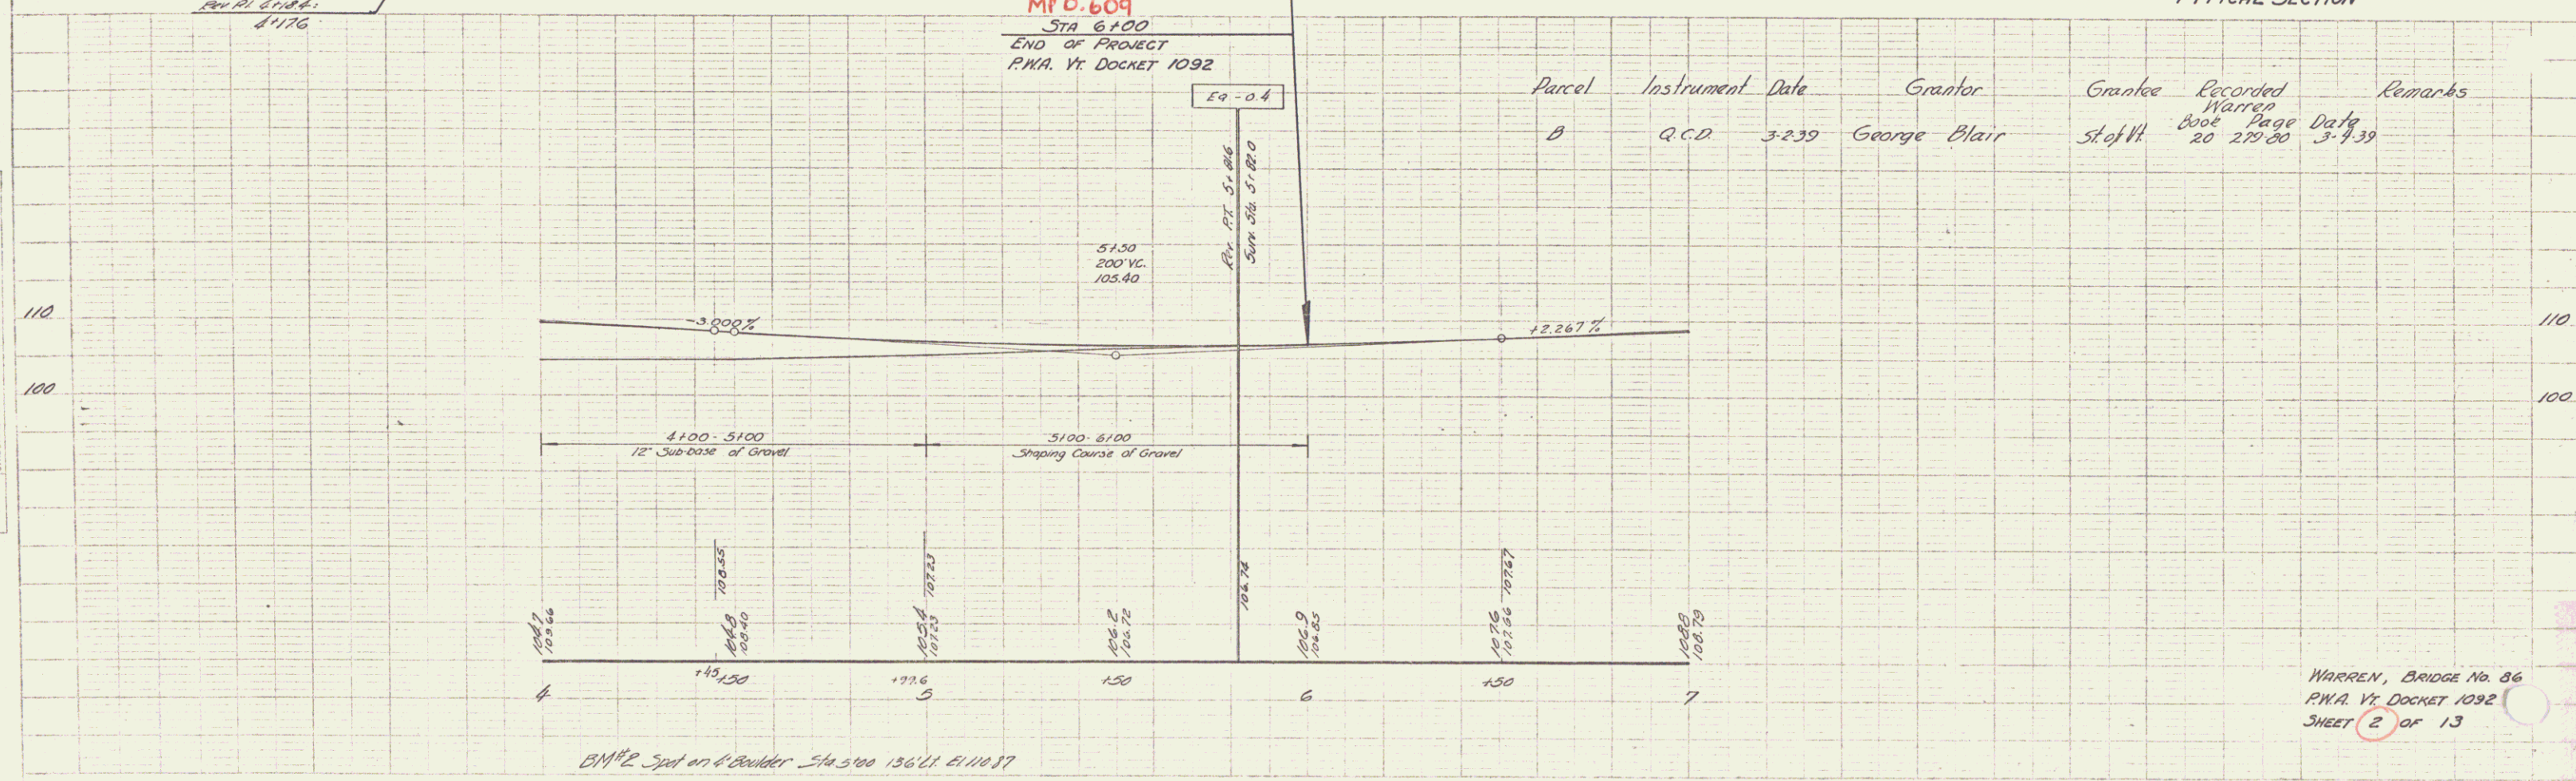

WARREN, BRIDGE No. 86
P.W.A. Vt. DOCKET 1092
SHEET 2 OF 13