


PARCEL	KIND	DATE	GRANTOR	GRANTEE	BOOK	PAGE	DATE	REMARKS
1	Q.C.D.O.E.	3-13-53	C.W. & Gladys Bissell	State of Vermont	15	319-320	3-26-53	
2	"	4-1-53	James A. Stone	"	15	323-324	4-4-53	
3	"	3-13-53	Veda H. Carter	"	15	317-318	3-20-53	
4	"	3-20-53	Joan N. Rendell	"	15	315	3-20-53	
5	"	3-20-53	William Lathrop	"	15	279-279	2-20-53	Condemnation
GAFB	Q.C.D.O.E.	3-13-53	Vaughn K. & Hazel A. Brown	"	15	313-314	3-20-53	Cont'd on Sheet 13

PROJ. NO.	STATE	SHEET NO.	TOTAL SHEETS
157(6)	VT.	11	135

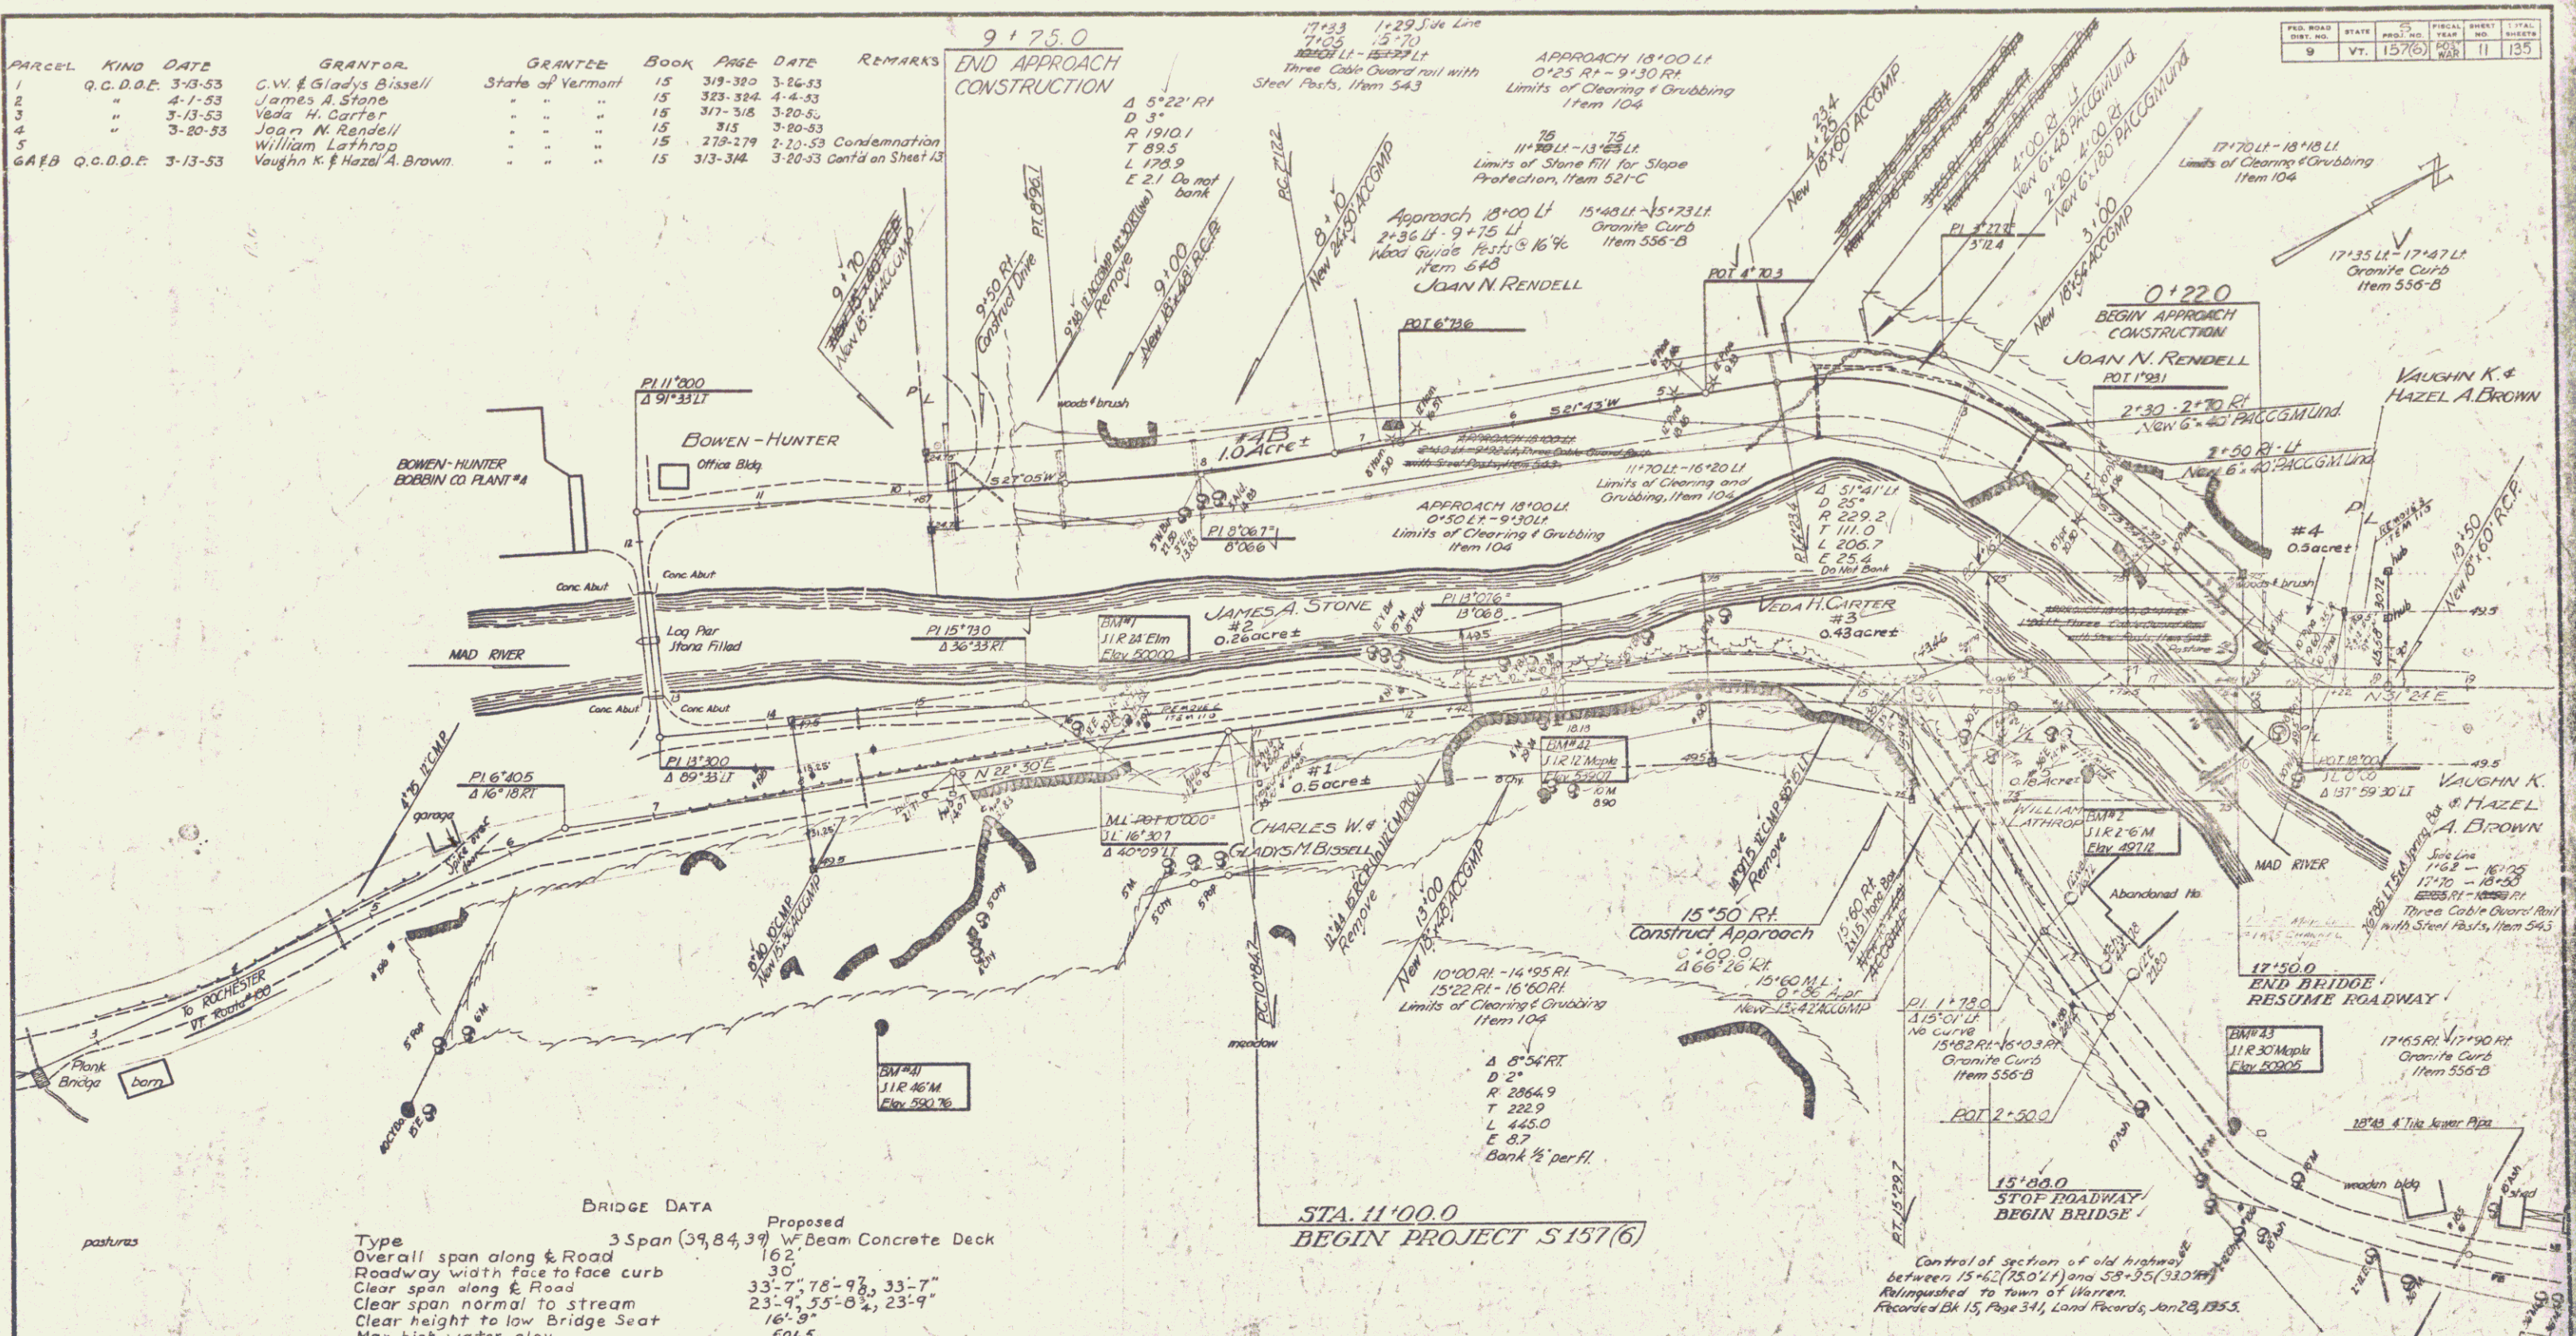

BRIDGE DATA

Type	Proposed
Overall span along E Road	3 Span (39, 84, 39) W-Beam Concrete Deck
Roadway width face to face curb	162'
Clear span along E Road	33'-7", 78'-9", 33'-7"
Clear span normal to stream	23'-9", 55'-0", 23'-9"
Clear height to low Bridge Seat	16'-9"
Max. high water elev.	501.5
Normal high water elev.	498.0
Waterway (Normal to stream)	To low Br. Seat 1220 sq. ft.
Stream Velocity	To max. H.W. Elev. 685 sq. ft.
Drift	6.5 FEET/SEC.
Scour	SLIGHT

INDEX OF SHEETS FOR BRIDGE LOG STA. 190+95

Sheet No.	Item
36	Details of Abut #1
37	Details of Pier #1
38	Details of Abut #2
39	Details of Pier #2
40	Details of Superstructure (3span 39'-84'-39', 45' Skew)
41	Reinforcing Steel Schedule
42	Standard Structure Detail S1 B 30 (H20-1)
43	Standard Structure Detail S1 B 20 Details C, D, E, H, J, K, L
44	Standard Structure Detail S1 B 51 Bridge Railing
45	Standard Structure Detail S1 B 11 Barricades, Signs & Lights for Bridges
43-47	Cross Sections (Channel)
42	Boring Notes

Estimated Bridge Quantities

106	Channel Excavation (Mod)	52071094 cy
107	Structure Excavation (Mod)	760 780 cy
110	Cutting and Removing Trees	1 / 2 each
381	Bituminous Concrete Pavement for Bridge Floors, 1460 Tons	
401B	Concrete Class B (Mod)	4101368 cy
401C	Concrete Class C (Mod)	4071342 cy
402	Reinforcing Steel	79667147.75 lbs
403A	Structural Steel	2110221210.44 lbs
407	Asphaltic Asbestos Coating	73 76 sq
526	RIPRAP FOR BANK PROTECTION	0 666 cy
572	Bridge Railing	37776
521	Stone Fill for Slope Protection	8479

WARREN

Surveyed by Foster 48-49
 Designed by
 Drawn by
 Traced by N.L.S.Jr.
 Checked by
 Series 5 No. 157(6) Filed
 Sheet 11 of 135 Sheets