
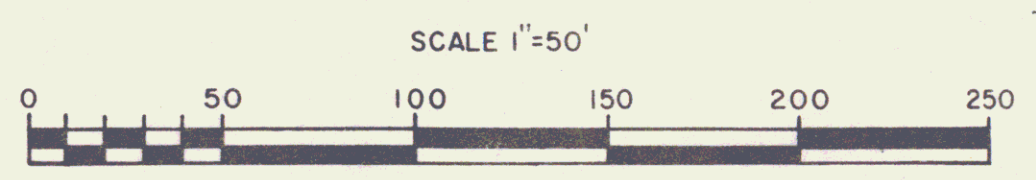


ACQUIRED BY Q.C.D. FROM VAUGHN K.
& HAZEL K. BROWN. DEED DATED
3-20-53 BOOK 15, PAGES 313-314

ST. OF VT TO BROWN
BY QCD ON 7/17/79
IN BK 51/284

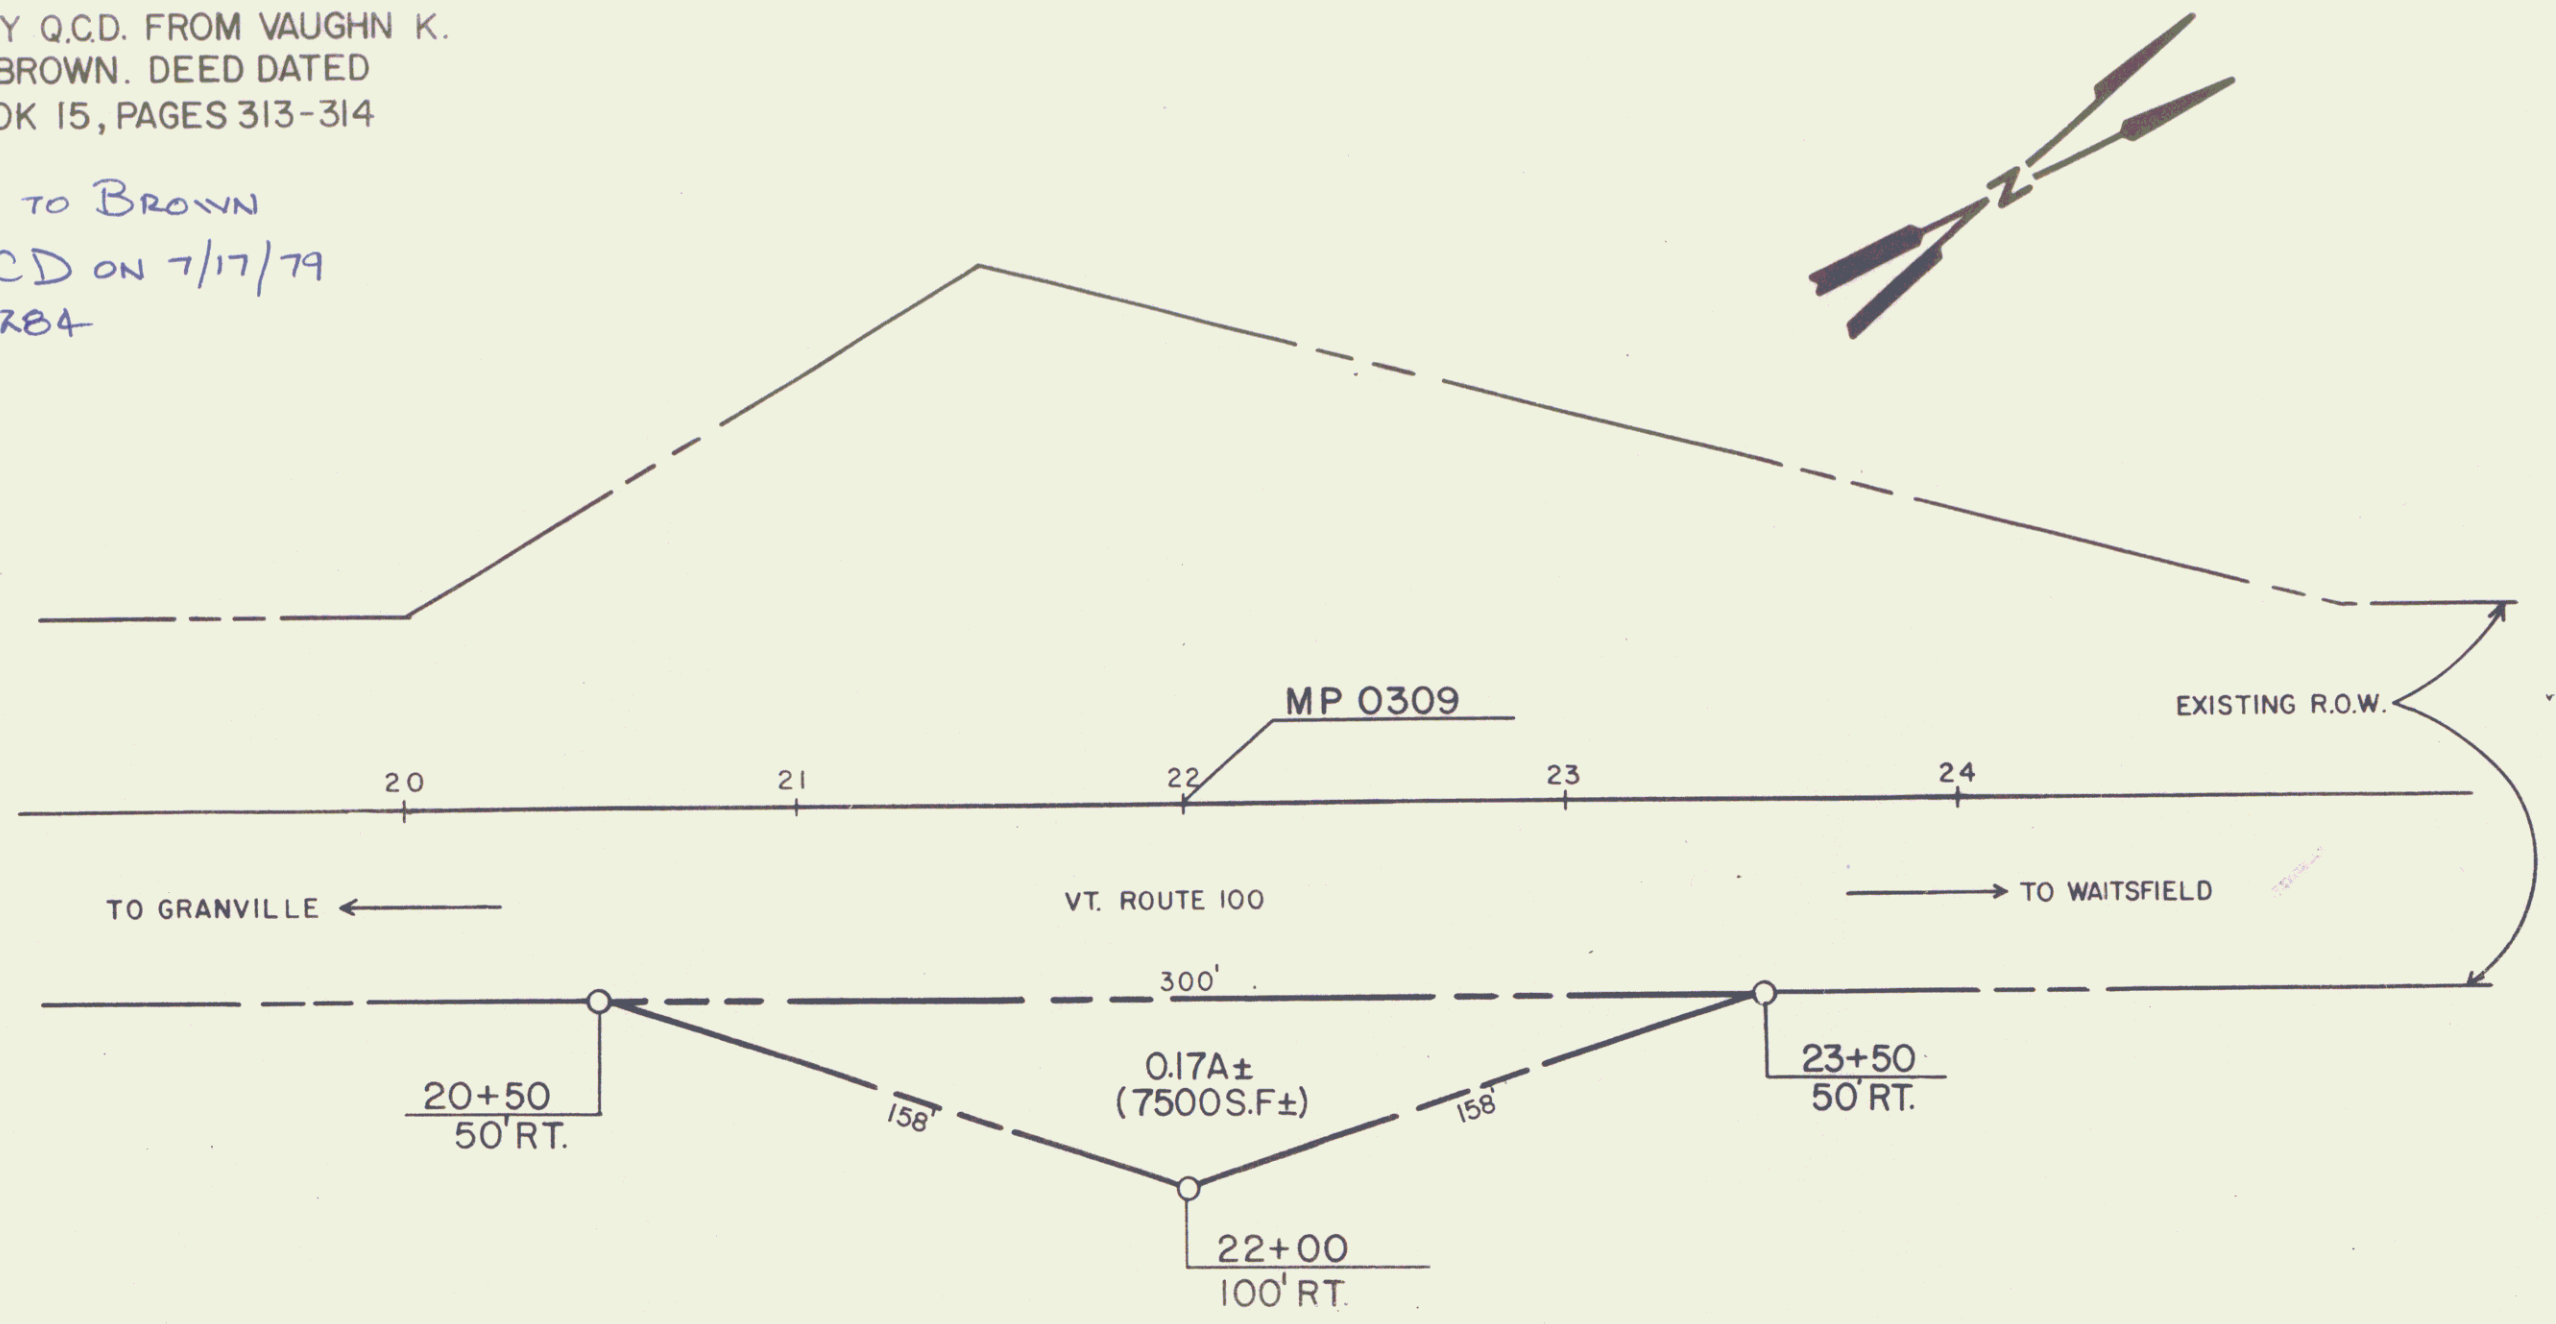

REF: PAGE 13 OF 135 SHEET 13A

STATE OF VERMONT AGENCY OF TRANSPORTATION		
TOWN OF WARREN		
PROJECT	S157 (6)	4
APPROX SCALE 1"=	50'	DATE 5-28-79
		DRAWN BY D. O'NEWHALL

176