



PLAN
 DATE: 3-21-51
 DRAWN BY: J. W. WARREN
 CHECKED BY: J. W. WARREN

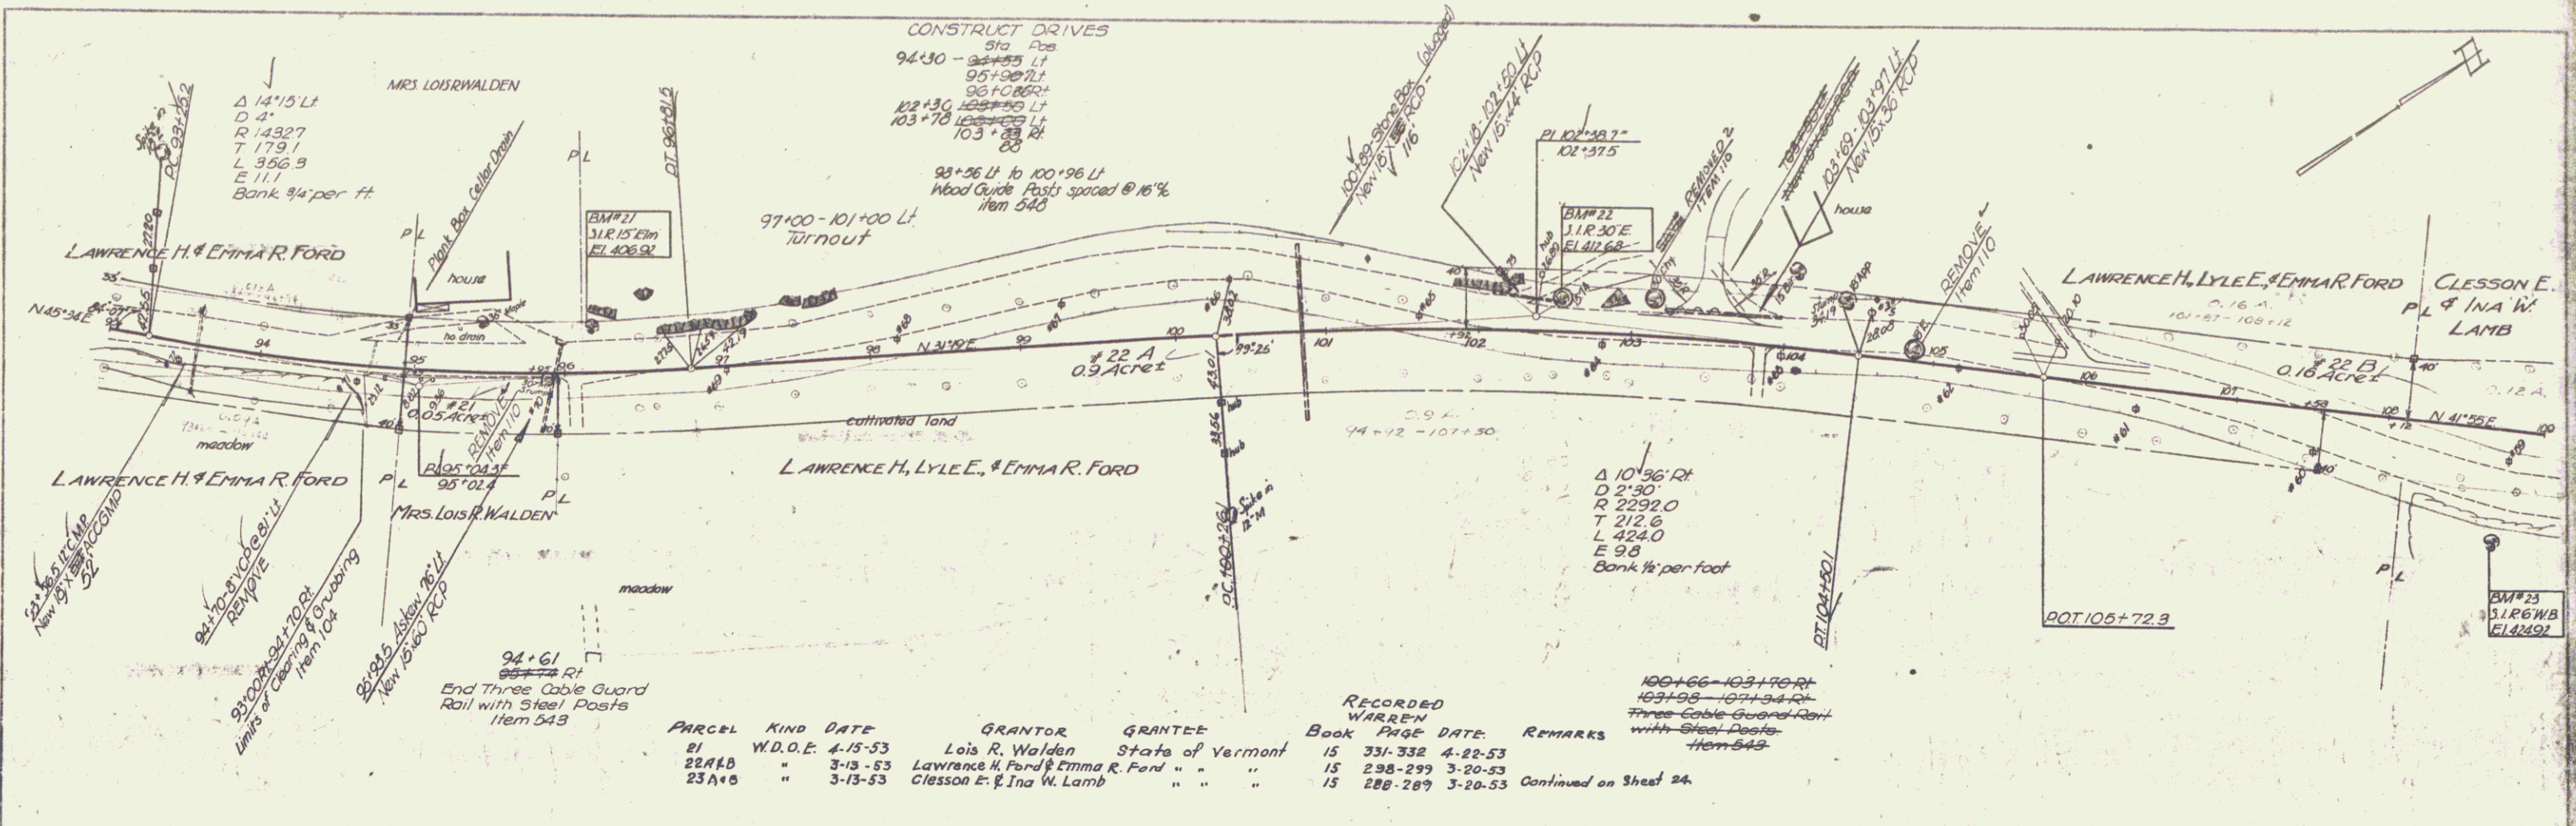

PARCEL	KIND	DATE	GRANTOR	GRANTEE	RECORDED	WARREN	DATE	REMARKS
21	W.D.O.E.	4-15-53	Lois R. Walden	State of Vermont	15	331-332	4-22-53	
22A+B	"	3-13-53	Lawrence H. Ford & Emma R. Ford	"	15	298-299	3-20-53	
23A+B	"	3-13-53	Clesson E. & Ina W. Lamb	"	15	288-289	3-20-53	Continued on Sheet 24.

PROFILE
 DATE: 3-21-51
 DRAWN BY: J. W. WARREN
 CHECKED BY: J. W. WARREN

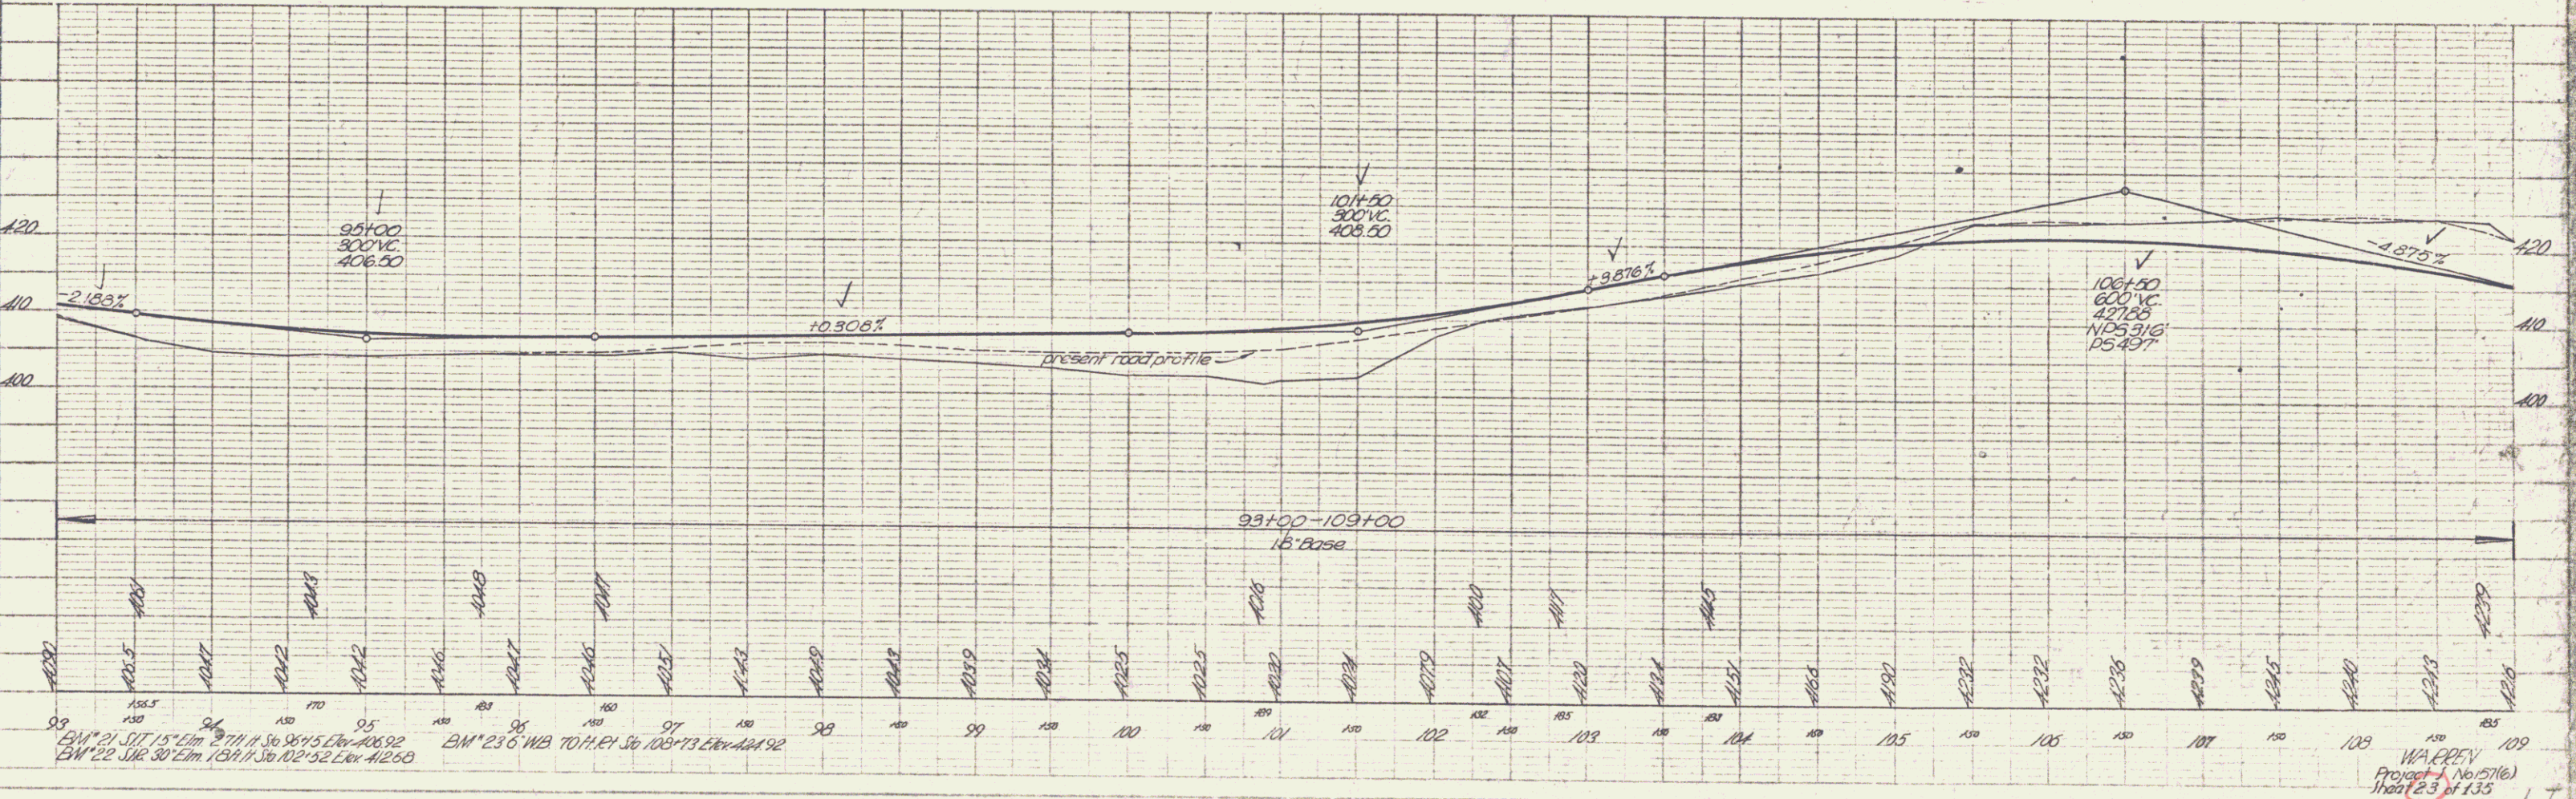

WARREN
 Project No. 5716
 Sheet 23 of 135