
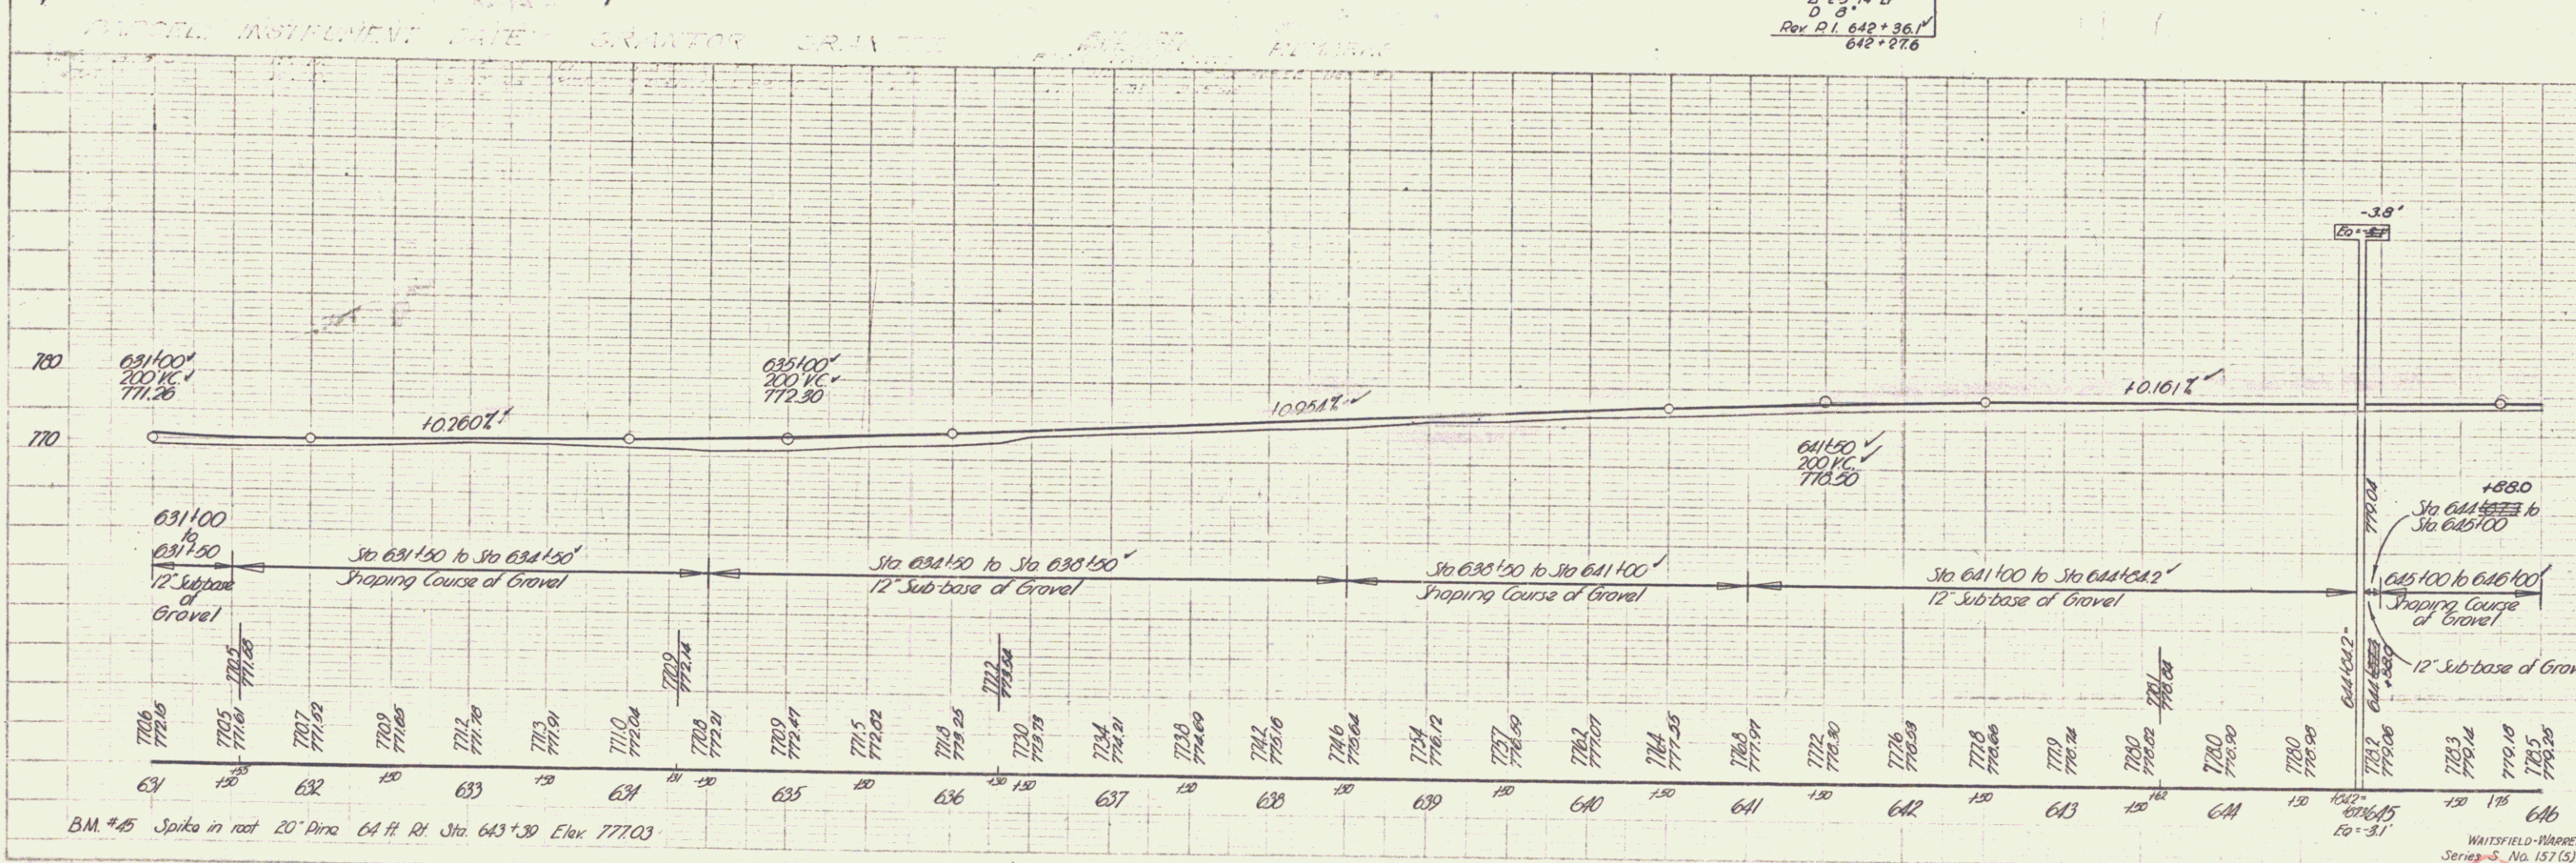


PARCEL	INSTRUMENT	DATE	GRANTOR	GRANTEE	RECORDED	REMARKS
#10 A, B, C	W. D.	7-15-48	CHAS. WENDELL & MAY FOLSOM	ST. OF VT.	BOOK PAGE DATE	
#7 A	W. D.	9-17-48	MERRITT D. & HAZEL L. BRAGG	ST. OF VT.	17 404-425 7-9-49	W.A.B. - 5th SHEETS
					17 429 9-18-48	

1571(5) 1948 9 41

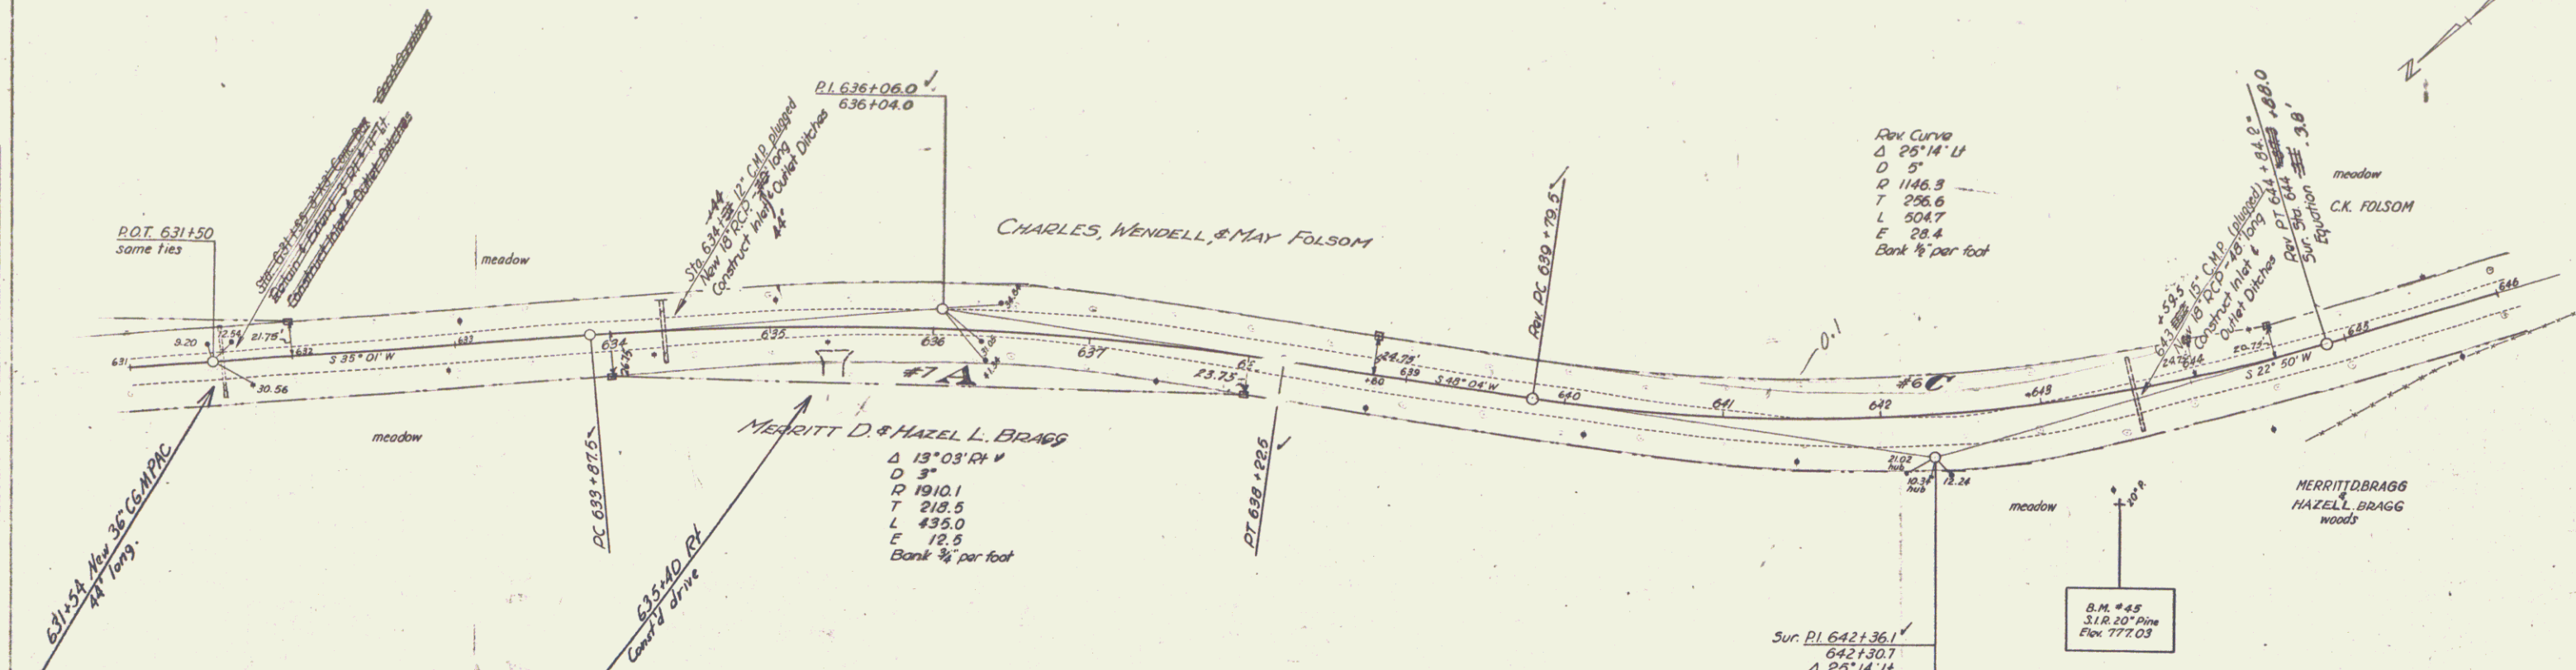

PLAN
Merritt D. Bragg
Hazel L. Bragg
1571(5) 1948 9 41

PROFILE
Merritt D. Bragg
Hazel L. Bragg
1571(5) 1948 9 41

B.M. #45 Spike in root 20\"/>

WAITSFIELD-WARDEN
Series No. 157 (5)
Sheet 9 of 41 Sheets

7