



CONSTRUCT DRAWS	
NO.	DATE
1	5/10/48
2	5/10/48
3	5/10/48
4	5/10/48
5	5/10/48
6	5/10/48
7	5/10/48
8	5/10/48
9	5/10/48
10	5/10/48

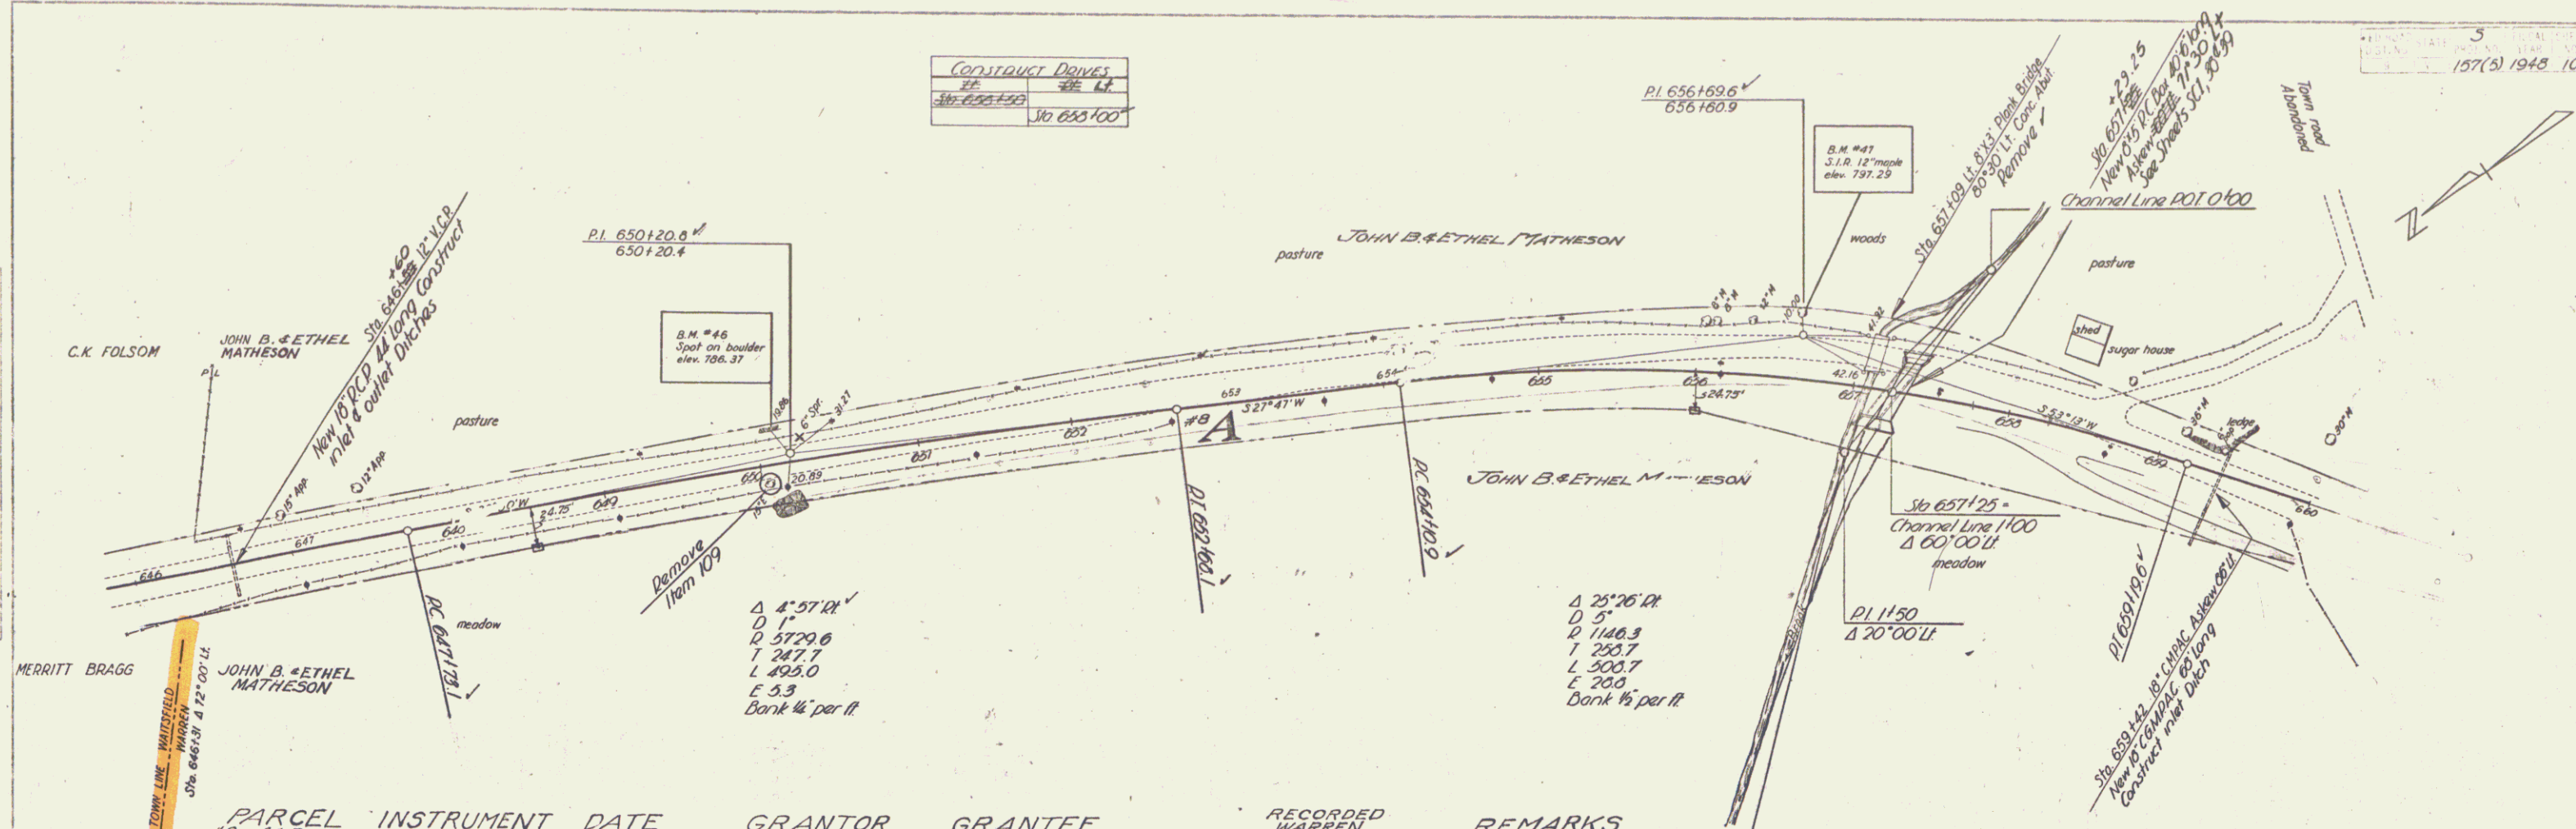

PARCEL	INSTRUMENT	DATE	GRANTOR	GRANTEE	RECORDED	WARREN	REMARKS
NO.	NO.				BOOK	PAGE	
13	442	7-1-48	JOHN B. & ETHEL MATHESON	ST. OF VT.	9	362	SHIRT II

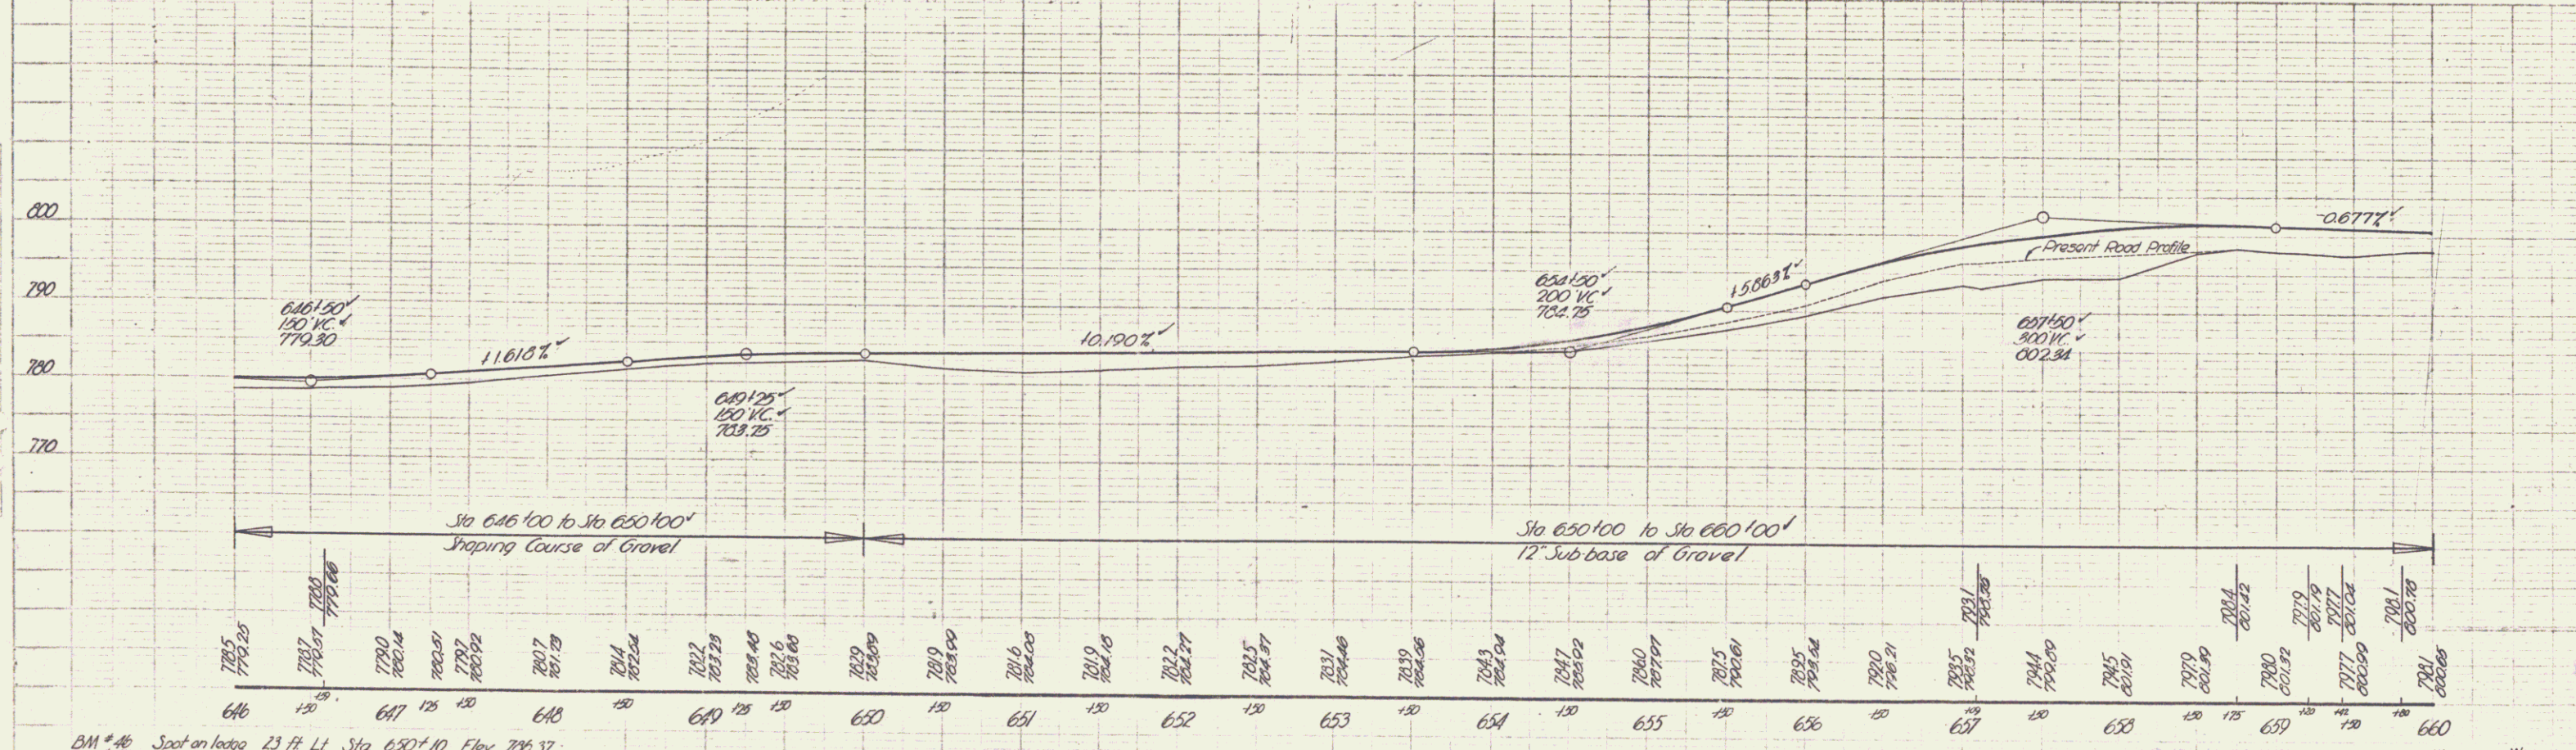

B.M. #46 Spot on ledge 23 ft. LI Sta. 650+10 Elev. 706.37  
 B.M. #47 Spoke in root 12" Maple 38 ft. LI Sta. 656+63 Elev. 737.29