



PLAN
 PLANNING
 ALIGNMENT OFFICE
 100 STATE ST.
 MONTPELIER, VT.
 A. Hoad
 D. Martin

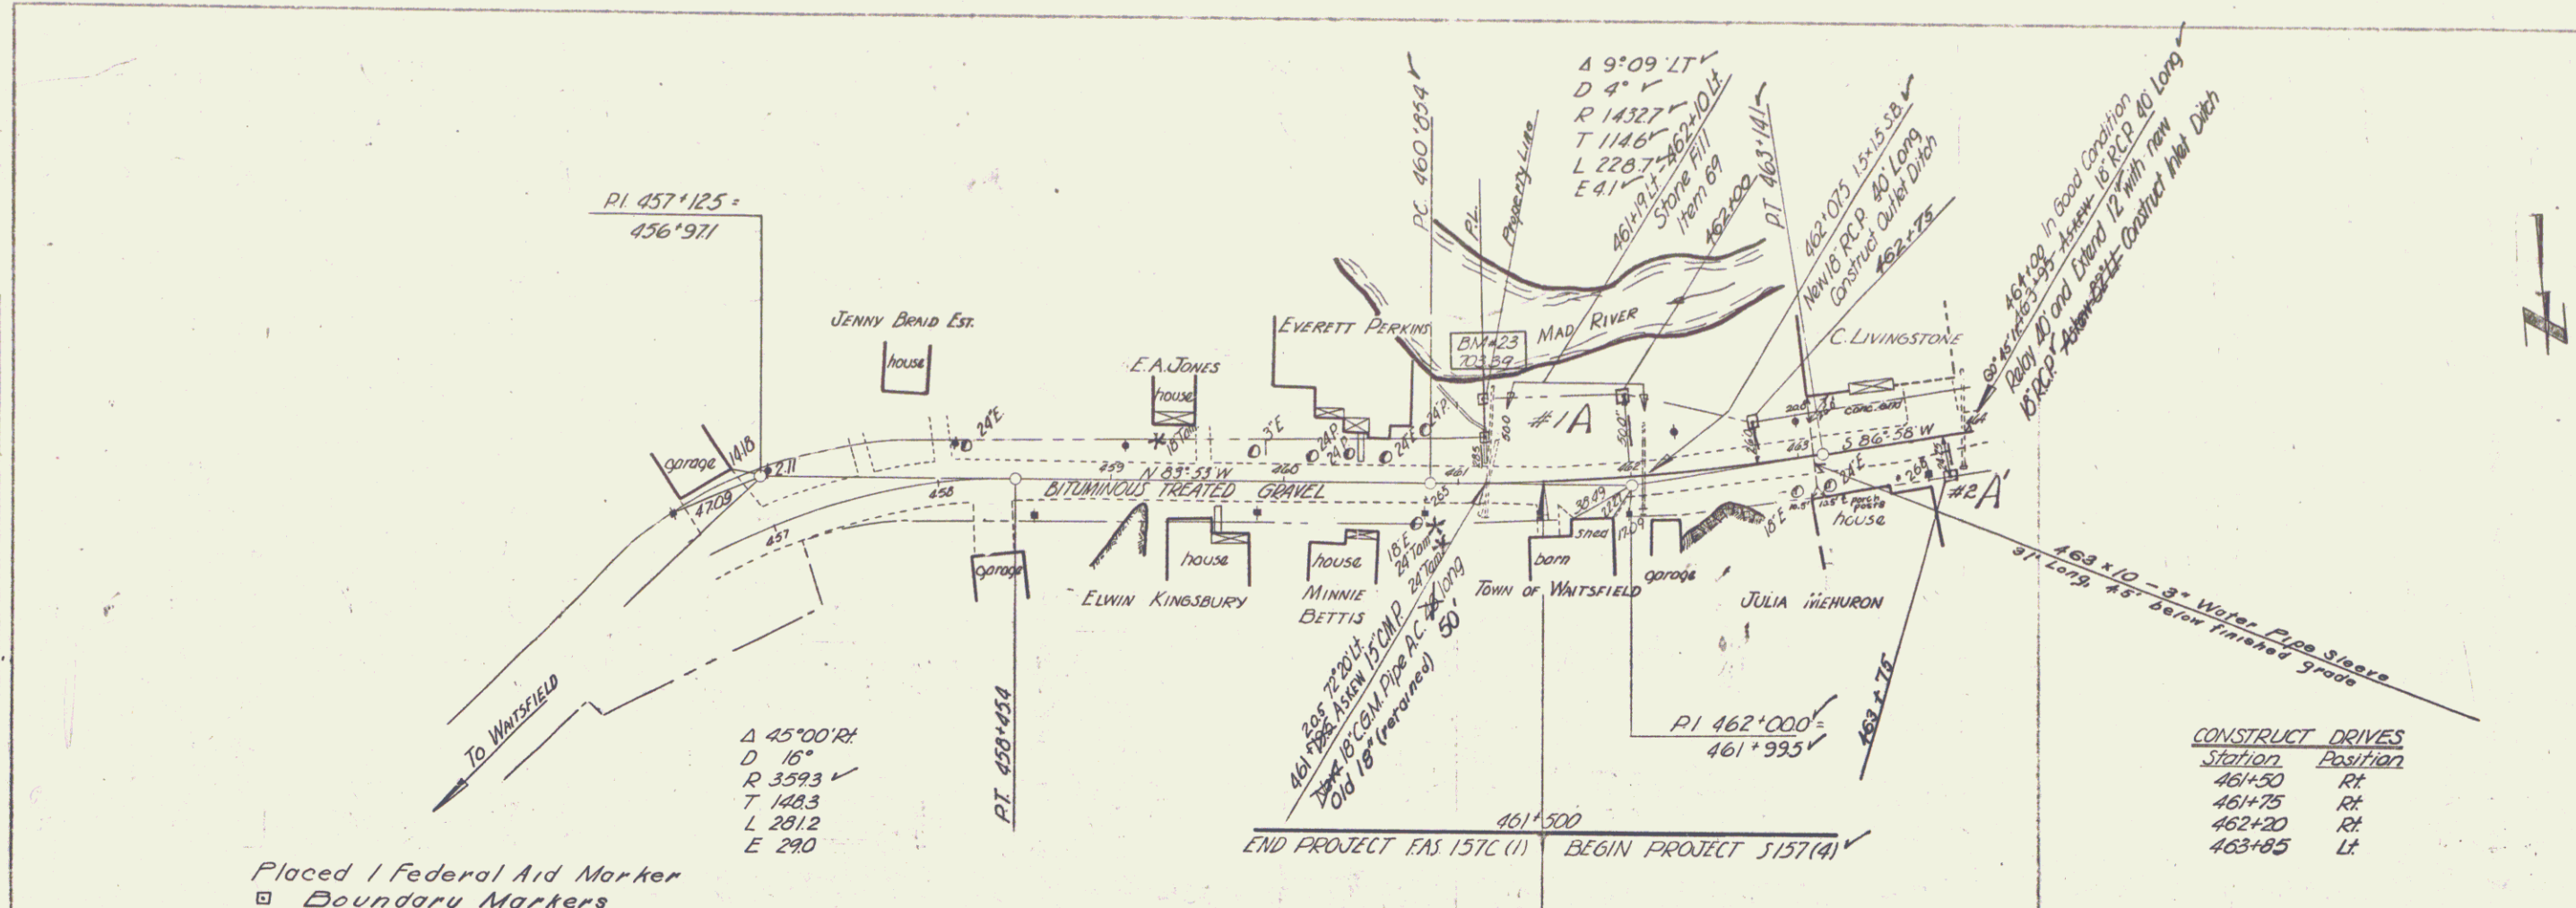

CONSTRUCT DRIVES

Station	Position
461+50	Rt
461+75	Rt
462+20	Rt
463+85	Lt

PARCEL	INSTRUMENT	DATE	GRANTOR	GRANTEE	RECORDED	WAITSFIELD	REMARKS
#1 A,B,C	WDOE	1-19-45	CHARS. A. PATTERSON	ST OF VT	17	374	1-25-45 C.M. 463'95' #1 B,C ON SHEET 6
#2 A'	WDOE	12-22-44	JULIA MEHURON	ST OF VT	17	368	12-30-44

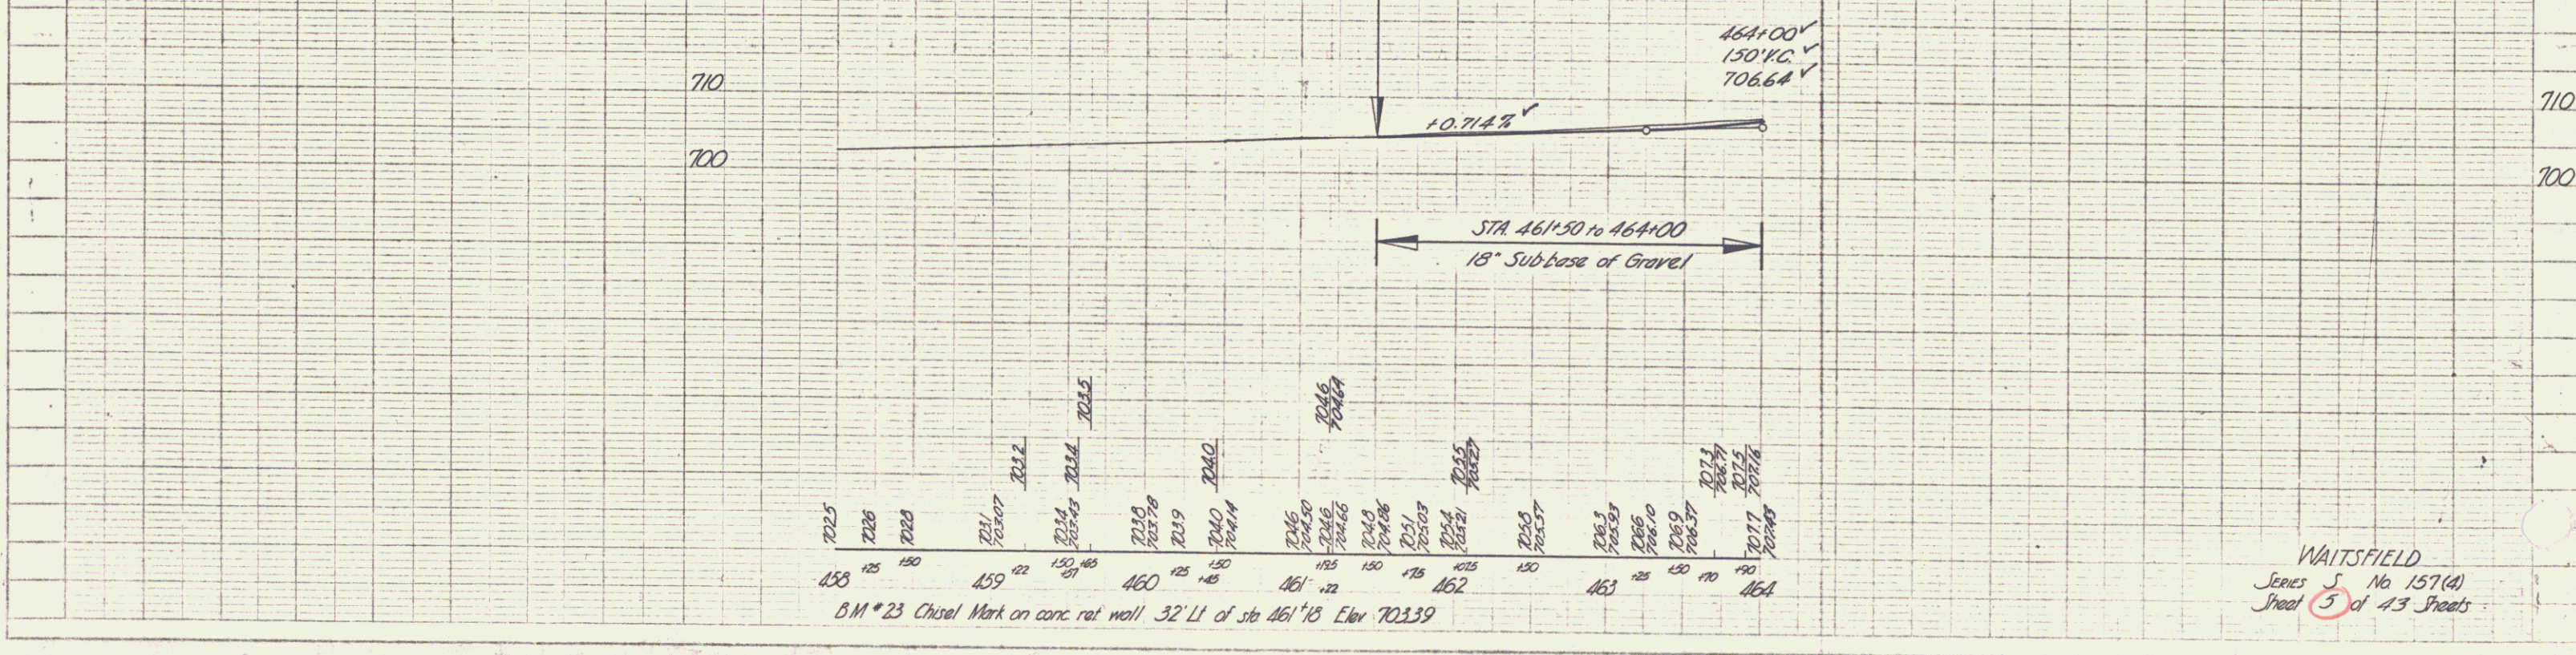

8.1M * 23 Chisel Mark on conc. rat wall. 32' Lt of sta 461'13 Elev 702.39

WAITSFIELD
 Series S No 157(4)
 Sheet 5 of 43 Sheets