


CONSTRUCT DRIVES  
 Station Position  
 467+75 Rt  
 469+00 Lt  
 468+25 Rt  
 470+60 Rt  
 471+45 Rt  
 472+30 Lt  
 473+00 Rt  
 474+60 Rt  
 476+50 Lt  
 478+45 Rt

Rev Curve  
 $\Delta 40^{\circ}15'11''$   
 D 5'  
 R 1146.3  
 T 4200  
 L 8050  
 E 745  
 bank  $\frac{1}{2}$  per ft

REV. P.I.	STATION	GRANTOR	GRANTEE	BOOK	PAGE	DATE	REMARKS
472+00	472+00	GERALD O. & LAURA B. STOKES	ST. OF VT.	17	369	12-30-44	
472+50	472+50	CHARLES MANHAM	ST. OF VT.	17	370	1-25-45	
472+50	472+50	ARTHUR & ELEANOR GRATTON	ST. OF VT.	17	362	11-10-44	#5 C ON SHEET 7
472+50	472+50	CHARLES H. WINGGONG	ST. OF VT.	17	365	8-30-44	
472+50	472+50	ALBERT J. & DOROTHY FECTEAU	ST. OF VT.	17	365	7-30-44	

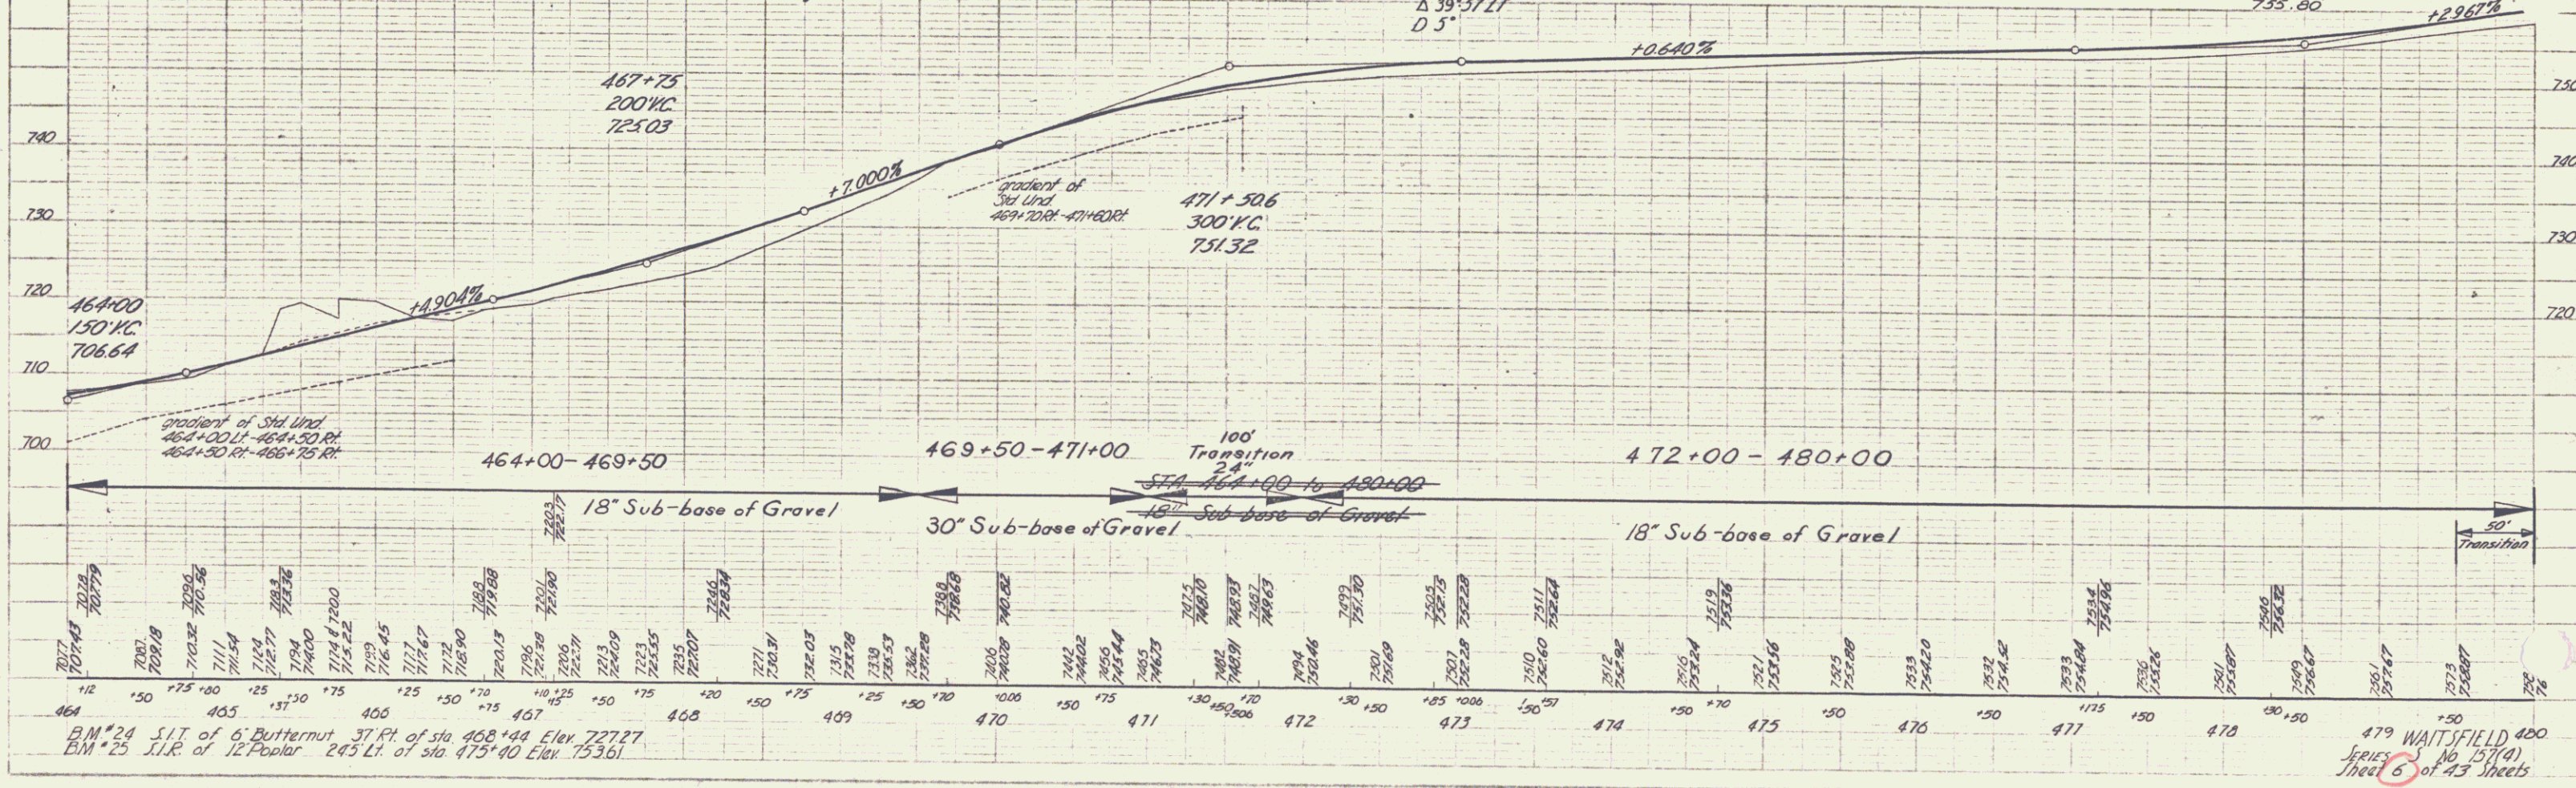

Vertical Curve  
 Station  
 464+00  
 466+75  
 469+50  
 472+25  
 475+00

Vertical Curve  
 Station  
 464+00  
 466+75  
 469+50  
 472+25  
 475+00

BM#24 S.I.T. of 6 Butternut 31 ft. of sta 468+44 Elev. 727.27  
 BM#25 S.I.R. of 12 Poplar 245 ft. of sta 475+40 Elev. 753.61

479 WAITSFIELD 400  
 Sheets No. 157(a)  
 Sheet 6 of 43 Sheets