


PLAN  
 A. Wood  
 1947  
 D. M. H. P.  
 REVISIONS  
 NO. DATE BY  
 1 1/15/47 A. Wood  
 2 1/15/47 A. Wood  
 3 1/15/47 A. Wood  
 4 1/15/47 A. Wood  
 5 1/15/47 A. Wood

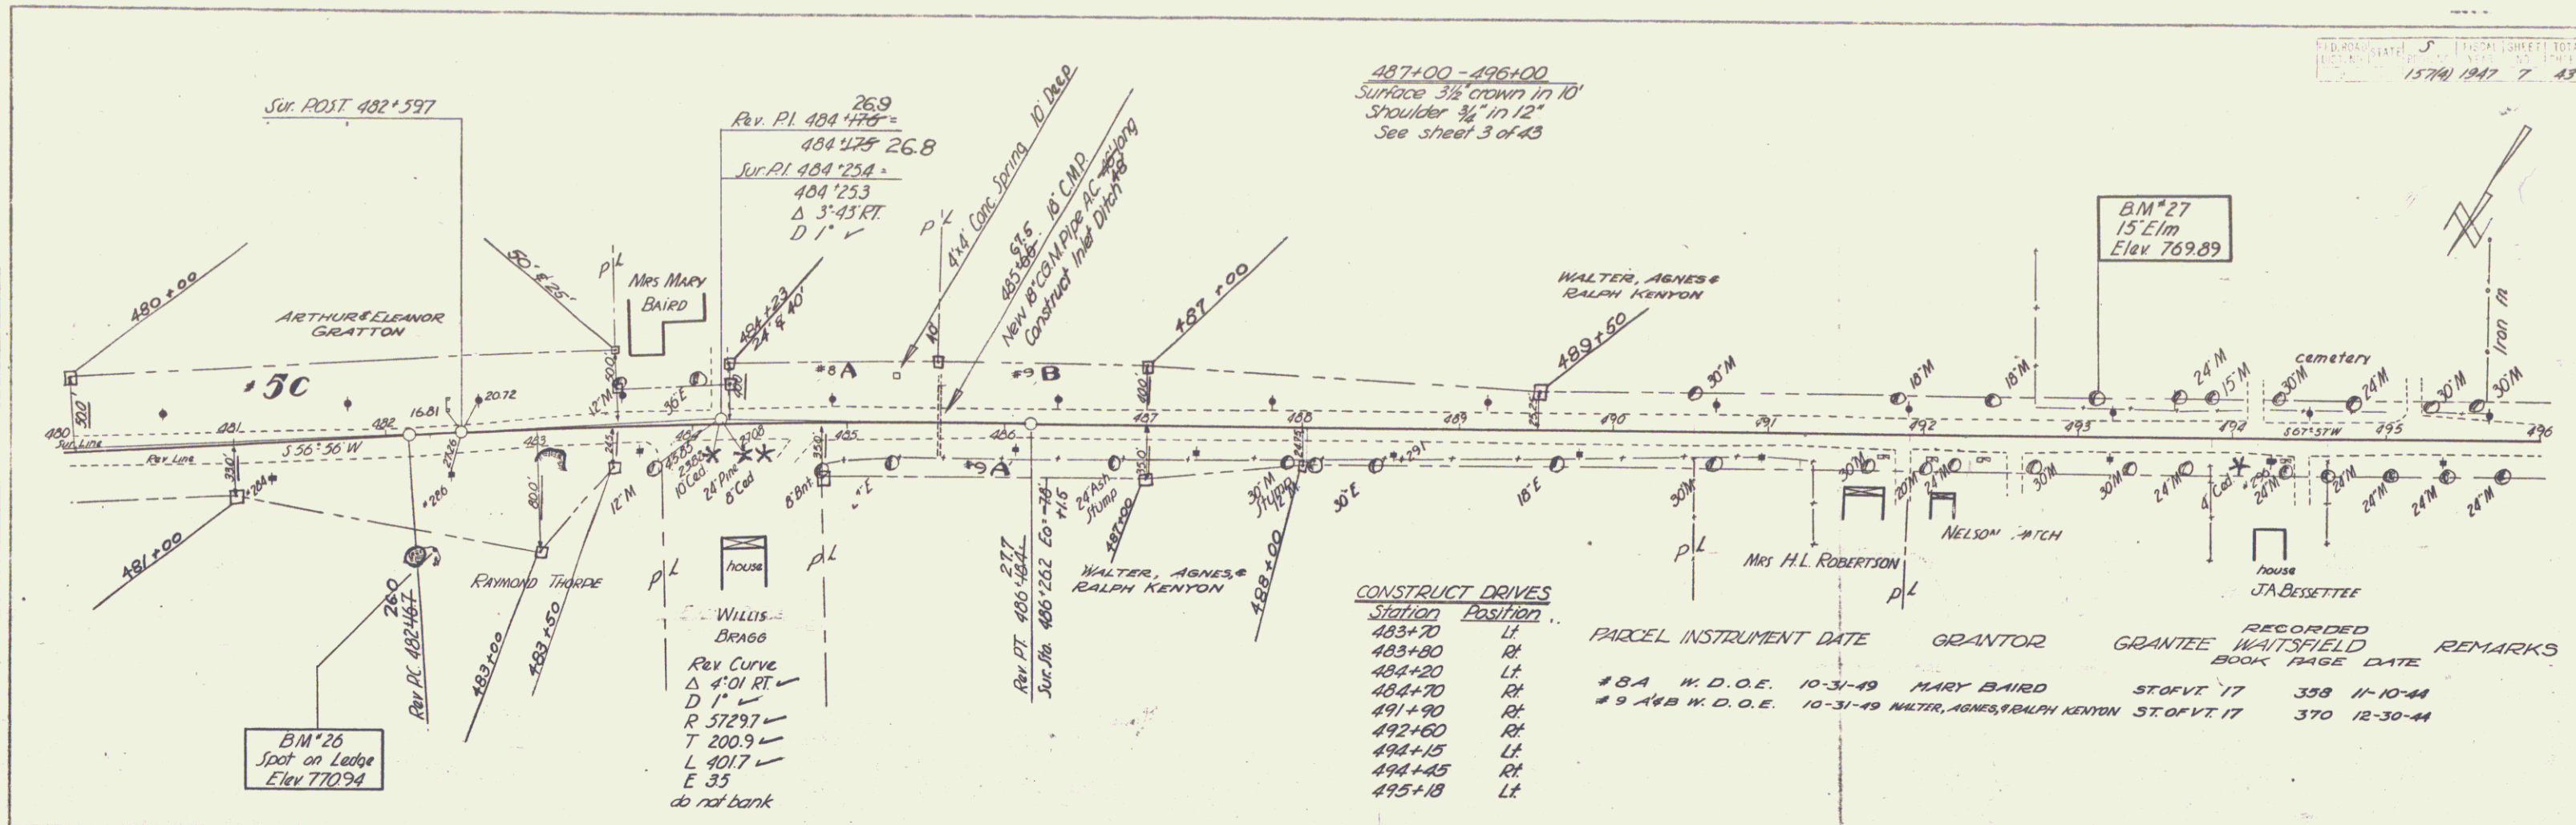


CONSTRUCT DRIVES

Station	Position
483+70	Lt
483+80	Rt
484+20	Lt
484+70	Rt
491+90	Rt
492+60	Rt
494+15	Lt
494+45	Rt
495+18	Lt

PARCEL	INSTRUMENT DATE	GRANTOR	GRANTEE	RECORDED BOOK	WAITSFIELD PAGE	DATE	REMARKS
# 8 A	W. D. O. E. 10-31-49	MARY BAIRD	ST. OF VT.	338	11-10-44		
# 9 A & B	W. D. O. E. 10-31-49	WALTER, AGNES & RALPH KENYON	ST. OF VT.	370	12-30-44		

PROFILE  
 A. Wood  
 1947  
 D. M. H. P.  
 REVISIONS  
 NO. DATE BY  
 1 1/15/47 A. Wood  
 2 1/15/47 A. Wood  
 3 1/15/47 A. Wood  
 4 1/15/47 A. Wood  
 5 1/15/47 A. Wood

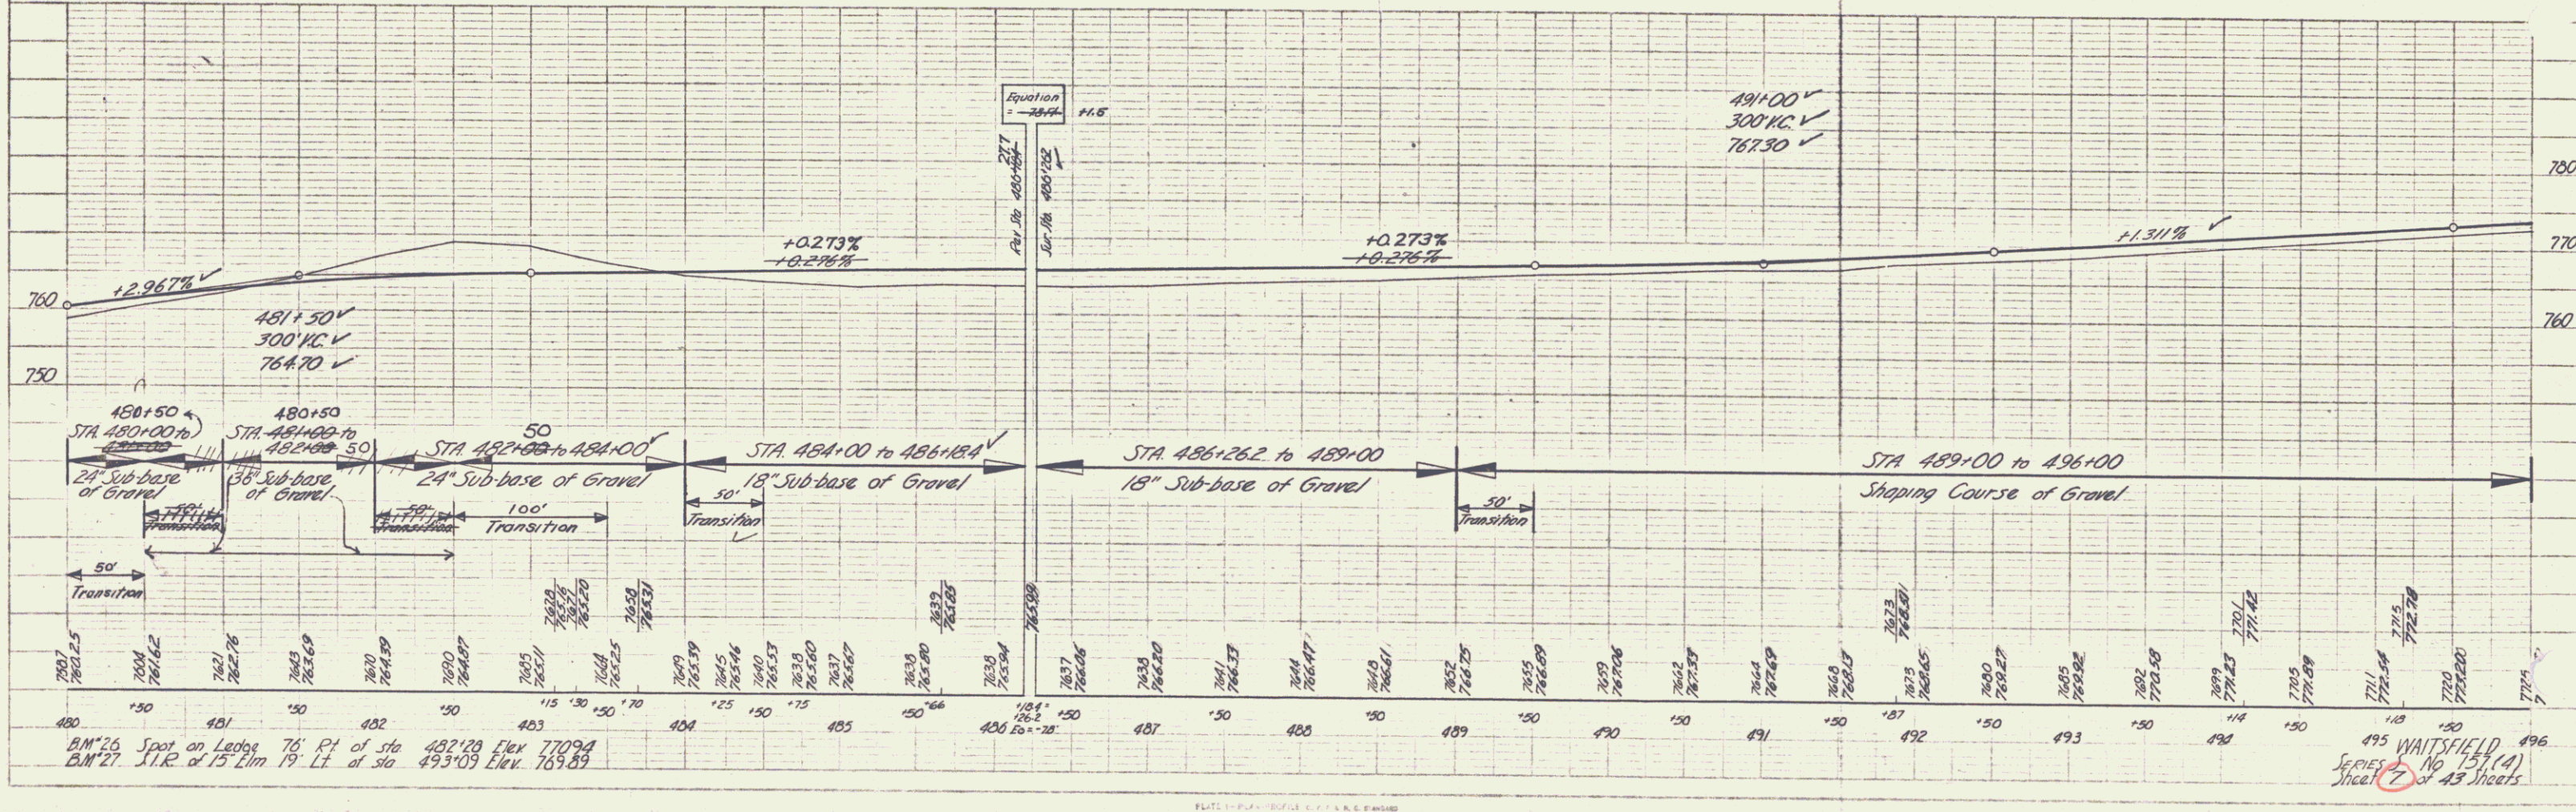

B.M. #26 Spot on Ledge Elev 770.94  
 B.M. #27 15' Elm 19' Lt of sta 493+09 Elev 769.89

495 WAITSFIELD  
 SERIES NO 151 (A)  
 SHEET 7 OF 43 SHEETS