


ED. ROAD DIST. NO.	STATE	PROJ. NO.	YEAR	SHEET NO.	TOTAL SHEETS
9	VT.	3-15701-1947		9	43

SLOPES TO BE MULCHED Item III

Station to Station	Position
504+20 - 508+25	Lt.
506+75 - 508+25	Rt.
508+75 - 511+00	Rt.
508+85 - 511+00	Lt.

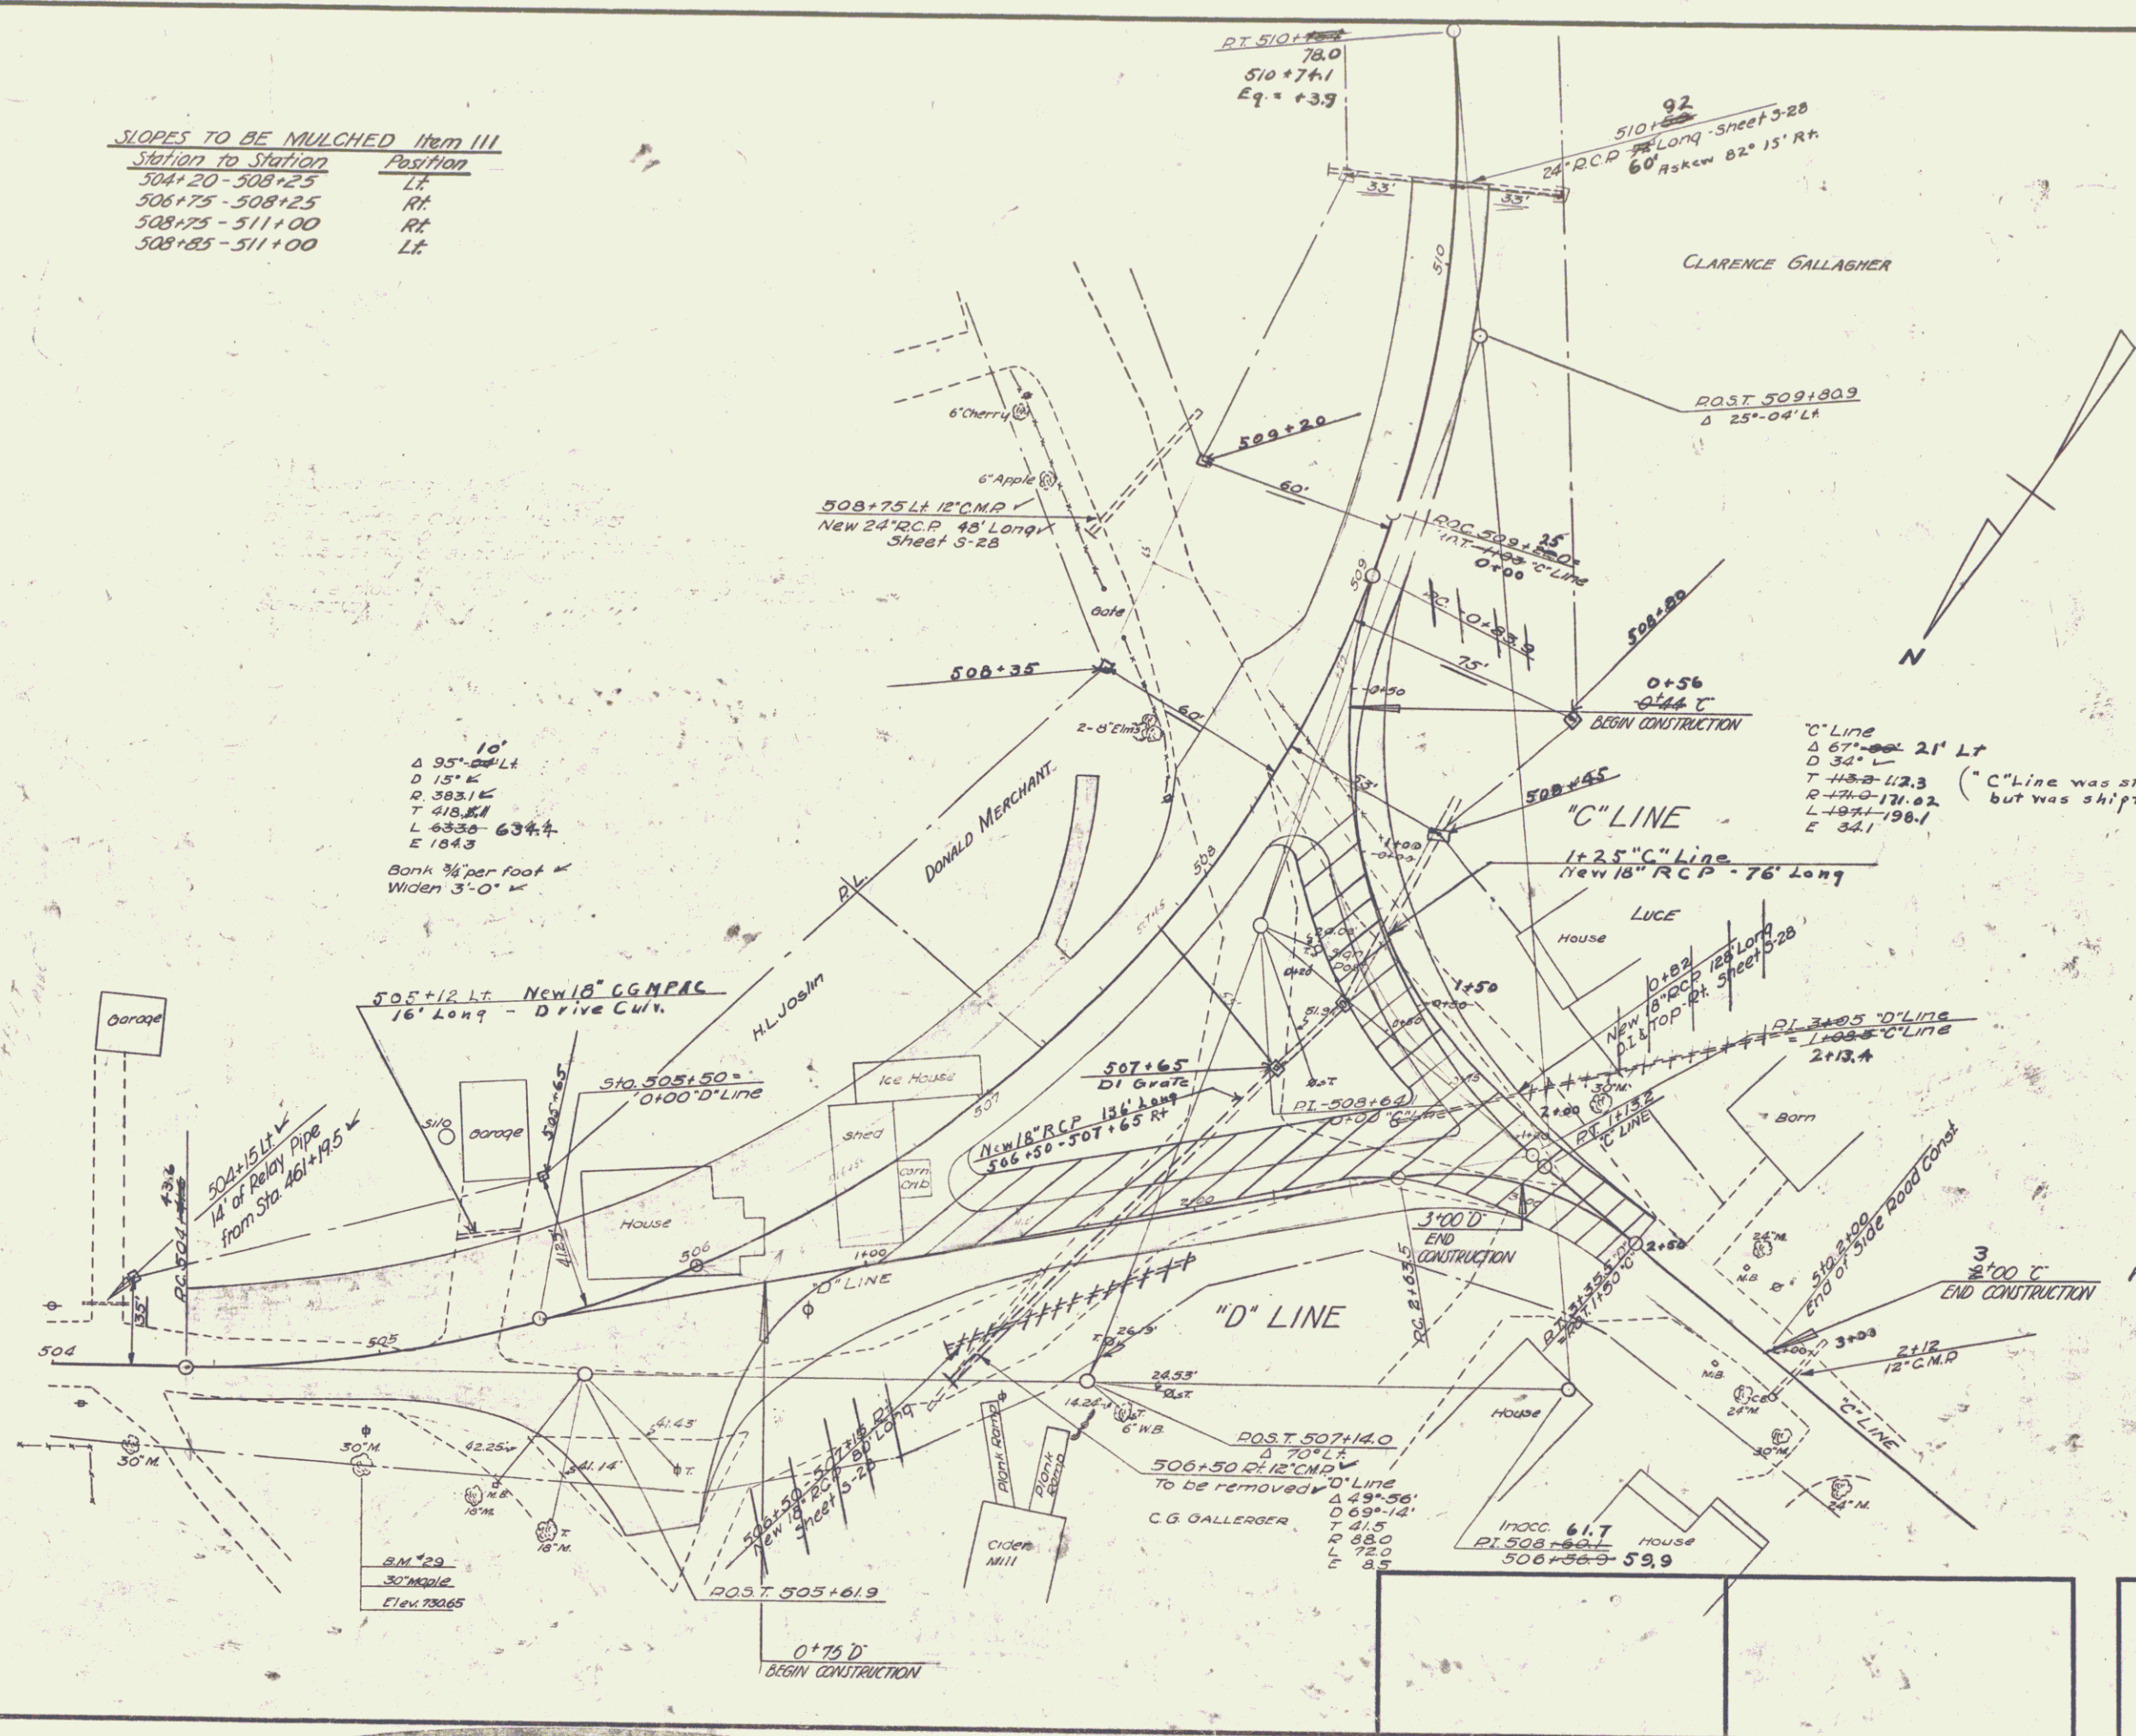

10"
 Δ 95'-00" Lt.
 D 15' K
 R 383.1 E
 T 418.8 E
 L 483.3 = 634.4
 E 184.3
 Bank 3/4" per foot W
 Widen 3'-0" W

"C" Line
 Δ 67'-00" 21' Lt
 D 34' L
 T 48.8-112.3 ("C" Line was staked according to notes but was shifted to suit terrain)
 R 171.0-171.02
 L 194.1-198.1
 E 34.1

SCALE: 1" = 25'

WAITSFIELD

Surveyed by
 Designed by
 Drawn by
 Traced by
 Checked by

Series 5 No. 157(A) Filed
 Sheet 9 of 43 Sheets