
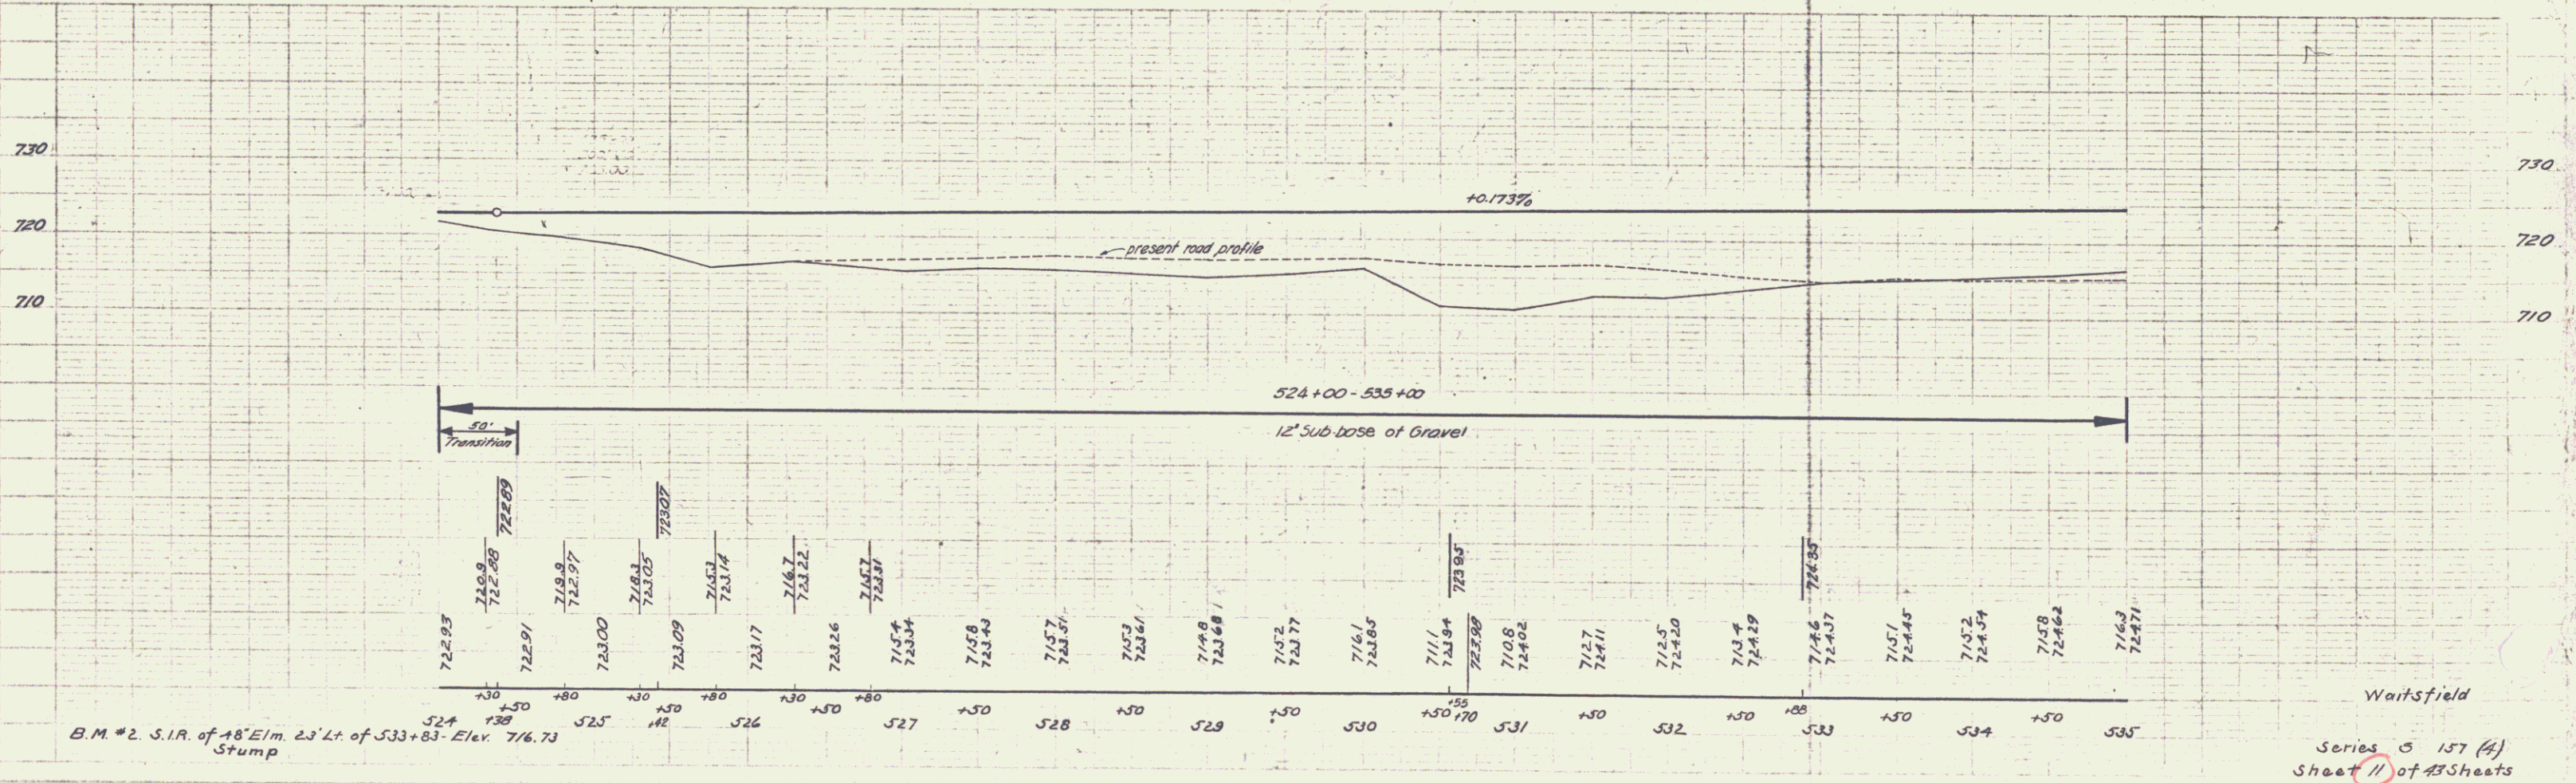


PARCEL	INSTRUMENT	DATE	GRANTOR	GRANTEE	RECORDED	REMARKS
#10A	W.D.E.	10-31-44	MELVIN C. LIVINGSTON	ST. OF VT.	17 361	11-10-44 1 CULV
#11A+B	W.D.E.	8-29-44	OTTO E. & ELSIE BECHER	ST. OF VT.	17 358	11-10-44
#12A+B+C	W.D.E.	10-31-44	PHILIPPE FLEURETTE LAREAU	ST. OF VT.	17 364	11-10-44 2 CULV

SCALE 1" = 40' HORIZONTAL
 1" = 10' VERTICAL
 157 (4) 1947 11 43

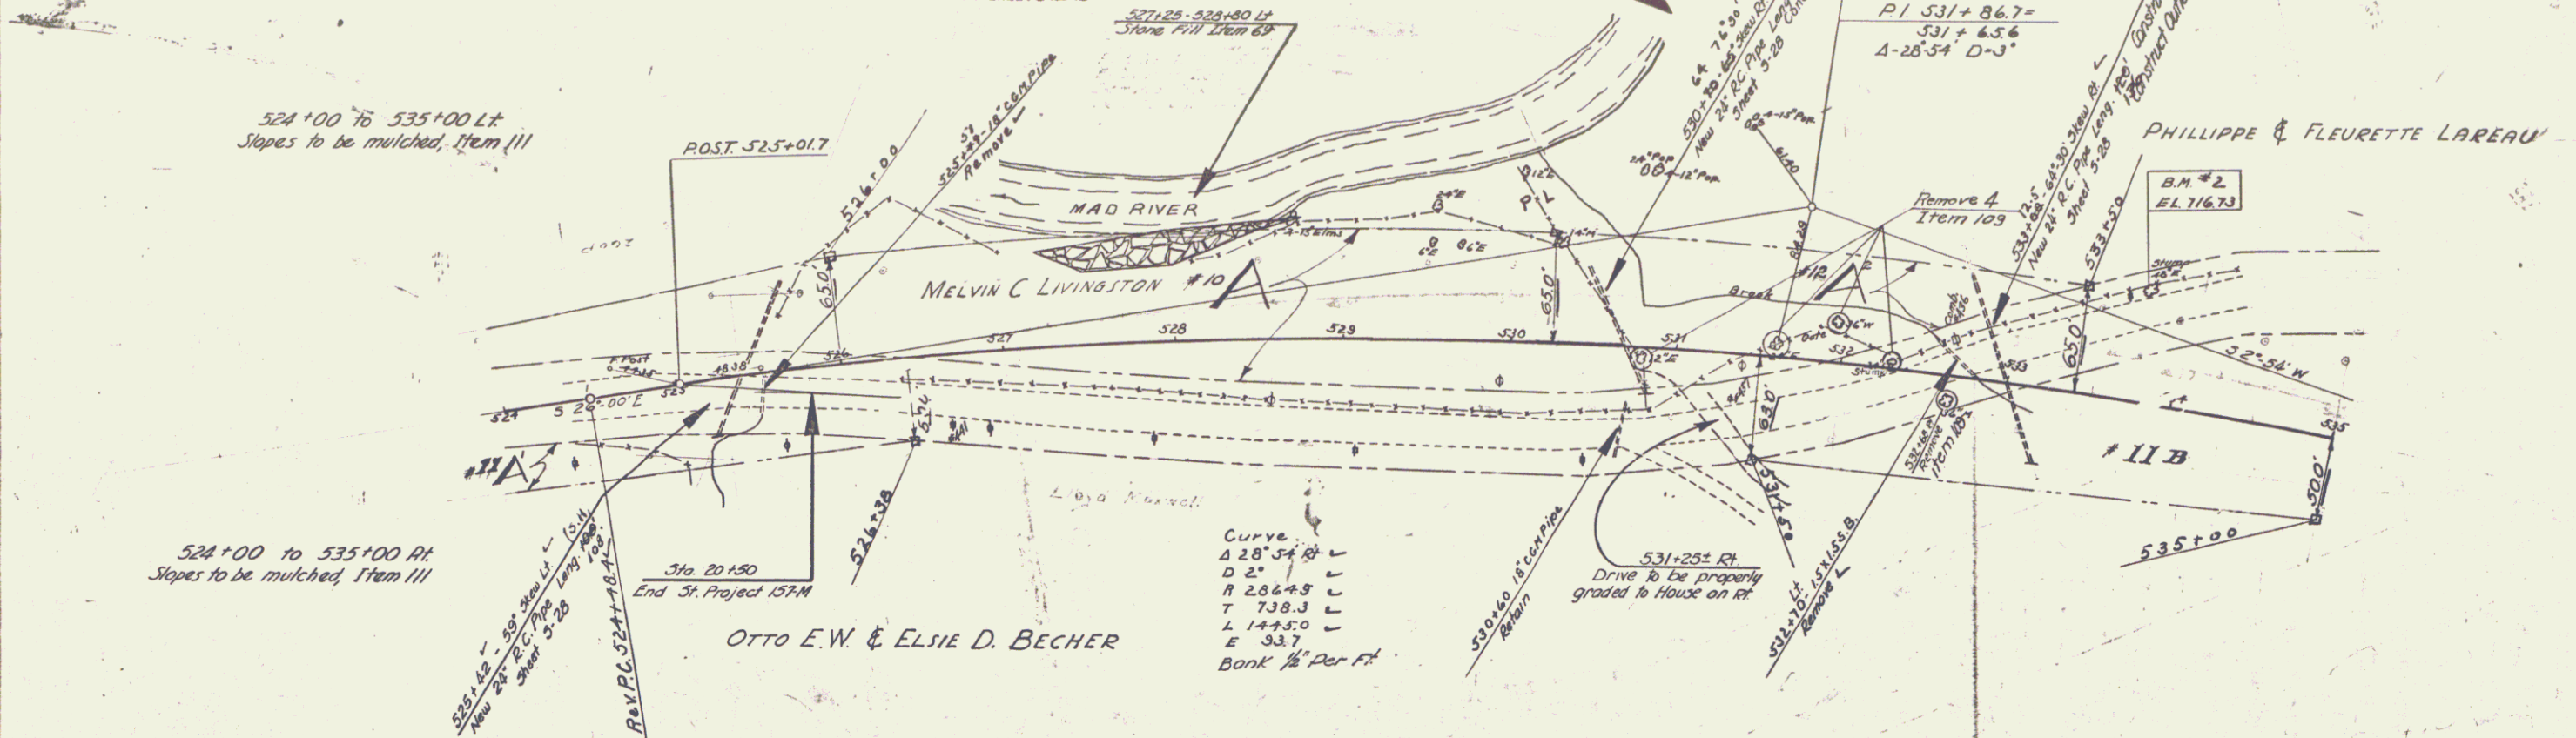

Waitfield
 Series 5 157 (4)
 Sheet 11 of 43 Sheets