


NOTE:  
EXISTING GUARD RAIL & GUIDE POSTS.  
Any existing guard rail or guide posts that may be taken down are to become the property of the State. The cable shall be reeled and stoned and the posts and planking piled in such locations as may be determined by the Engineer.

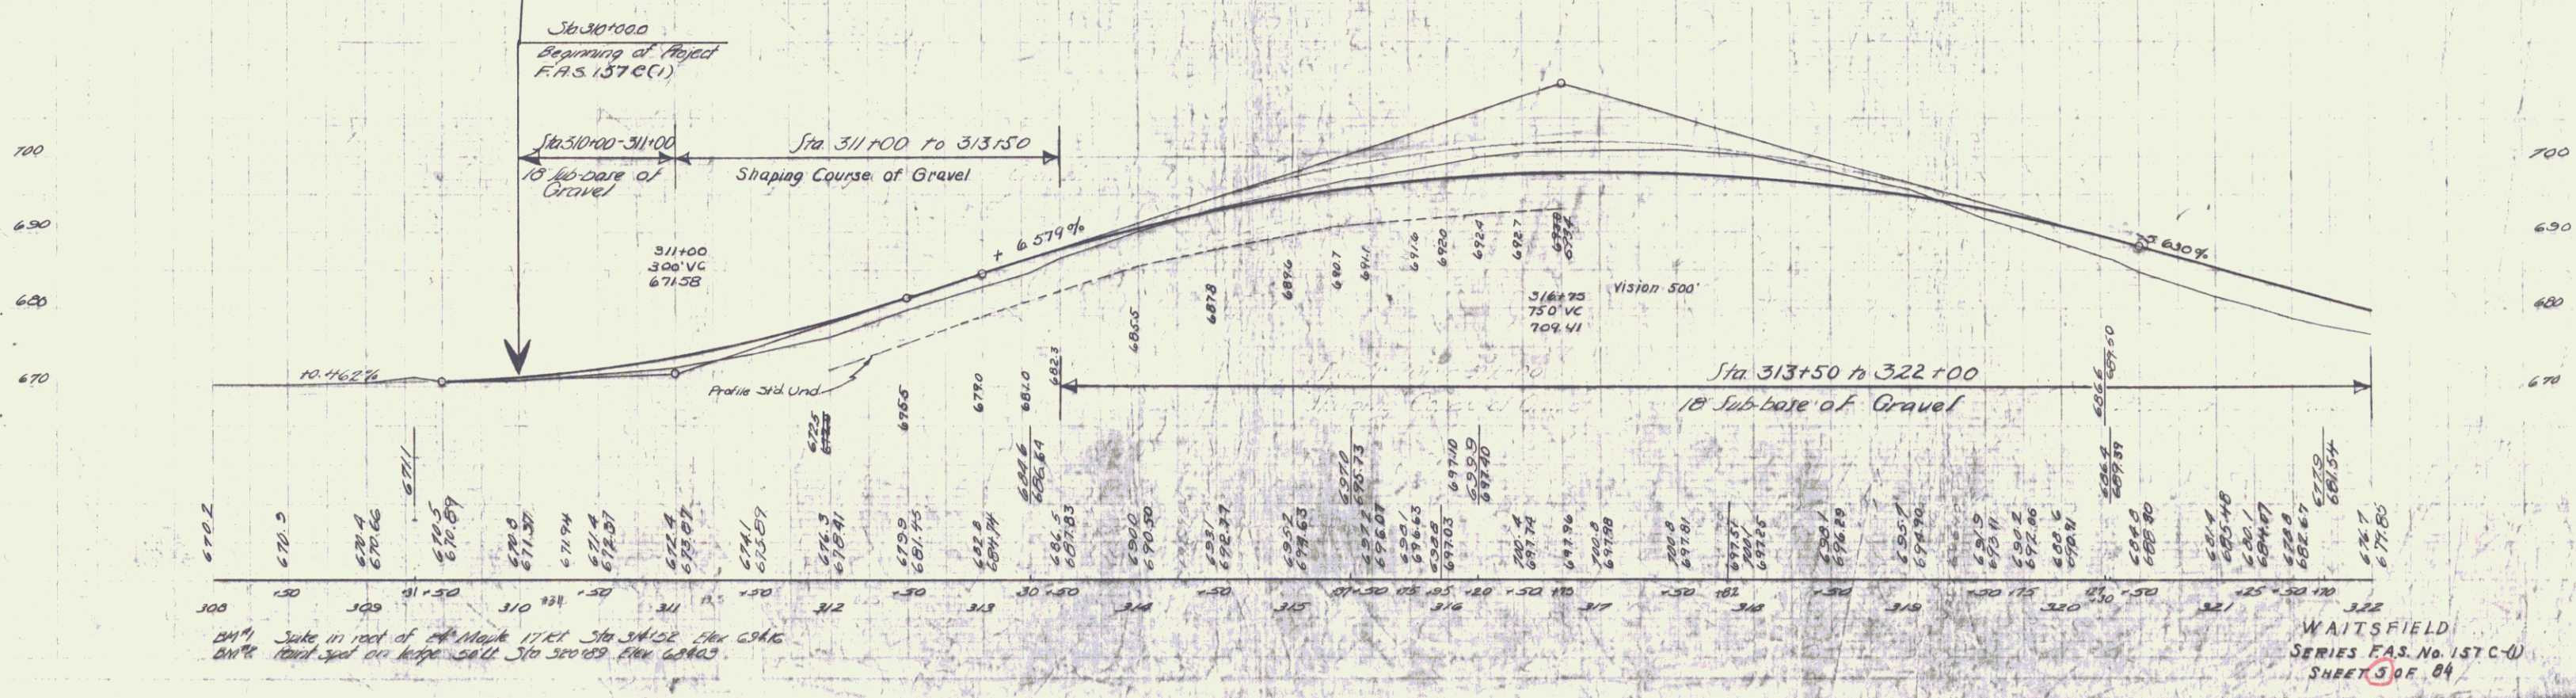

WAITSFIELD  
SERIES F.A.S. No. 157C(1)  
SHEET 3 OF 84