



Shed & Garage
33713-337140 &
To be moved by the property owner

FAS
SERIES FAS NO. 157C(1)
1941 7 84
WAITSFIELD

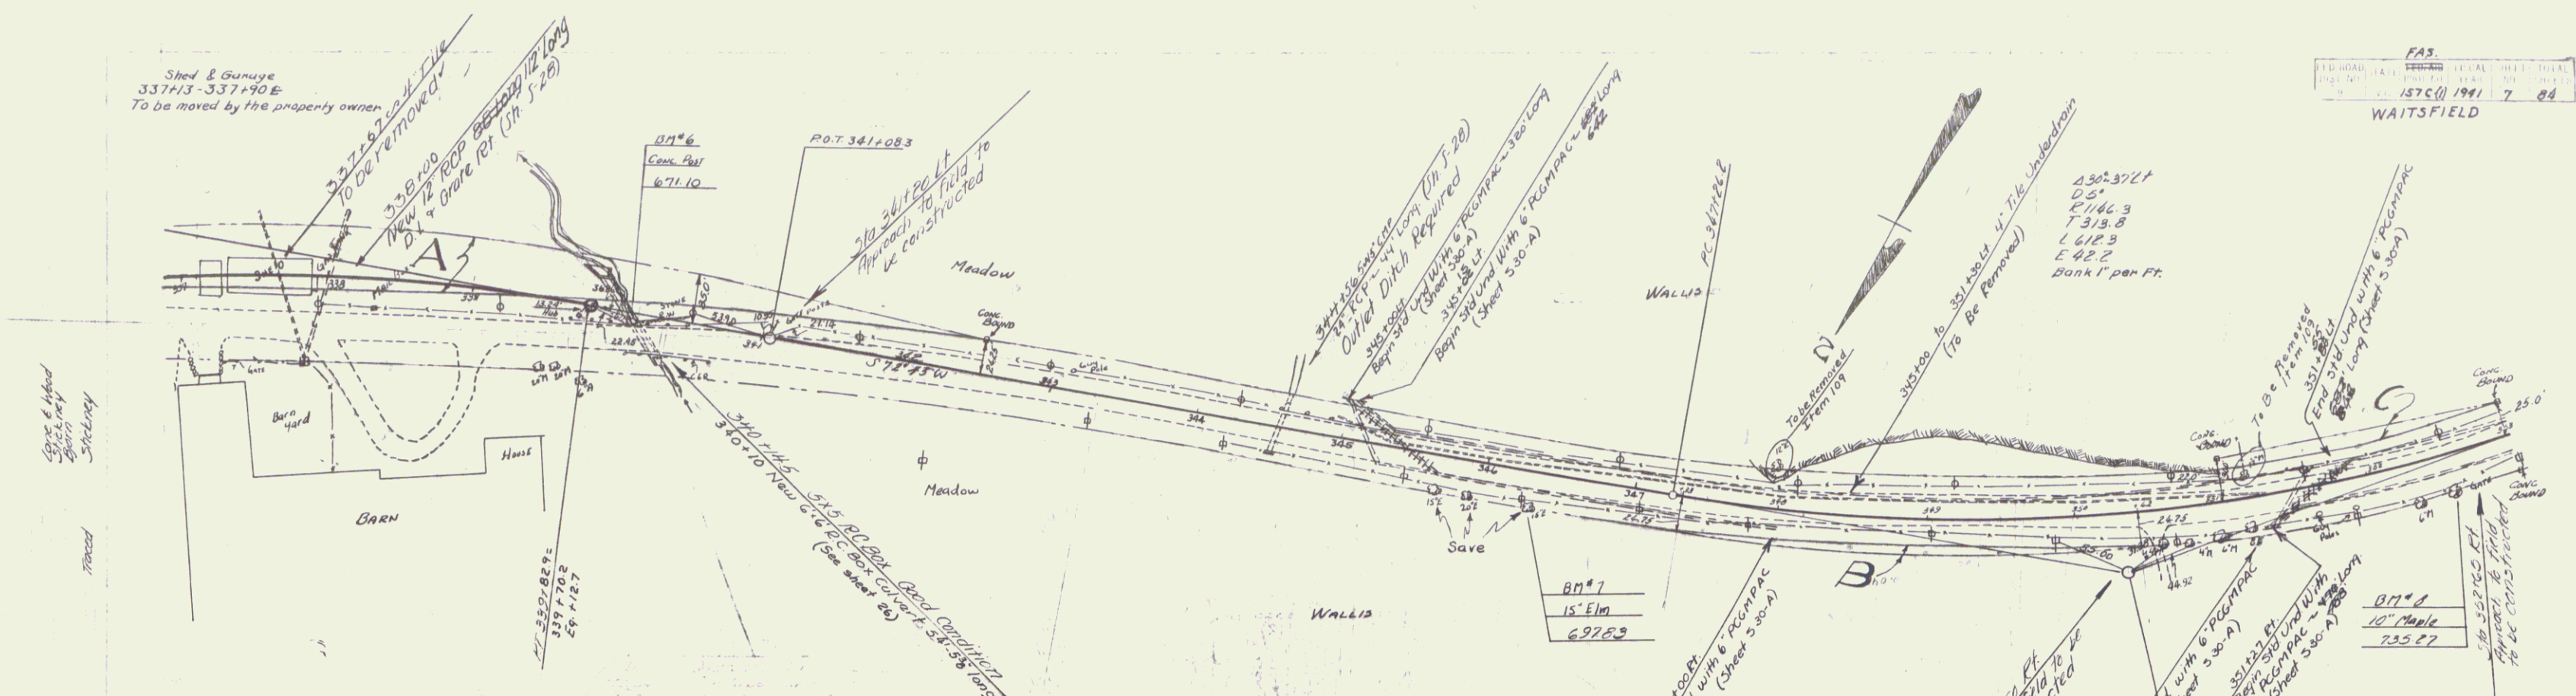

PARCEL INSTRUMENT	DATE	GRANTOR	GRANTEE	RECORDED	REMARKS
A-B-C	Q.C.D.	3-16-40	W.O. WALLIS	ST 217	WAITSFIELD DATE 234-33 3-3-40 4 C.M.

- LIST OF SHEETS (BRIDGE ONLY)
 Plan and Profile
 Details of Culvert Extension
 S.B.H. - Barricades etc.
 Cross Sections
- ESTIMATE OF QUANTITIES (BRIDGE ONLY)
 15 Channel Excavation 75-cy 85
 16 Structure Excavation 85-cy 86
 44-cy 60.3
 81-cy 185 81.23

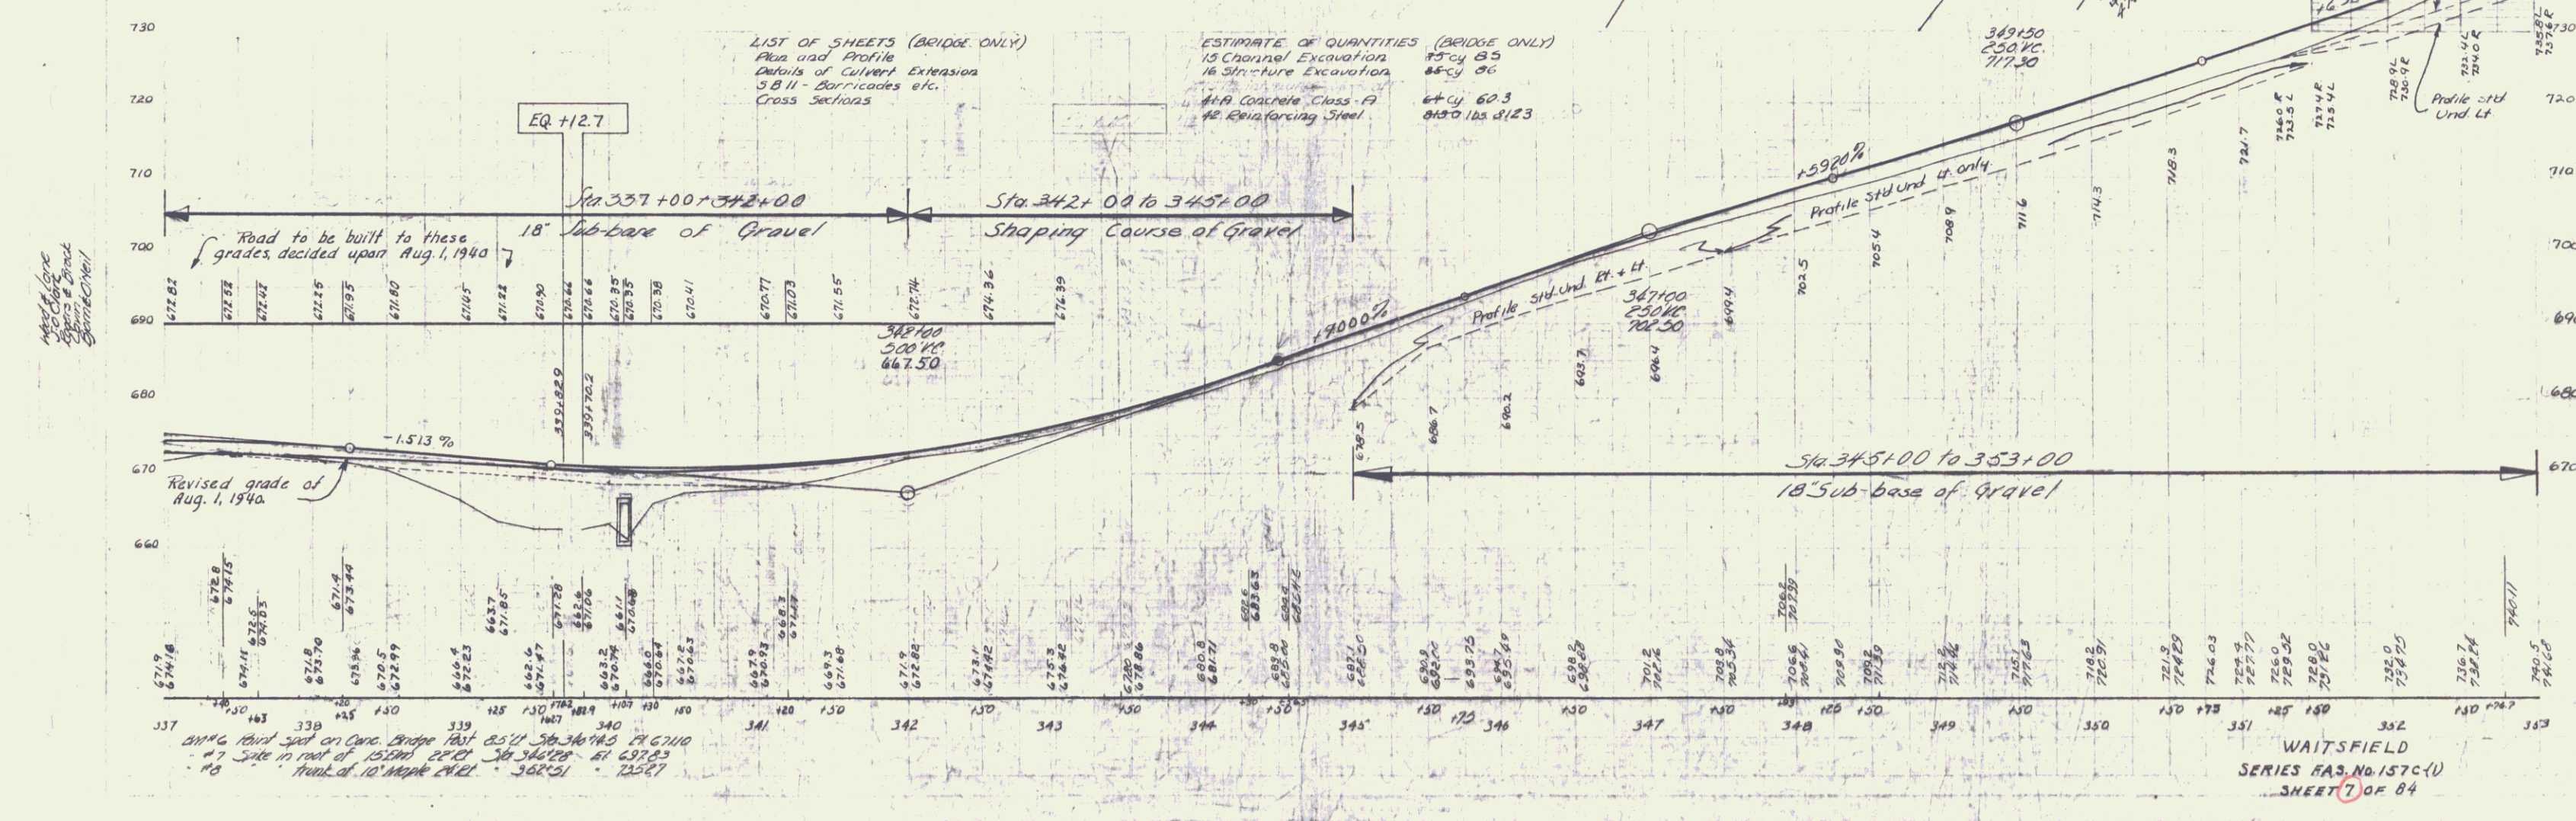

WAITSFIELD
 SERIES FAS NO. 157C(1)
 SHEET 7 OF 84