



Proposed
 Shading
 Shading

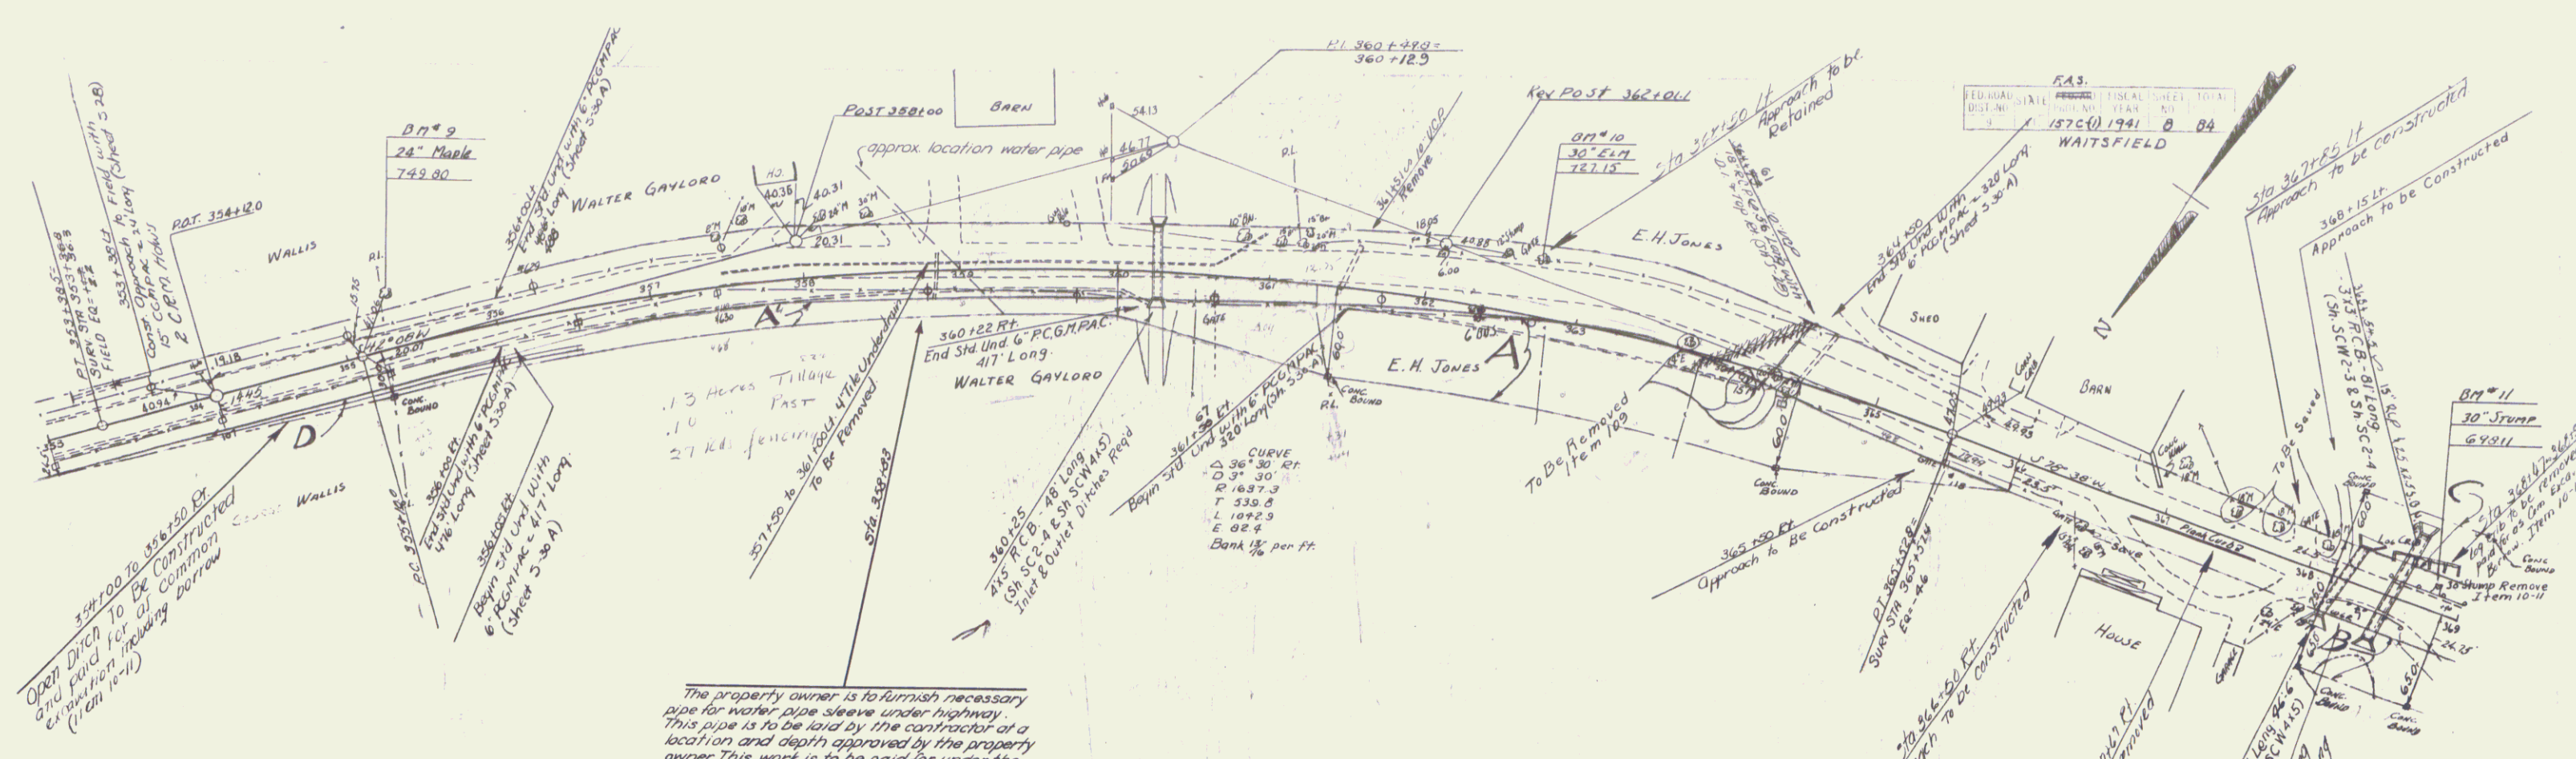

The property owner is to furnish necessary
 pipe for water pipe sleeve under highway.
 This pipe is to be laid by the contractor at a
 location and depth approved by the property
 owner. This work is to be paid for under the
 item of French Excavation or Earth Item 12A.

PARCEL INSTRUMENT	DATE	GRANTOR	GRANTEE	RECORDED WAITSFIELD	REMARKS
D	Q.C.D.	3-16-40	W.O. WALLIS	ST OF VT	17
A-B-C	Q.C.D.	3-23-40	E.H. EMERY & JONES	ST OF VT	17
A	W.D.E.	3-18-40	WALTER & GLADYS GAYLORD	ST OF VT	17

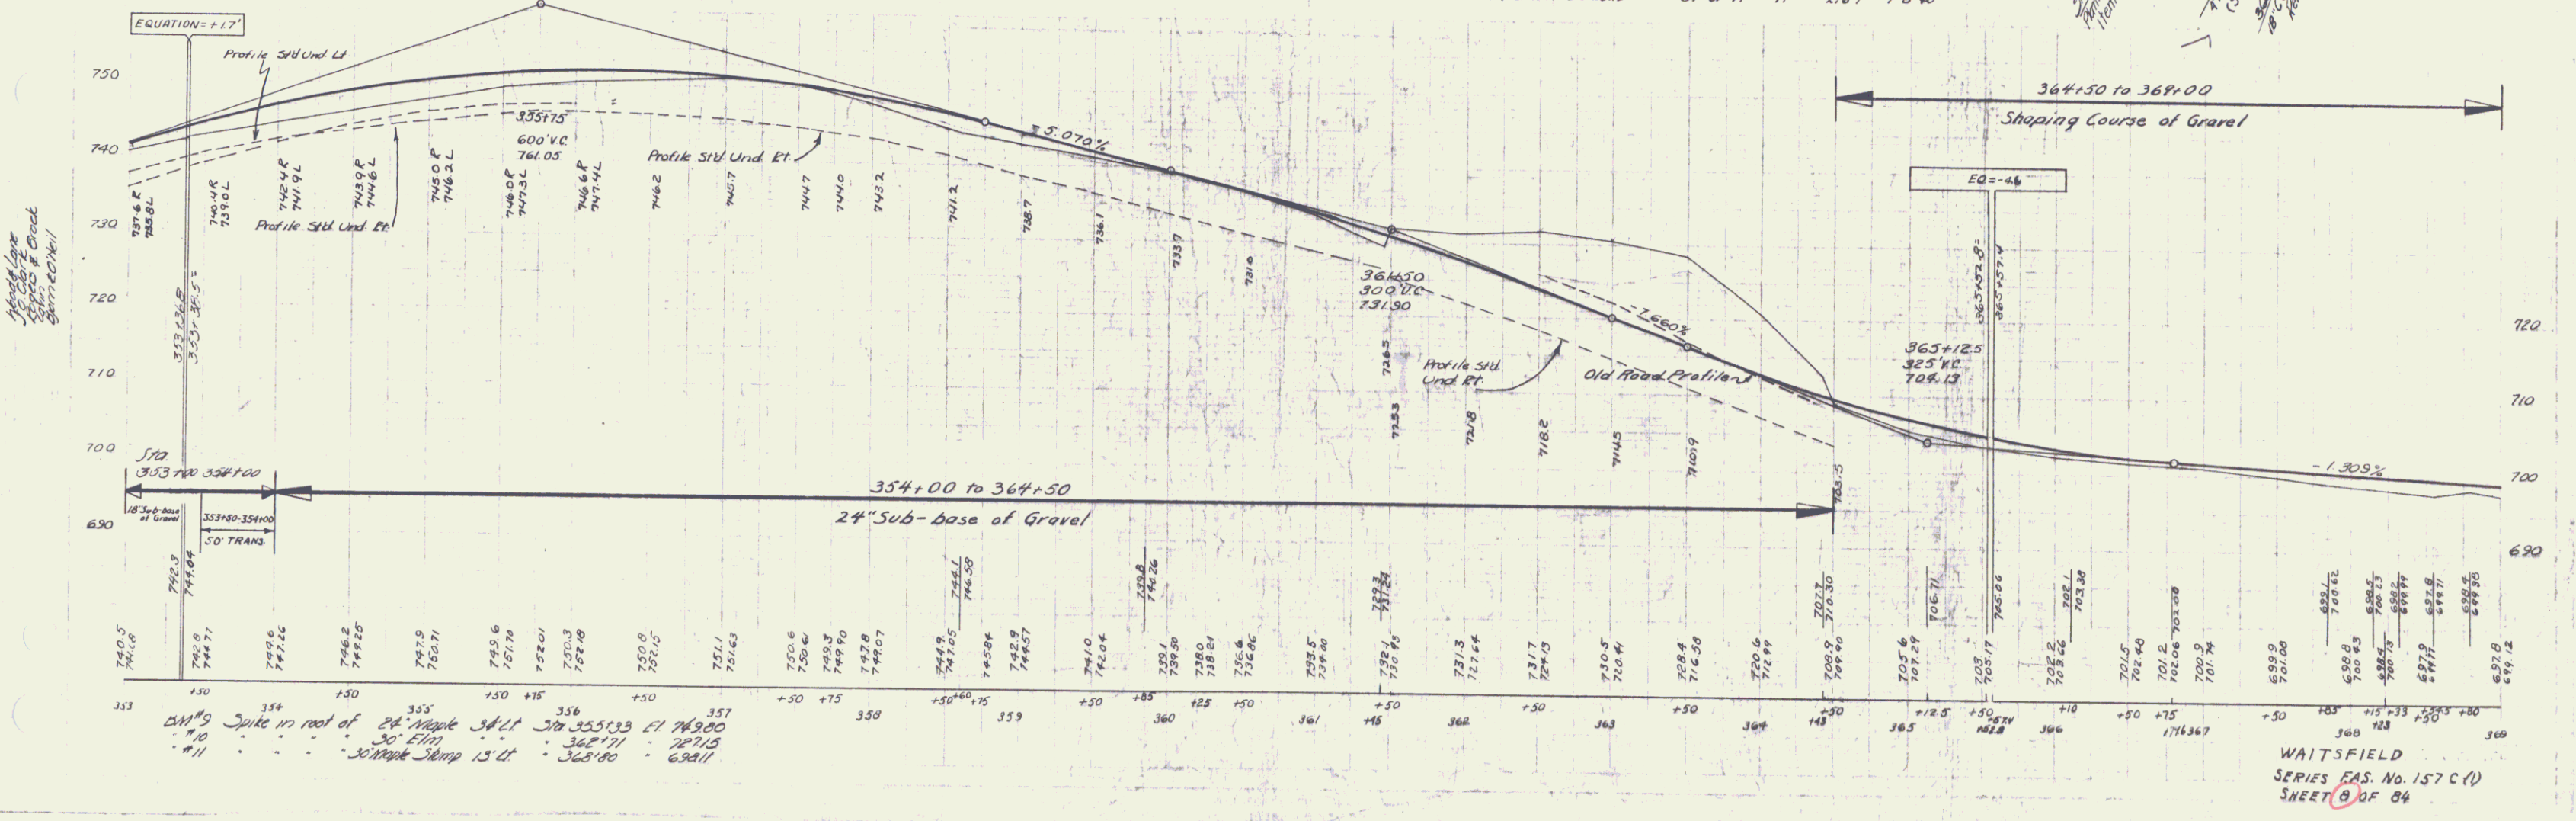

24" Sub-base of Gravel
 354+00 to 364+50
 24" Sub-base of Gravel

WAITSFIELD
 SERIES E.A.S. No. 157 C (1)
 SHEET 8 OF 84